


FILED
 Date: 12/27/2006 By: JIP
 This survey consists of:
 Map: _____
 Narrative: _____
 Corner P: _____
 DOUGLAS COUNTY
 SURVEYOR

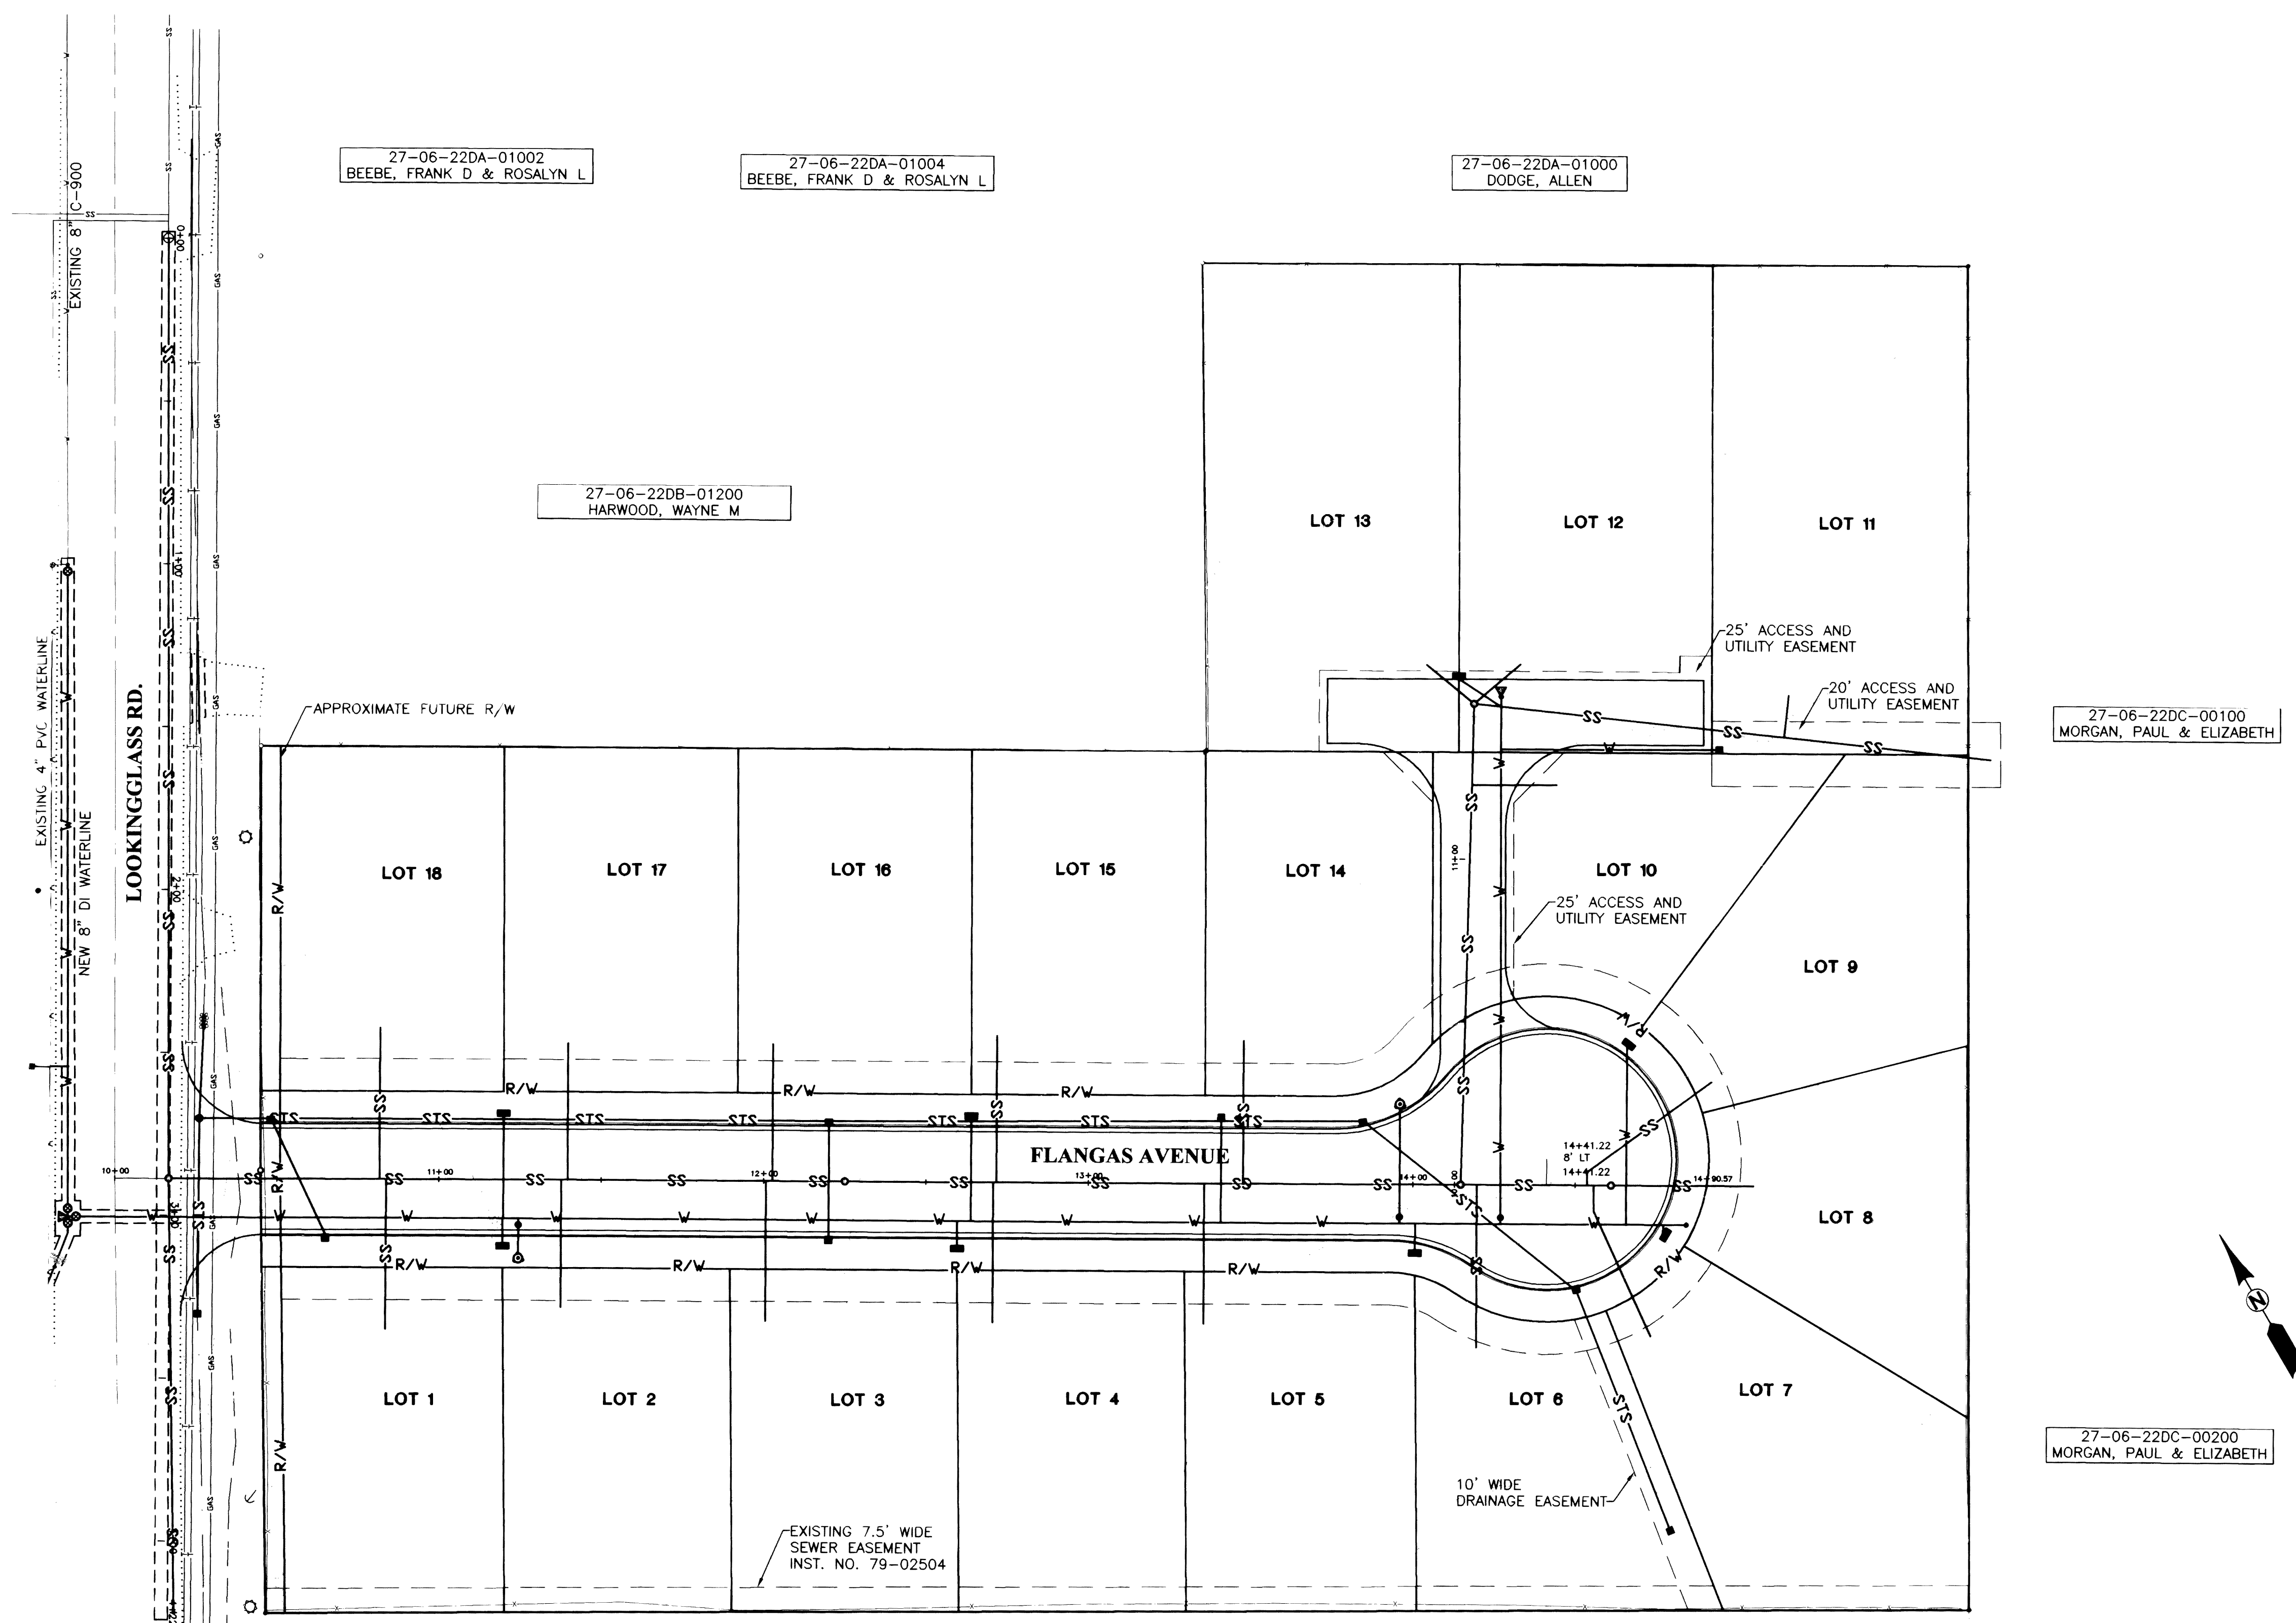

27-06-22DC-00100
 MORGAN, PAUL & ELIZABETH

27-06-22DC-00200
 MORGAN, PAUL & ELIZABETH

27-06-22DC-00500
 DILLMAN, DANIEL E & MAXINE J

CITY OF ROSEBURG
 Public Works Dept.
 Development Plan Review

Approved for Development Approved with Conditions

By _____
 Date _____


CALL BEFORE YOU DIG I
 ONE CALL: (800) 332-2344
 JAR 952-001-0010 THROUGH
 OAR 952-001-0090

i.e. ENGINEERING
 505 SE Main Street
 Roseburg, Oregon 97470
 PHONE (541) 673-0166
 FAX (541) 440-9392
 jemail@ieengineering.com

Project Name:
RED HAWK ESTATES
 (LOOKINGGLASS RD. SUBDIVISION)

Title:
OVERALL
w/EXISTING CONTOURS

DES	JPM	PROJECT NO. 0333-16
DWG	BWC	DATE: NOVEMBER 29, 2004
CHK	SNL	SCALE: AS SHOWN
APP	SNL	SHEET: 2 OF 8

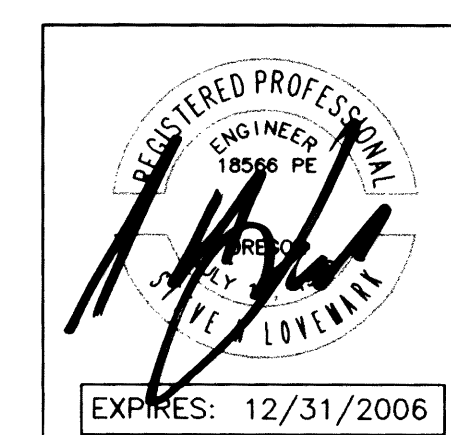

Rev.	Date	Dwg	Description
1	1/24/05	ANV	AGENCY REVIEW
2	08/16/05	JDL	AS-BUILTS

Co. Rd. # 910

MP 0.00 - 0.08

CO. RD. #910 OVERALL

DO NOT DUPLICATE

00000008