


FILED
 Date: 11/29/2006 P.V. J.P.
 This survey consists of:
 Map: _____
 Narrative: _____
 Corner P.I.: _____
 DOUGLAS COUNTY
 SURVEYOR

CITY OF ROSEBURG
 Public Works Dept.
 Development Plan Review

Approved for Development Approved with Conditions

By: _____
 Date: _____

CALL BEFORE YOU DIG!
 ONE CALL: (800) 332-2344
 OAR 952-001-0010 THROUGH
 OAR 952-001-0090

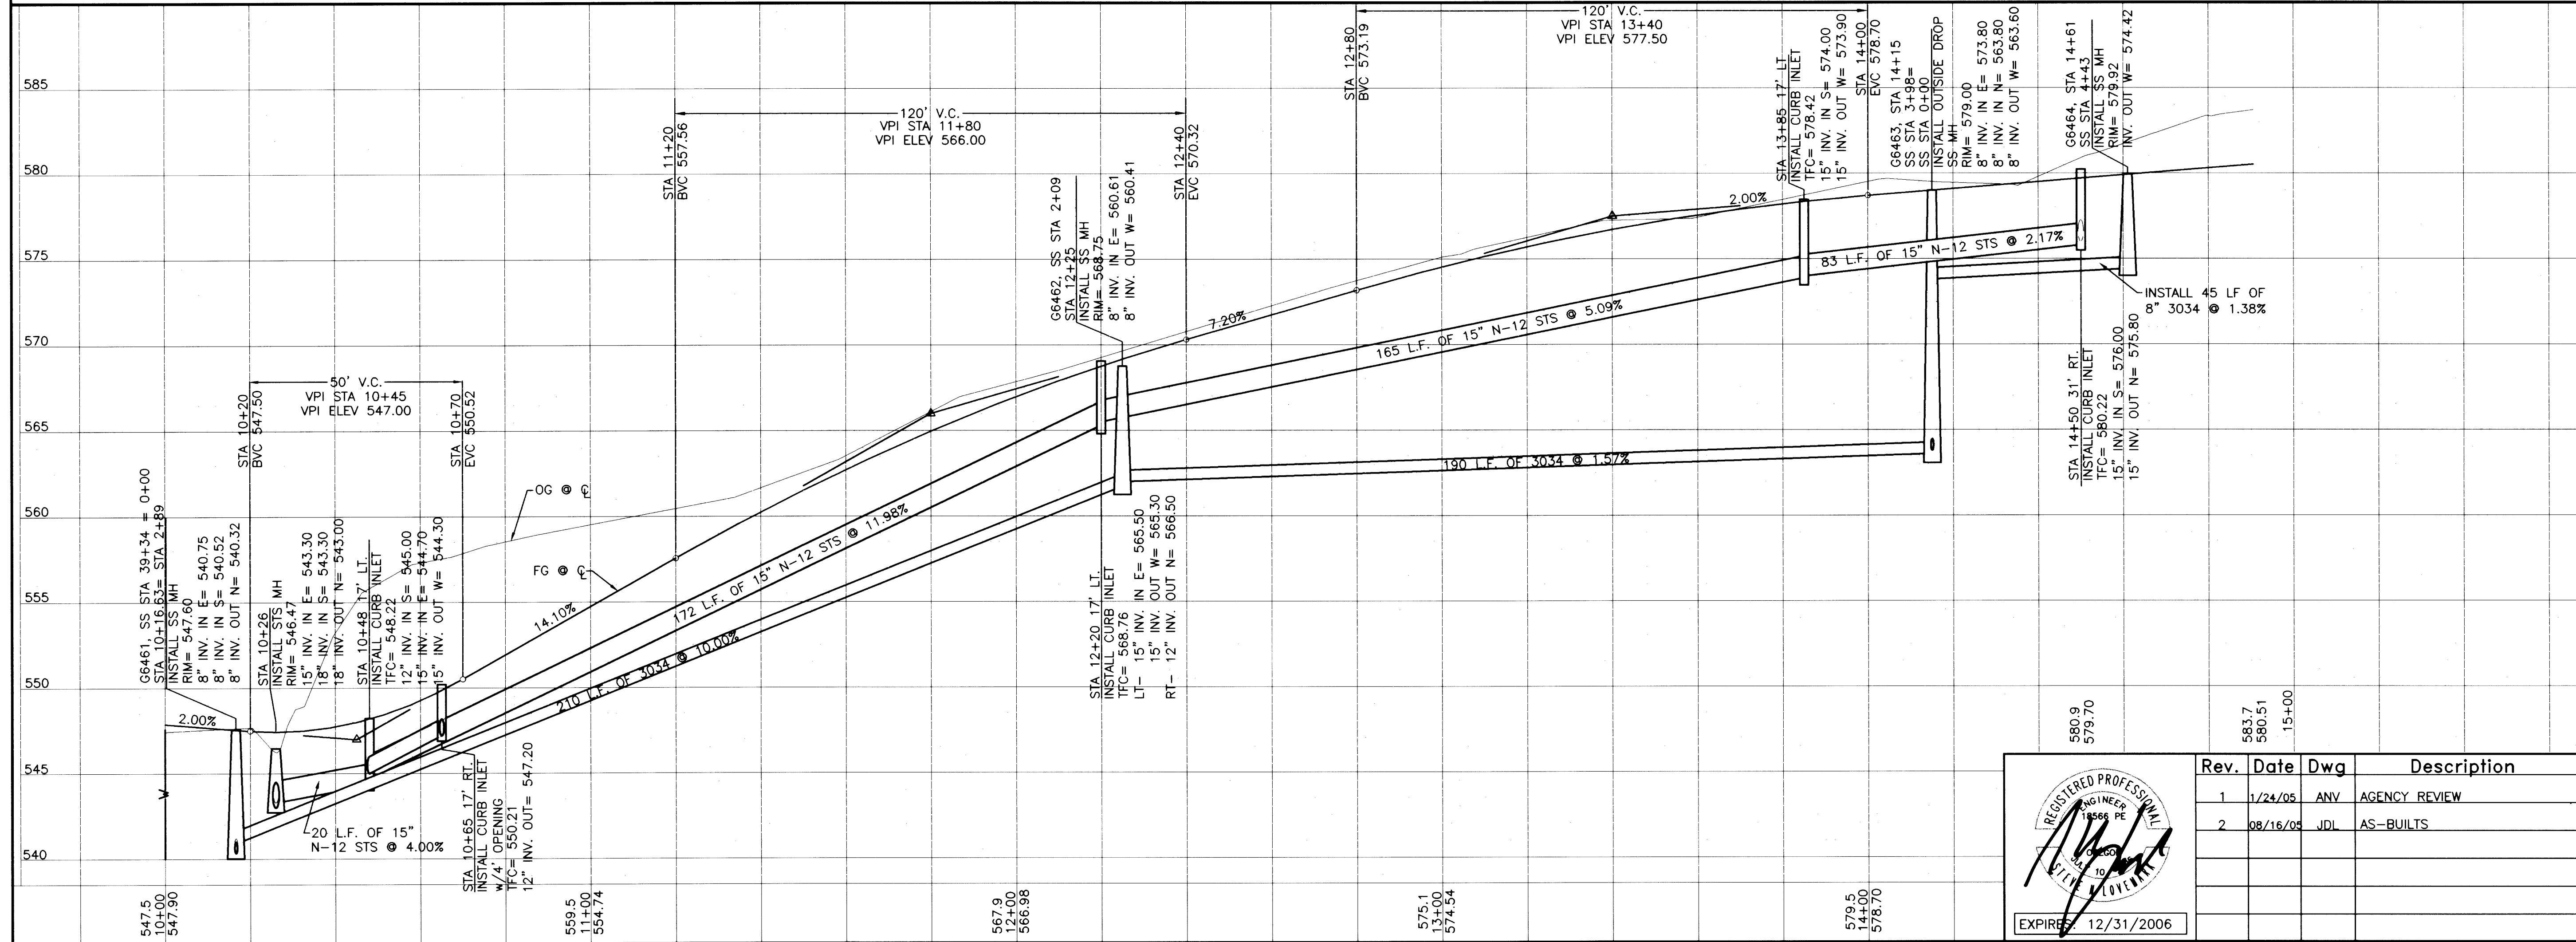


i.e.
 ENGINEERING
 505 SE Main Street
 Roseburg, Oregon 97470
 PHONE (541) 673-0166
 FAX (541) 440-9392
 iemai@ieengineering.com

Project Name:
RED HAWK ESTATES
 (LOOKINGGLASS RD. SUBDIVISION)

Title:
FLANGAS AVENUE
PLAN AND PROFILE

DES -JPM PROJECT NO. 0333-16
 DWG -BWC DATE: NOVEMBER 29, 2004
 CHK -SNL SCALE: HORIZ. 1" = 20'
 APP -SNL SHEET: 4 OF 8

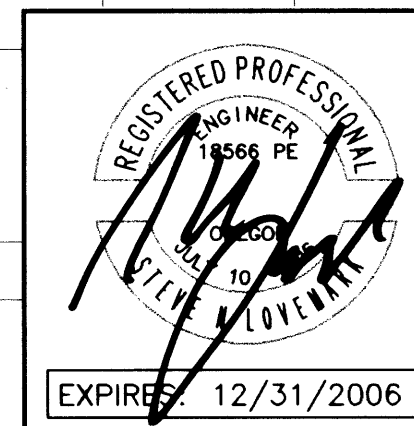

Rev.	Date	Dwg	Description
1	1/24/05	ANV	AGENCY REVIEW
2	08/16/05	JDL	AS-BUILTS

Co. Rd. # 910

CO. RD. #910 PLAN & PROFILE

R910PLAN

DO NOT DUPLICATE