


FILED
 Date: 12/27/2006 By: JP
 This survey consists of:
 Map:
 Narrative:
 Corner Pp:
 DOUGLAS COUNTY
 SURVEYOR

OWNER:
STULL ENTERPRISES
BTS ENGINEERING & SURVEYING, INC.
 4135 E. MAIN ST. SUITE 100
 PHOENIX, AZ 85016
 PHONE (414) 675-0606 FAX (414) 675-0105

PROJECT:
GENTRY ESTATES
 SHEET TITLE:
GENTRY LOOP CROSS SECTIONS

DATE: AUGUST 10, 2005
 REV #1: SEPT. 1, 2005
 REV #2:
 REV #3:
 REV #4:
 REV #5:

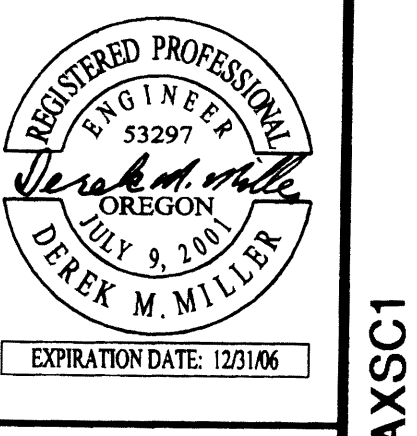

PROJ. #05-036
 SHEET NO.
ST3 of 6

AS-BUILT PLANS - 3/8/06

Co. Rd. 911A
CO. RD. #911A CROSS SECTIONS

911AXSC1