


FILED
 Date: 12/27/2006 By: J.P.
 This survey consists of:
 Map:
 Narrative:
 Corner RPT:
 DOUGLAS COUNTY
 SURVEYOR

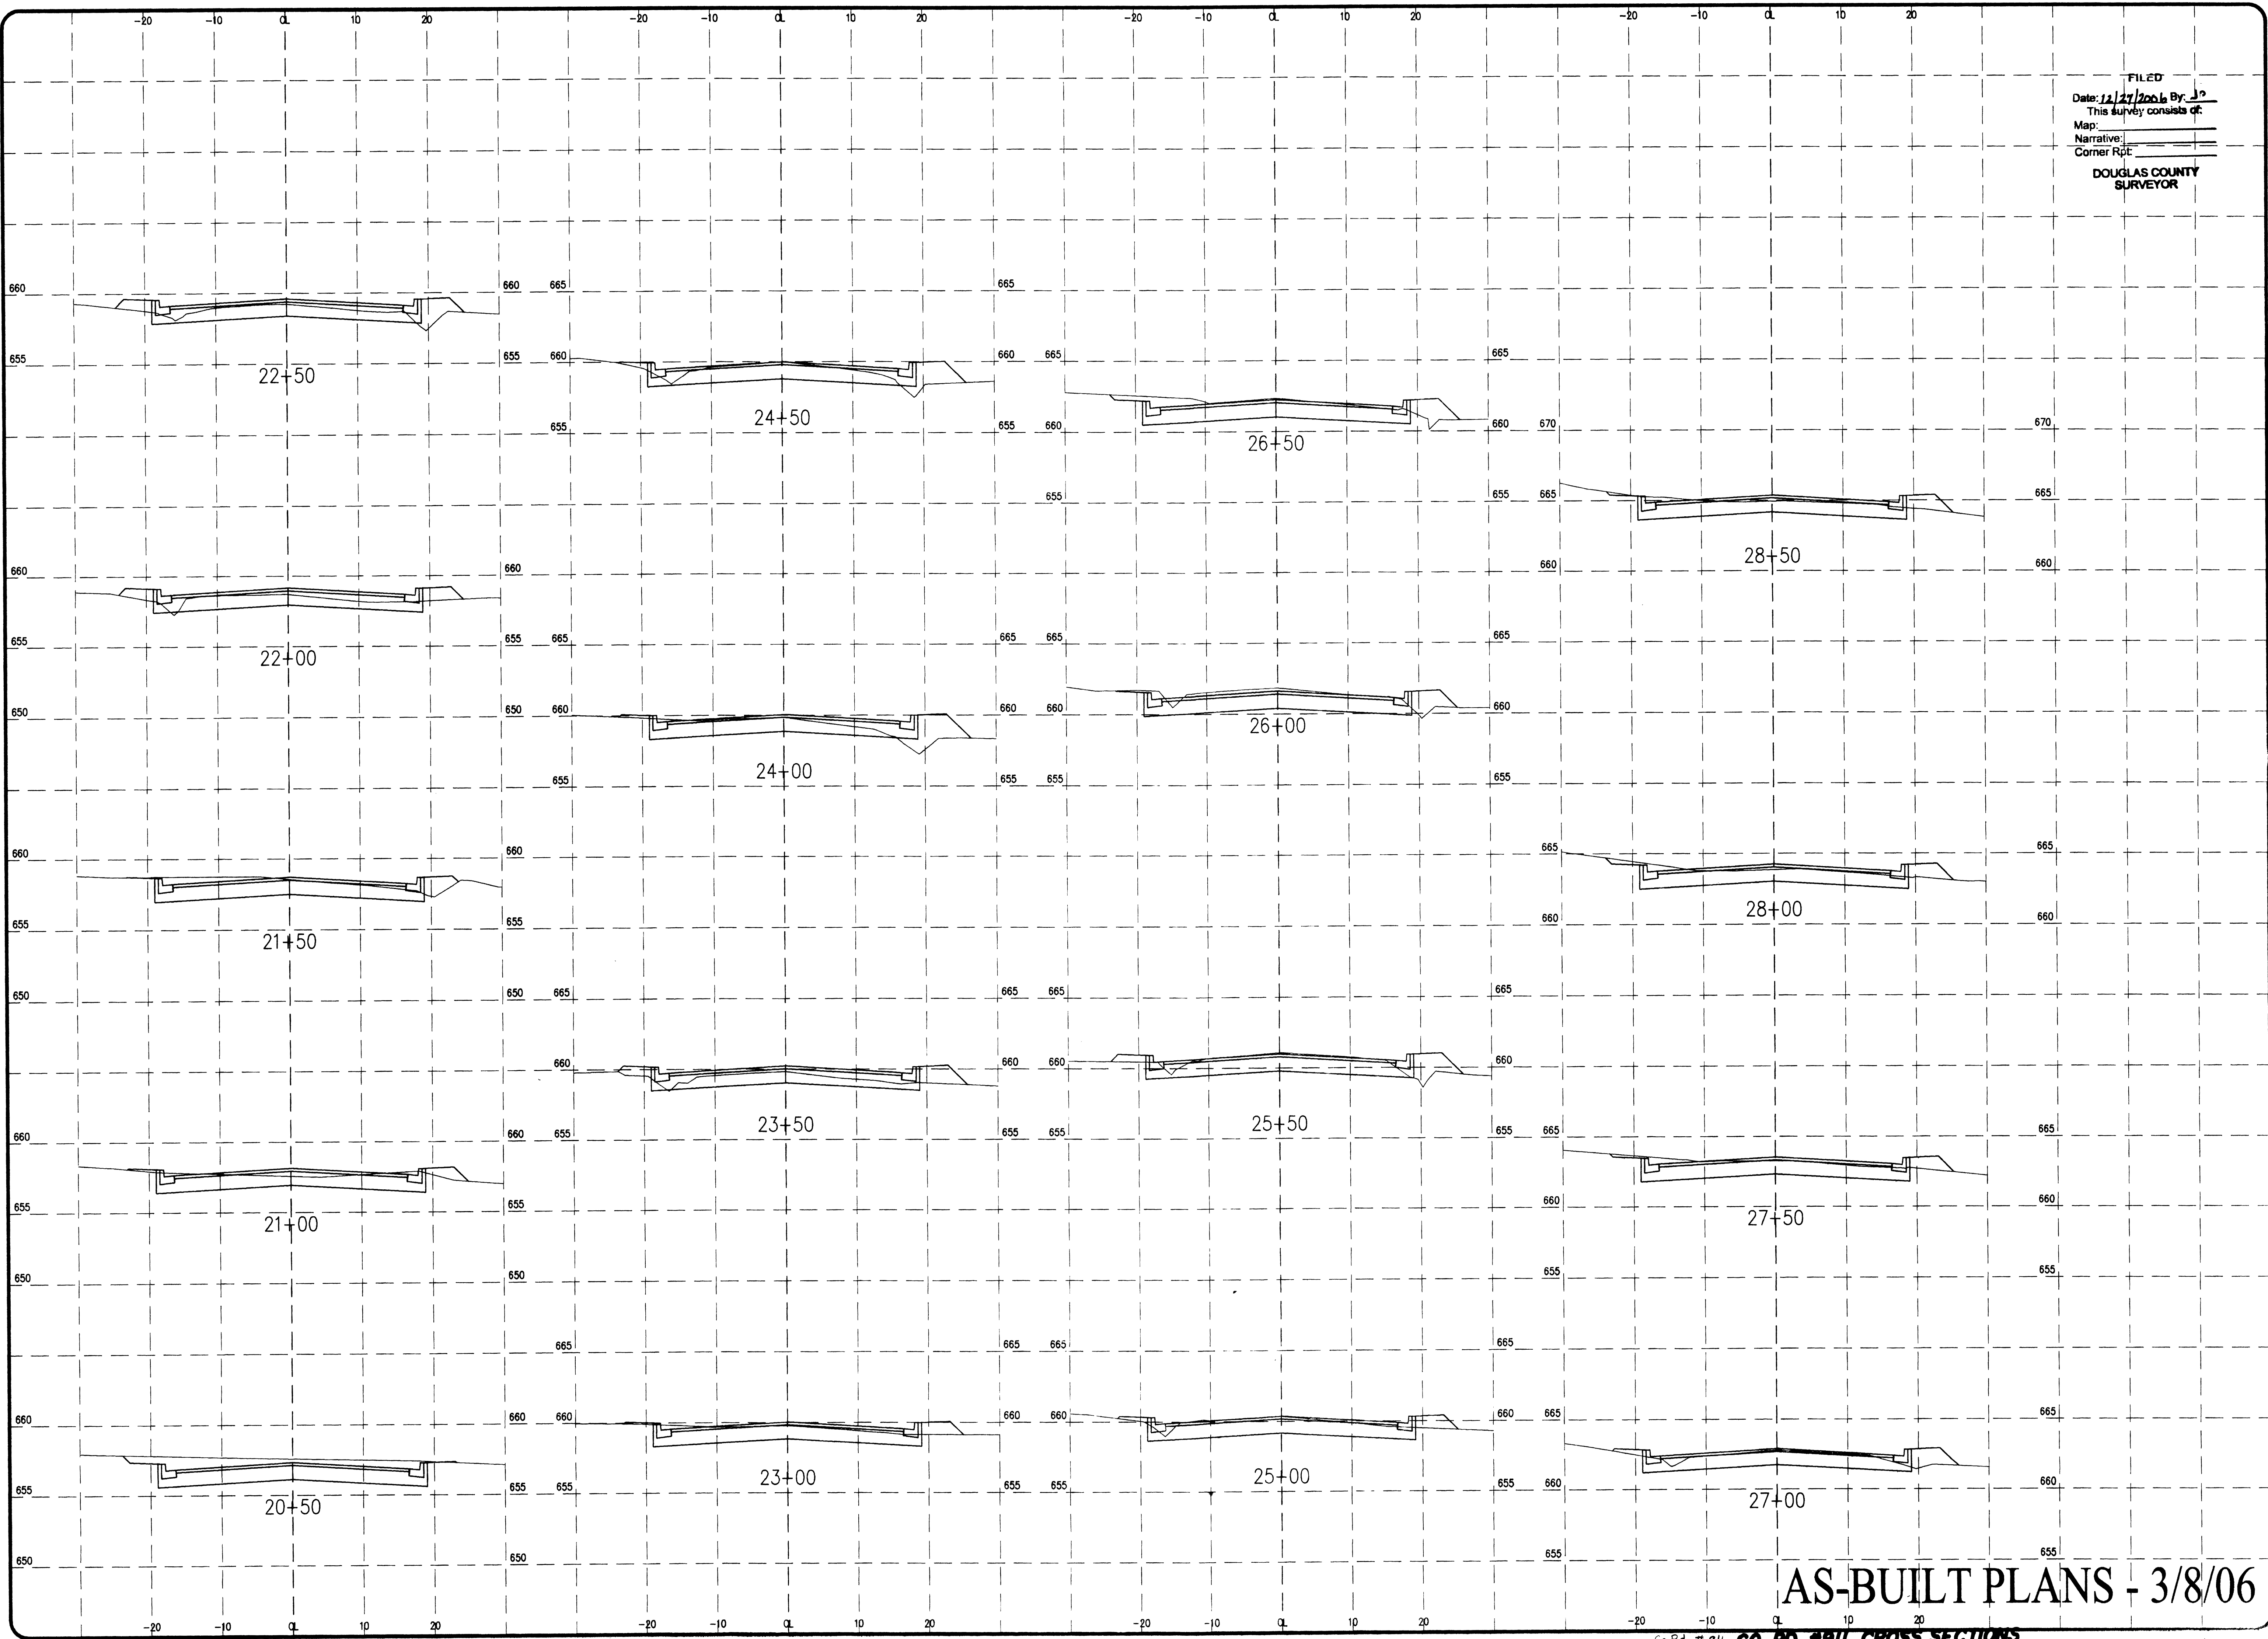

AS-BUILT PLANS - 3/8/06

Co. Rd. # 911 CO. RD. #911 CROSS SECTIONS

OWNER:
 TERPRISES

PROJECT:
 GENTRY FC
 WEAVER LN CROSS SECTION

DATE	BY	REVISION



PROJECT:
 S

011XSFT