



FILED
 Date: 11/27/2006 By: JP
 This survey consists of:
 Map:
 Narrative:
 Corner F.p.t.:
 DOUGLAS COUNTY
 SURVEYOR

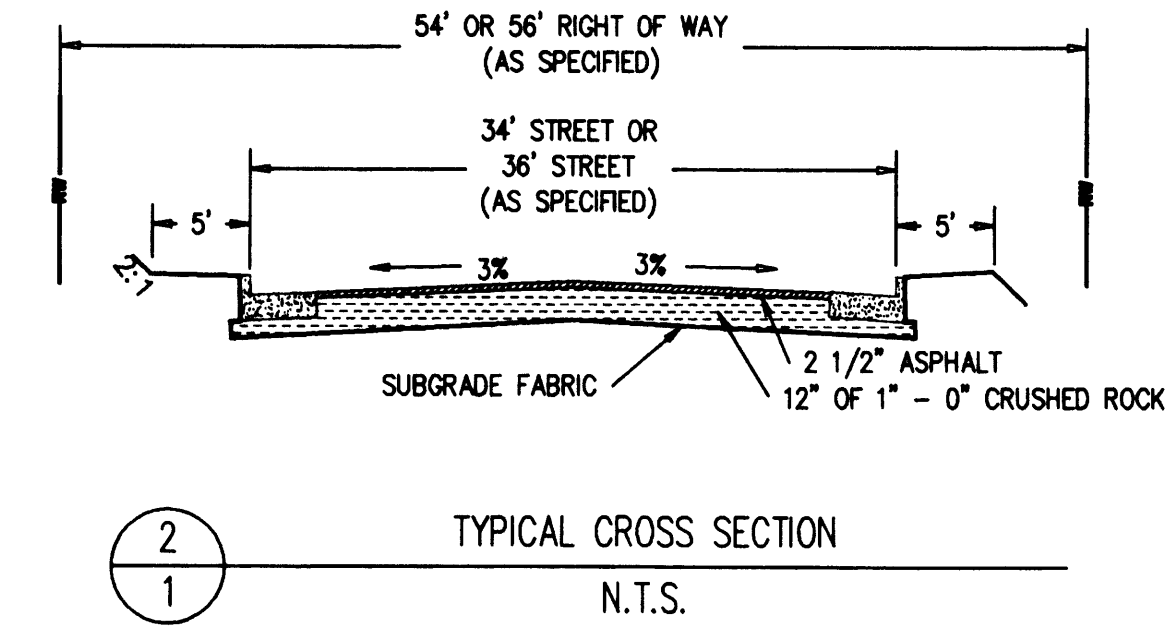

OWNER:
 STULL ENTERPRISES
 ENGINEERING & SURVEYING, INC.
 1000 N. GENTRY LOOP
 PHOENIX, AZ 85016
 PHONE (602) 998-7444 FAX (602) 998-7405


PROJECT:
 GENTRY ESTATES
 GENTRY LOOP PLAN & PROFILE

DATE: AUGUST 10, 2005
 REV. #1: SEPT. 1, 2005
 REV. #2: SEPT. 2, 2005
 REV. #3:
 REV. #4:
 REV. #5:

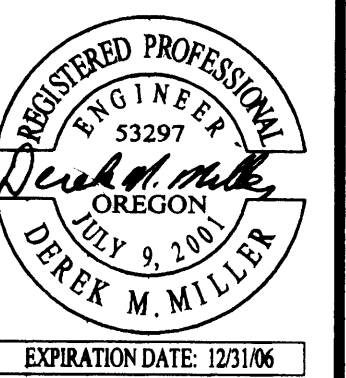

PROJ. #05-036
 SHEET NO.

ST1 of 6

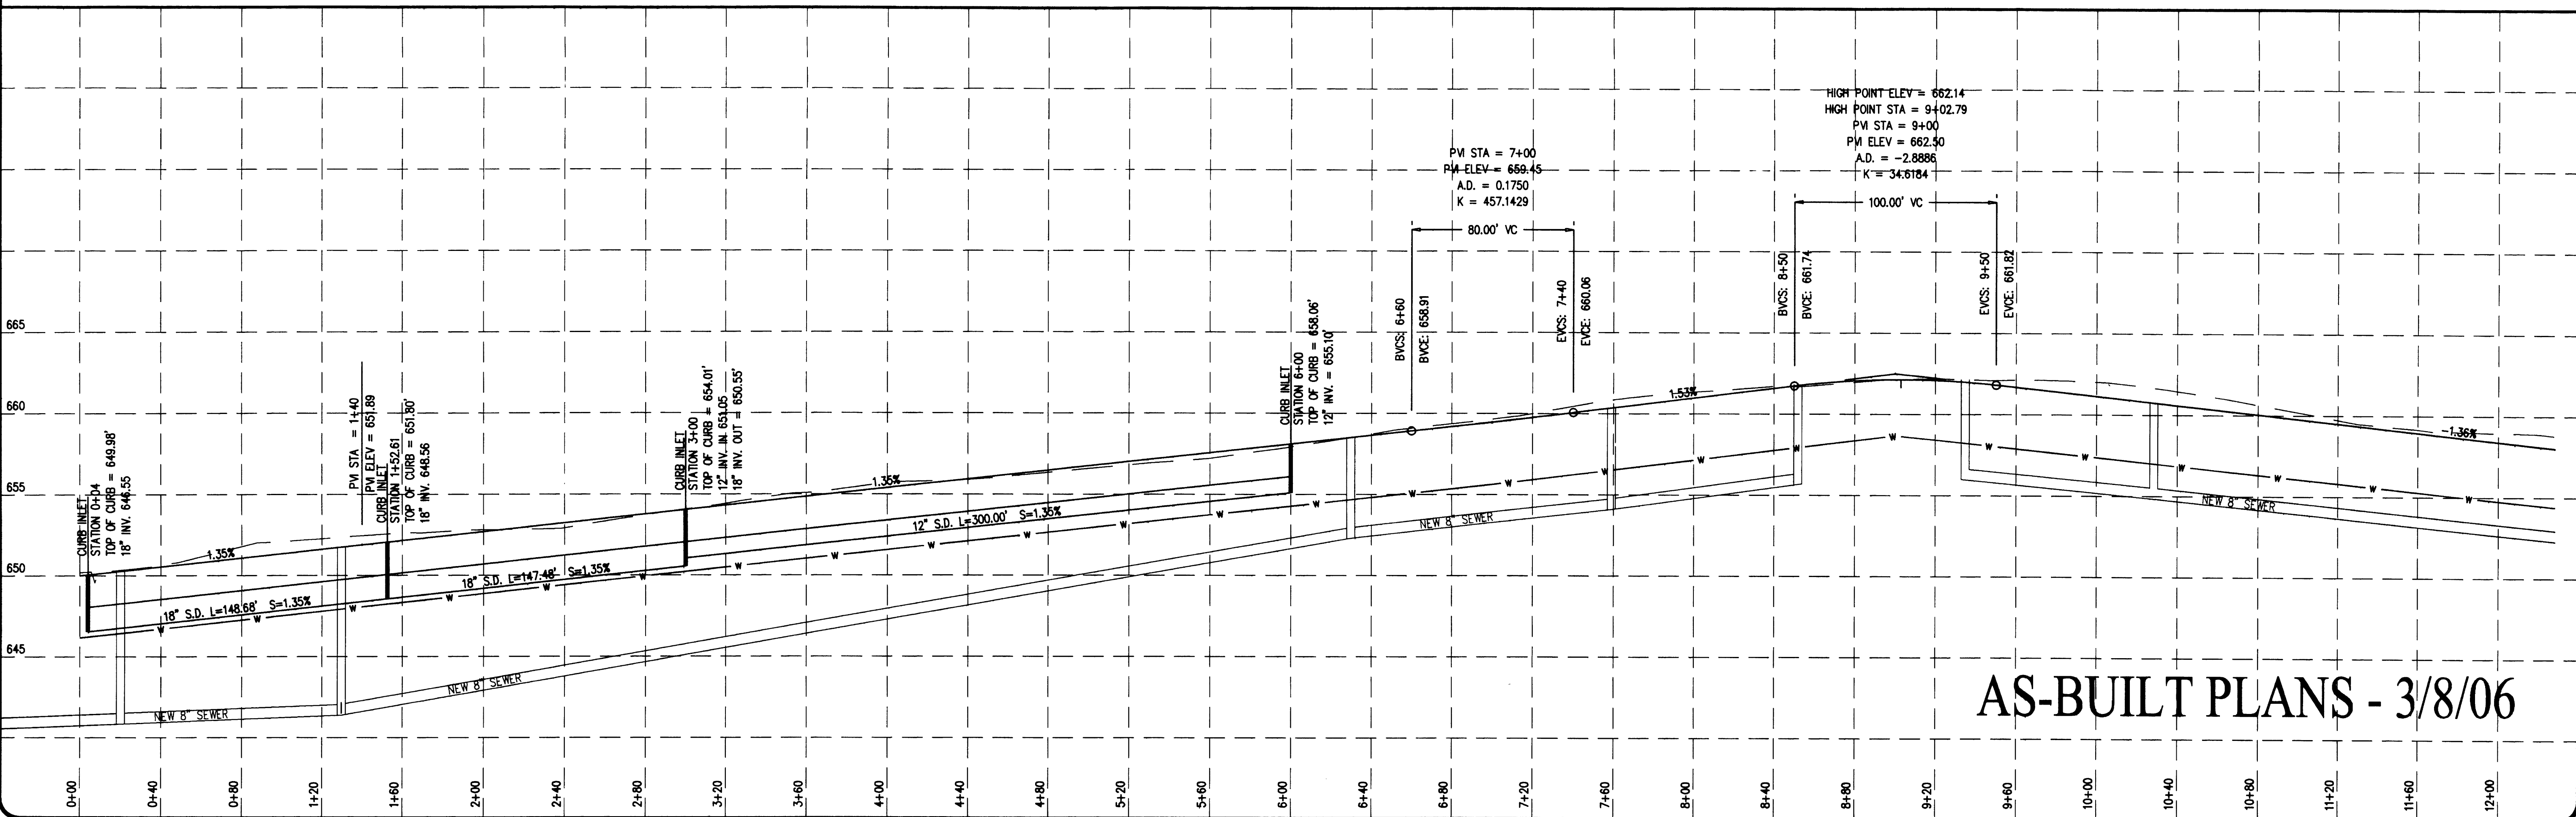

AS-BUILT PLANS - 3/8/06

A0050030