
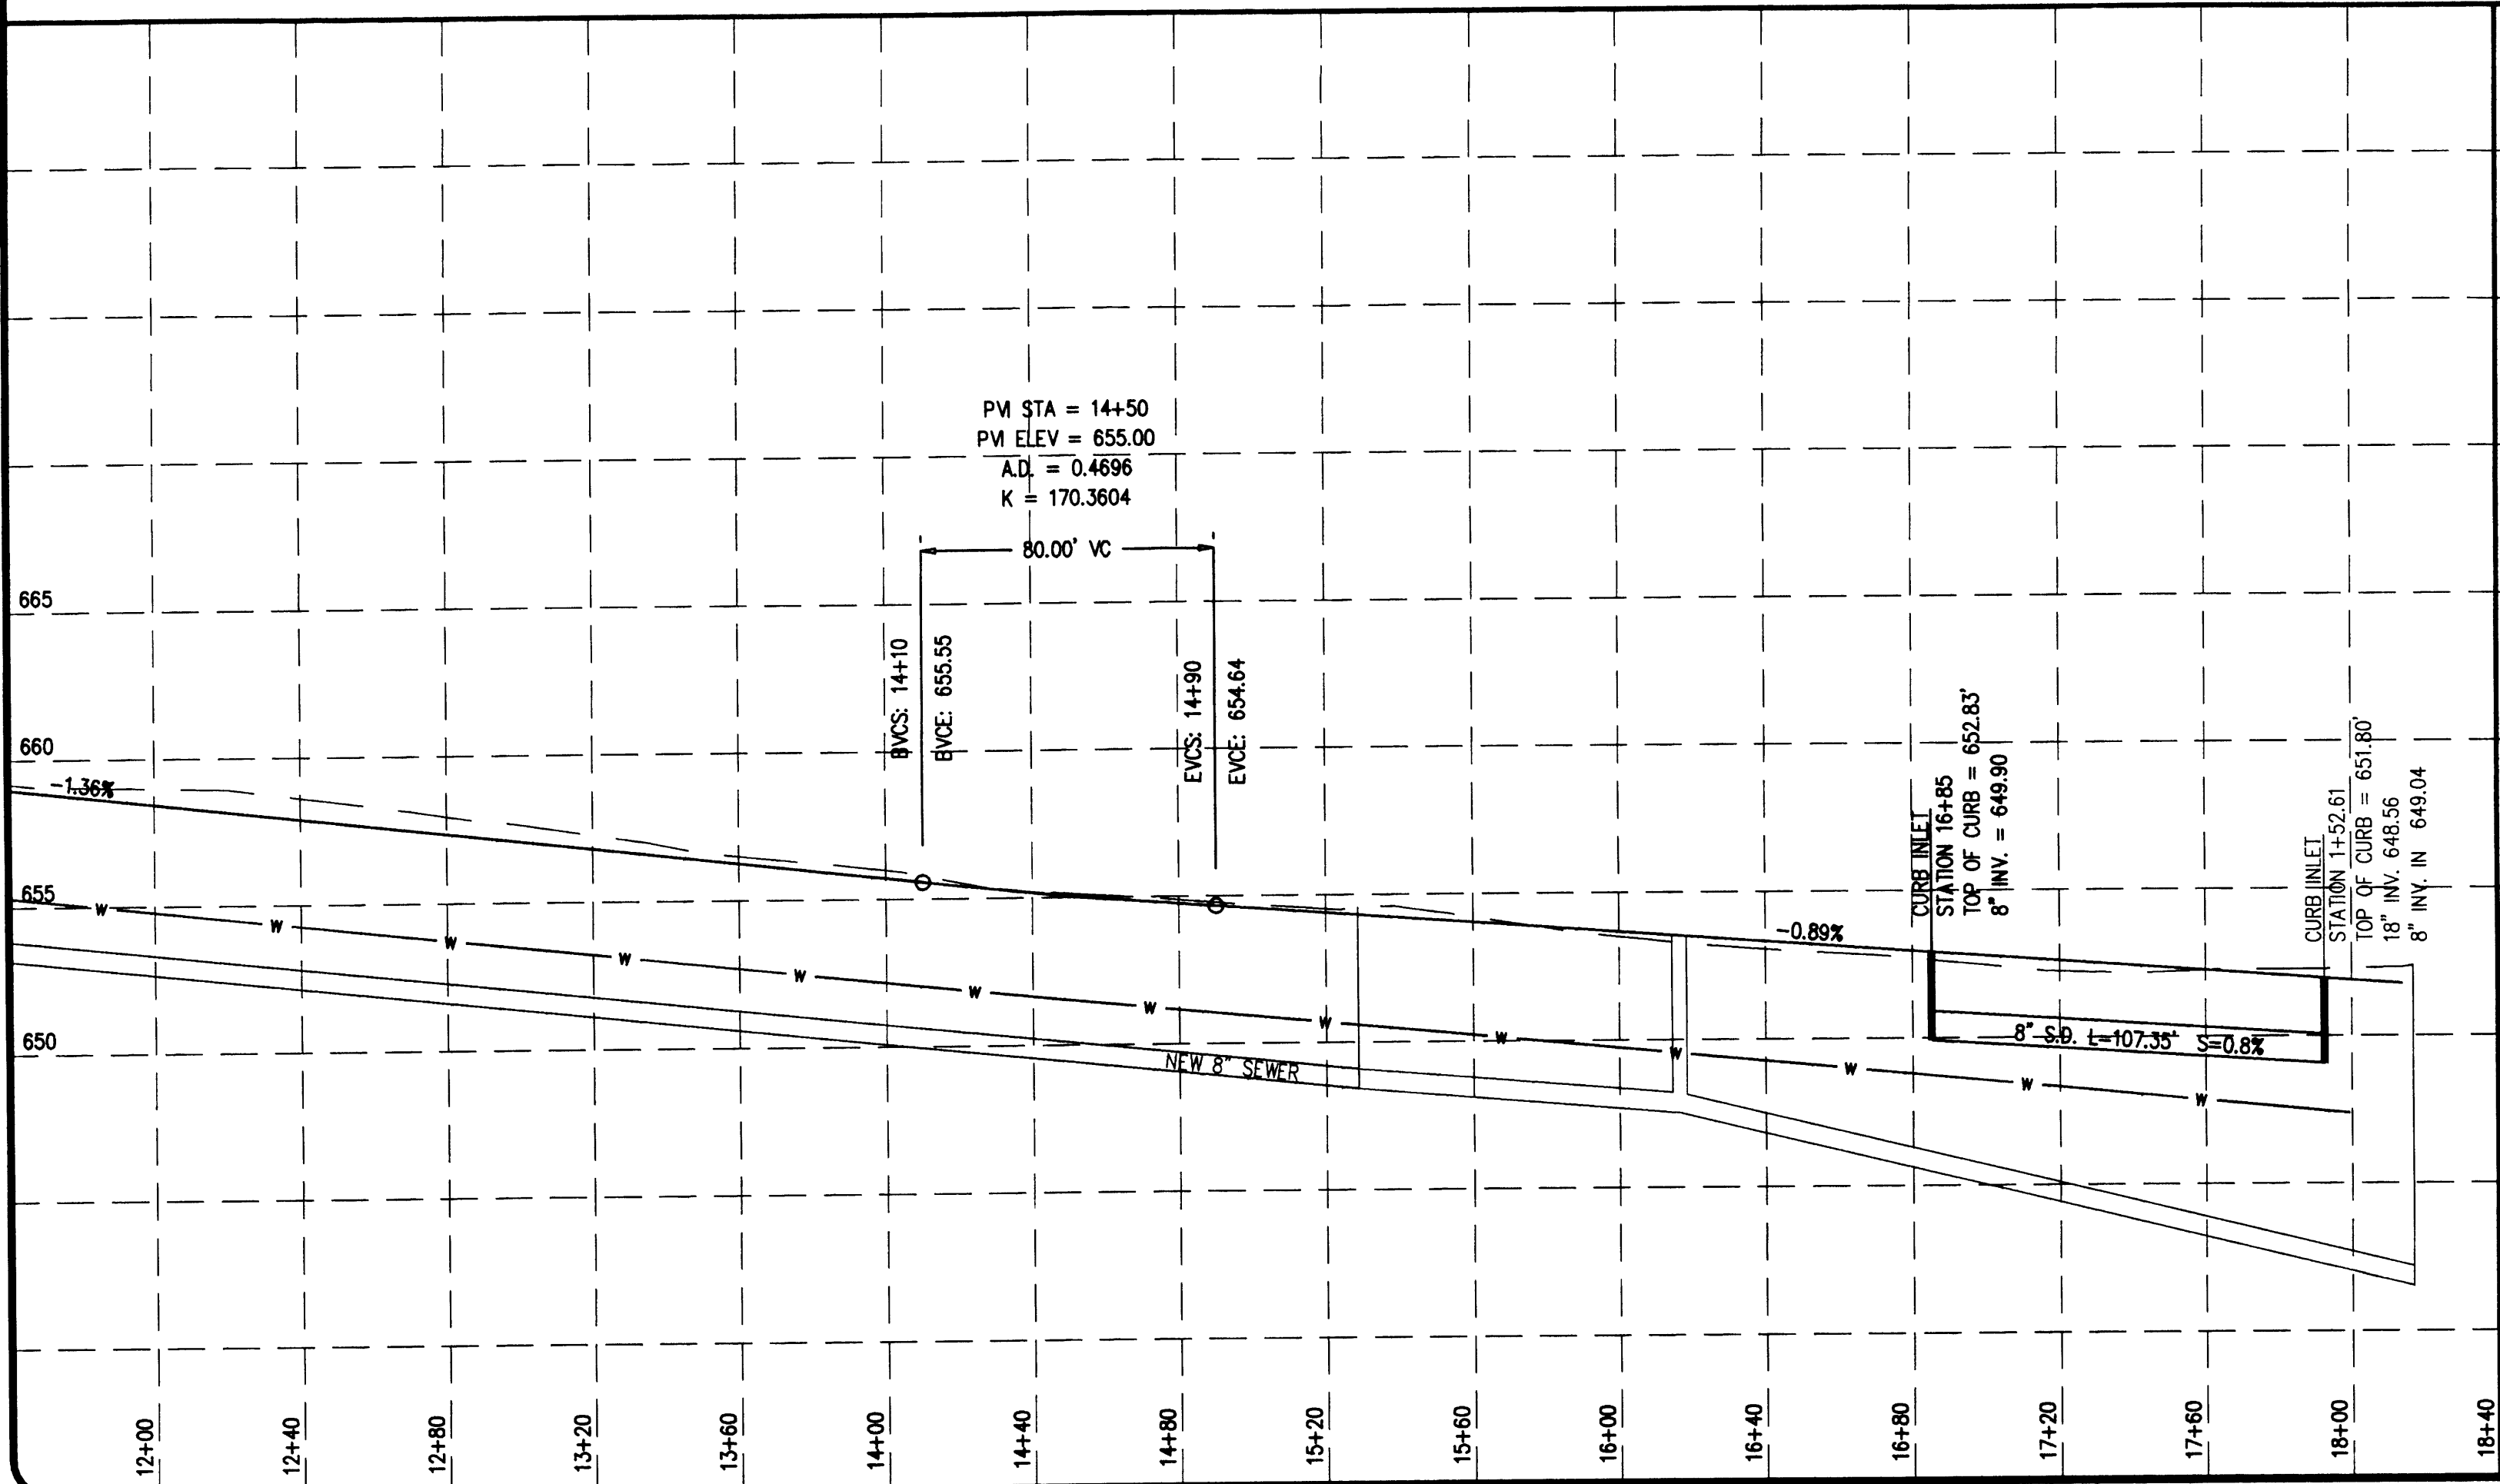
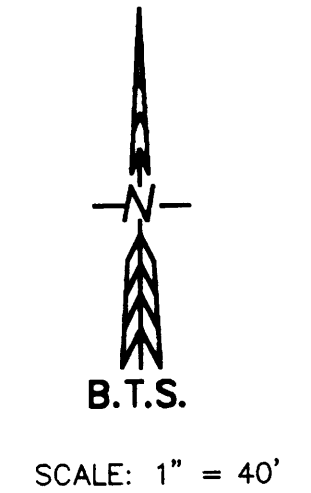


FILED
 Date: 12/17/2006 By: J.P.
 This survey consists of:
 Map: _____
 Narrative: _____
 Corner Plat: _____
 DOUGLAS COUNTY
 SURVEYOR

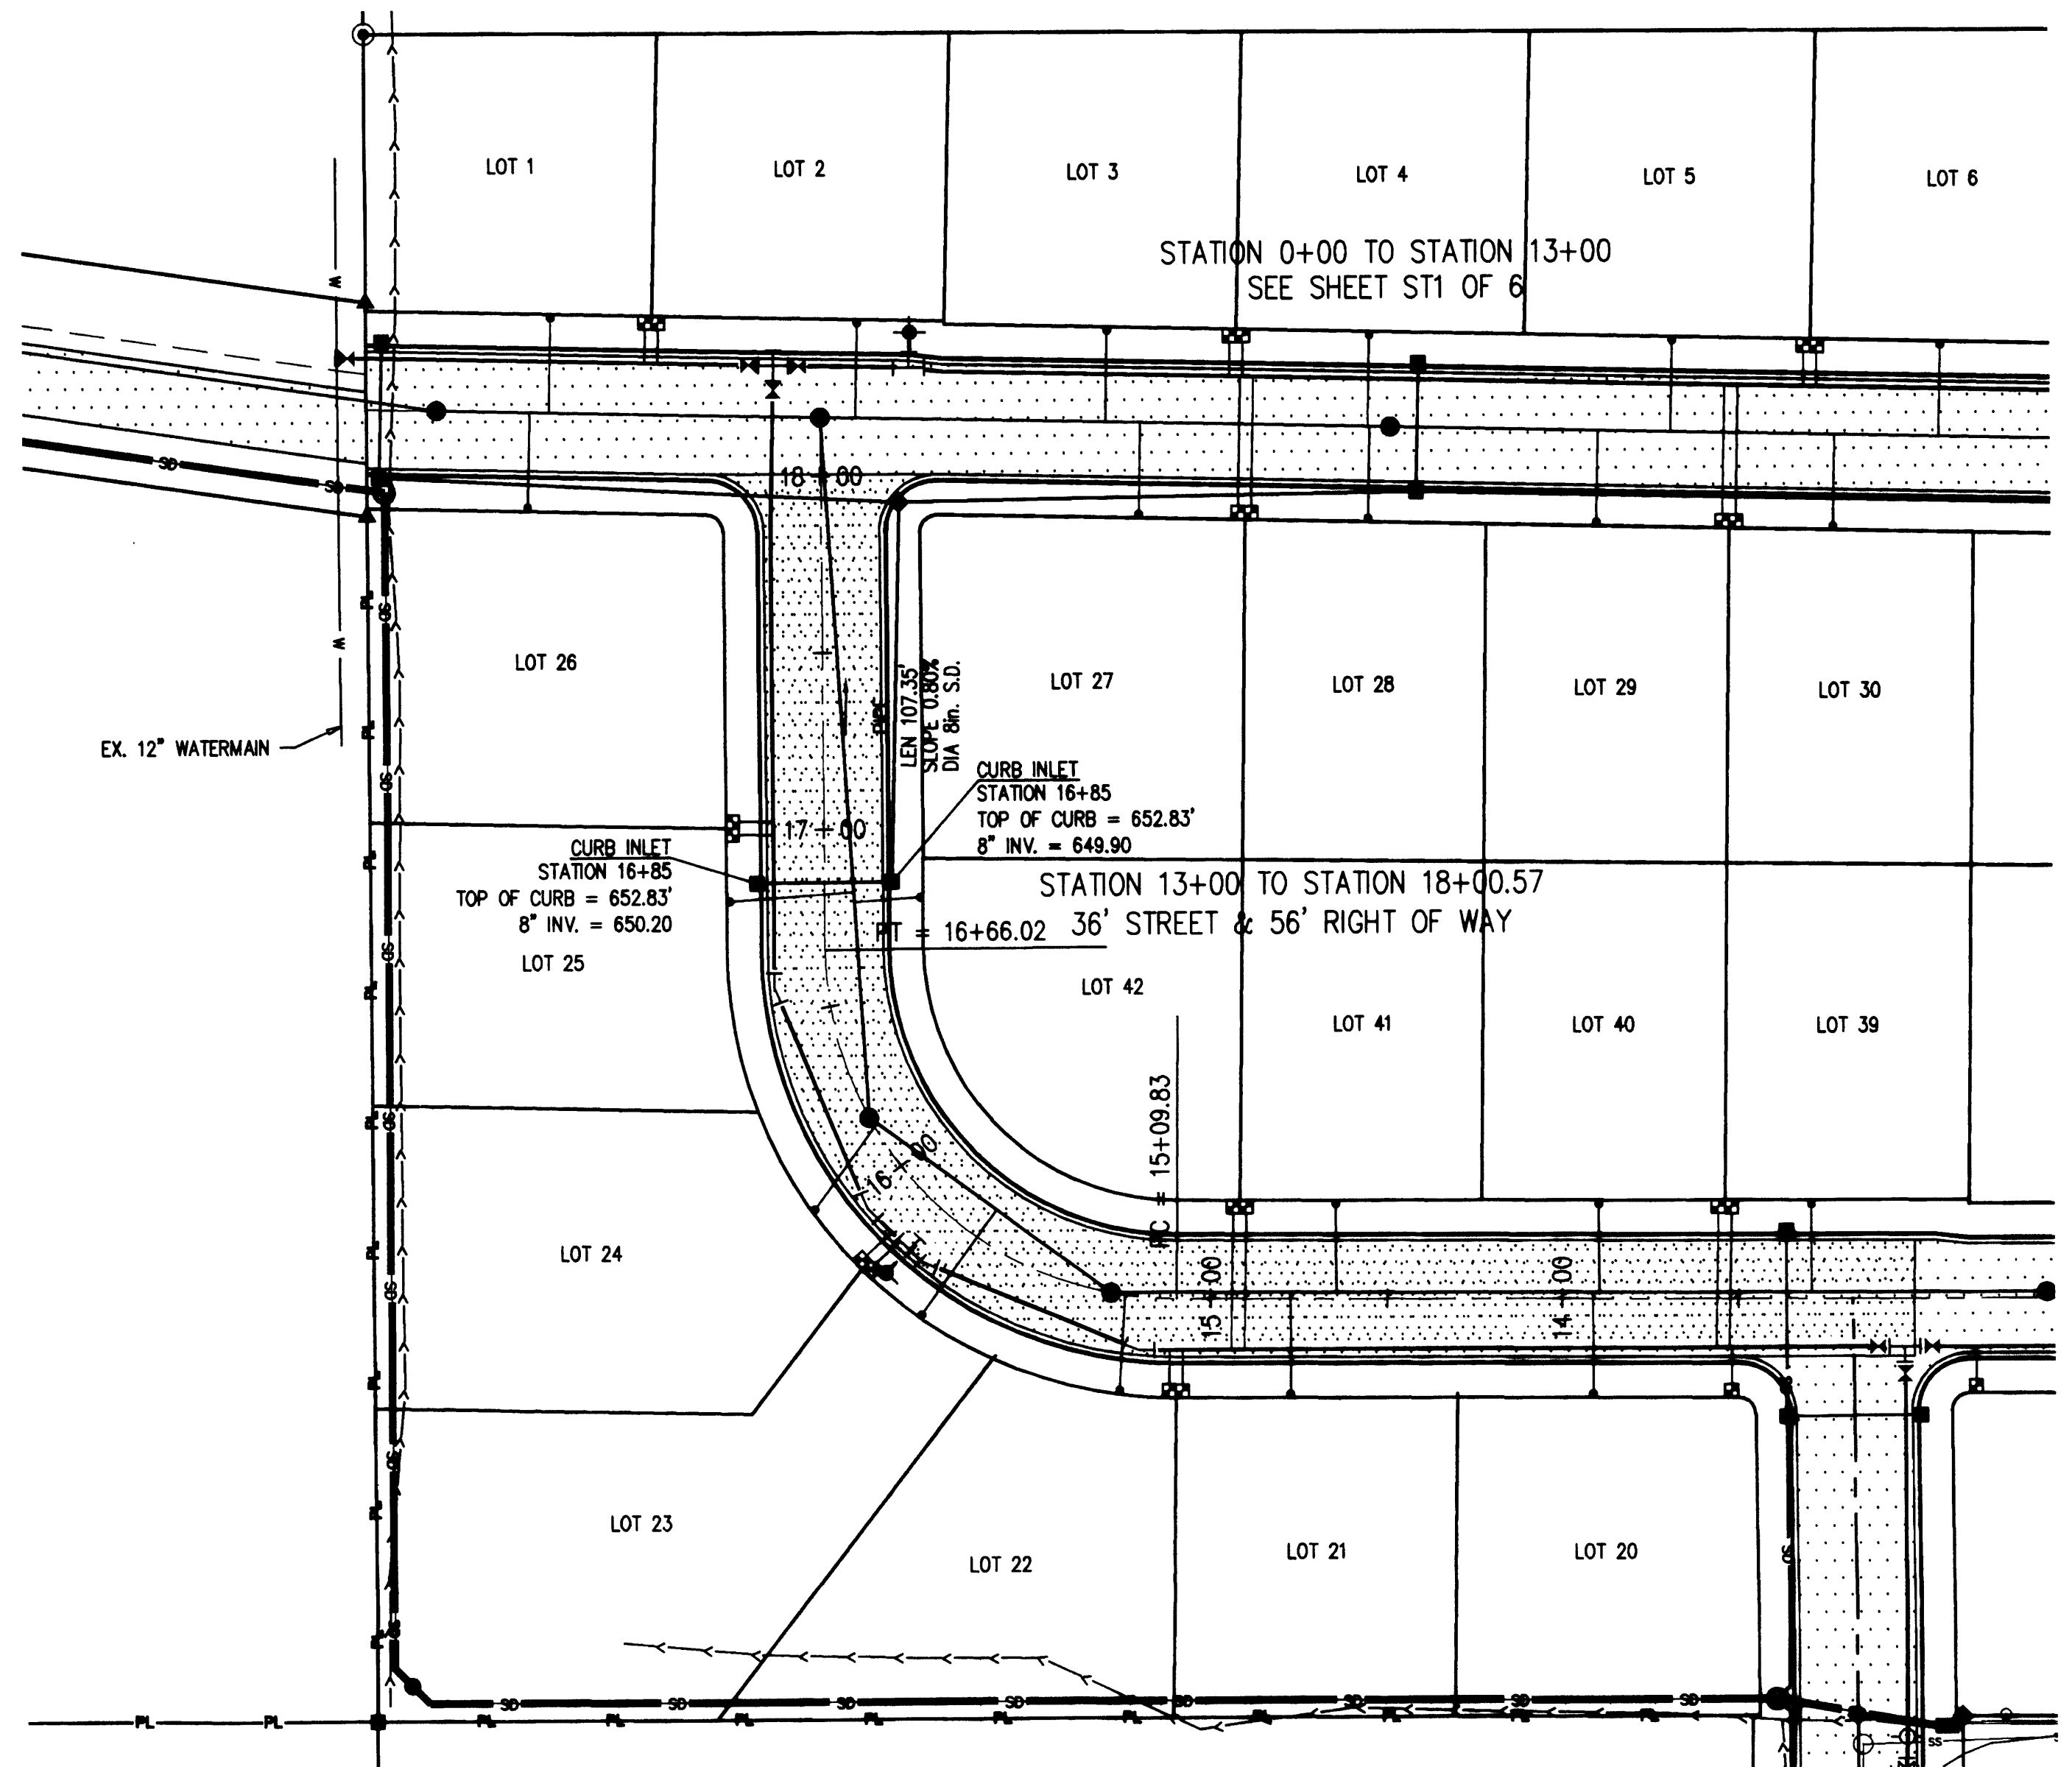

OWNER: **STULL ENTERPRISES**
 ENGINEERING & SURVEYING, INC.
 4135E MAIN ST., ROSSBURG, OR 97130
 PHONE (503) 653-9968 FAX (503) 653-9818
BTS

PROJECT: **GENTRY ESTATES**
 SHEET TITLE: **GENTRY LOOP PLAN & PROFILE**

DATE: AUGUST 10, 2005
 REV. #1: SEPT. 1, 2005
 REV. #2: SEPT. 2, 2005
 REV. #3: -
 REV. #4: -
 REV. #5: -



PROJ. #05-036
 SHEET NO.
 ST2 of 6

AS-BUILT PLANS - 3/8/06

A0300040