


T23S R6W W.M.
 Survey Made For Harold Woolley + E. G. Whipple
 of Drain, Oregon and Yoncalla Lumber Co. To
 Determine Lines and Corners.
 Survey Made by Wilford N. Haines #239 and
 Leo J. Martin #363 in 1956.

Note:
 ○ Corners Set by G.L.O. Crew
 ● Corners Set From This Survey; 1"x36" Leads with brass cap*
 ● Original Corners Located During Survey
 * Brass Caps Inscribed 'Wilford N. Haines #239 Survey Point'
 Bearings Determined From Magnetic Needle (Vandal 30° E)
 All Solid Lines Blazed Unless Marked 'Not Blazed'
 Scale: 1" = 400'

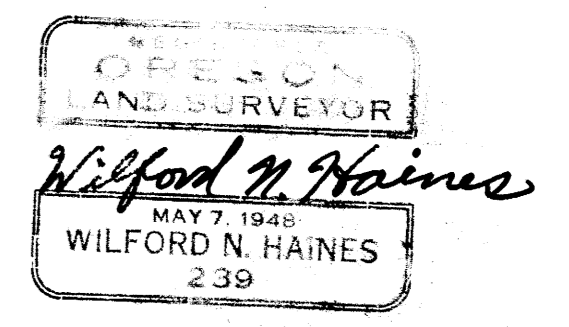

FILED
 RECEIVED
 MAY 9 1957
 COUNTY SURVEYOR
 DOUGLAS COUNTY, ORE.
 [Signature]