


SURVEY FOR DESCRIPTION OF PORTIONS OF
 LOTS 11, 12, 13, PLAT "C", N. CURRY ESTATE, SEC. 33,
 T. 26 S., R. 6 W., W.M., DOUGLAS COUNTY, OREGON
 FOR RALPH SANSTEDE FROM ROBERT HARMON
 BY HERBERT L. NORTHCRAFT
 SCALE 1" = 100' NOV. 1969

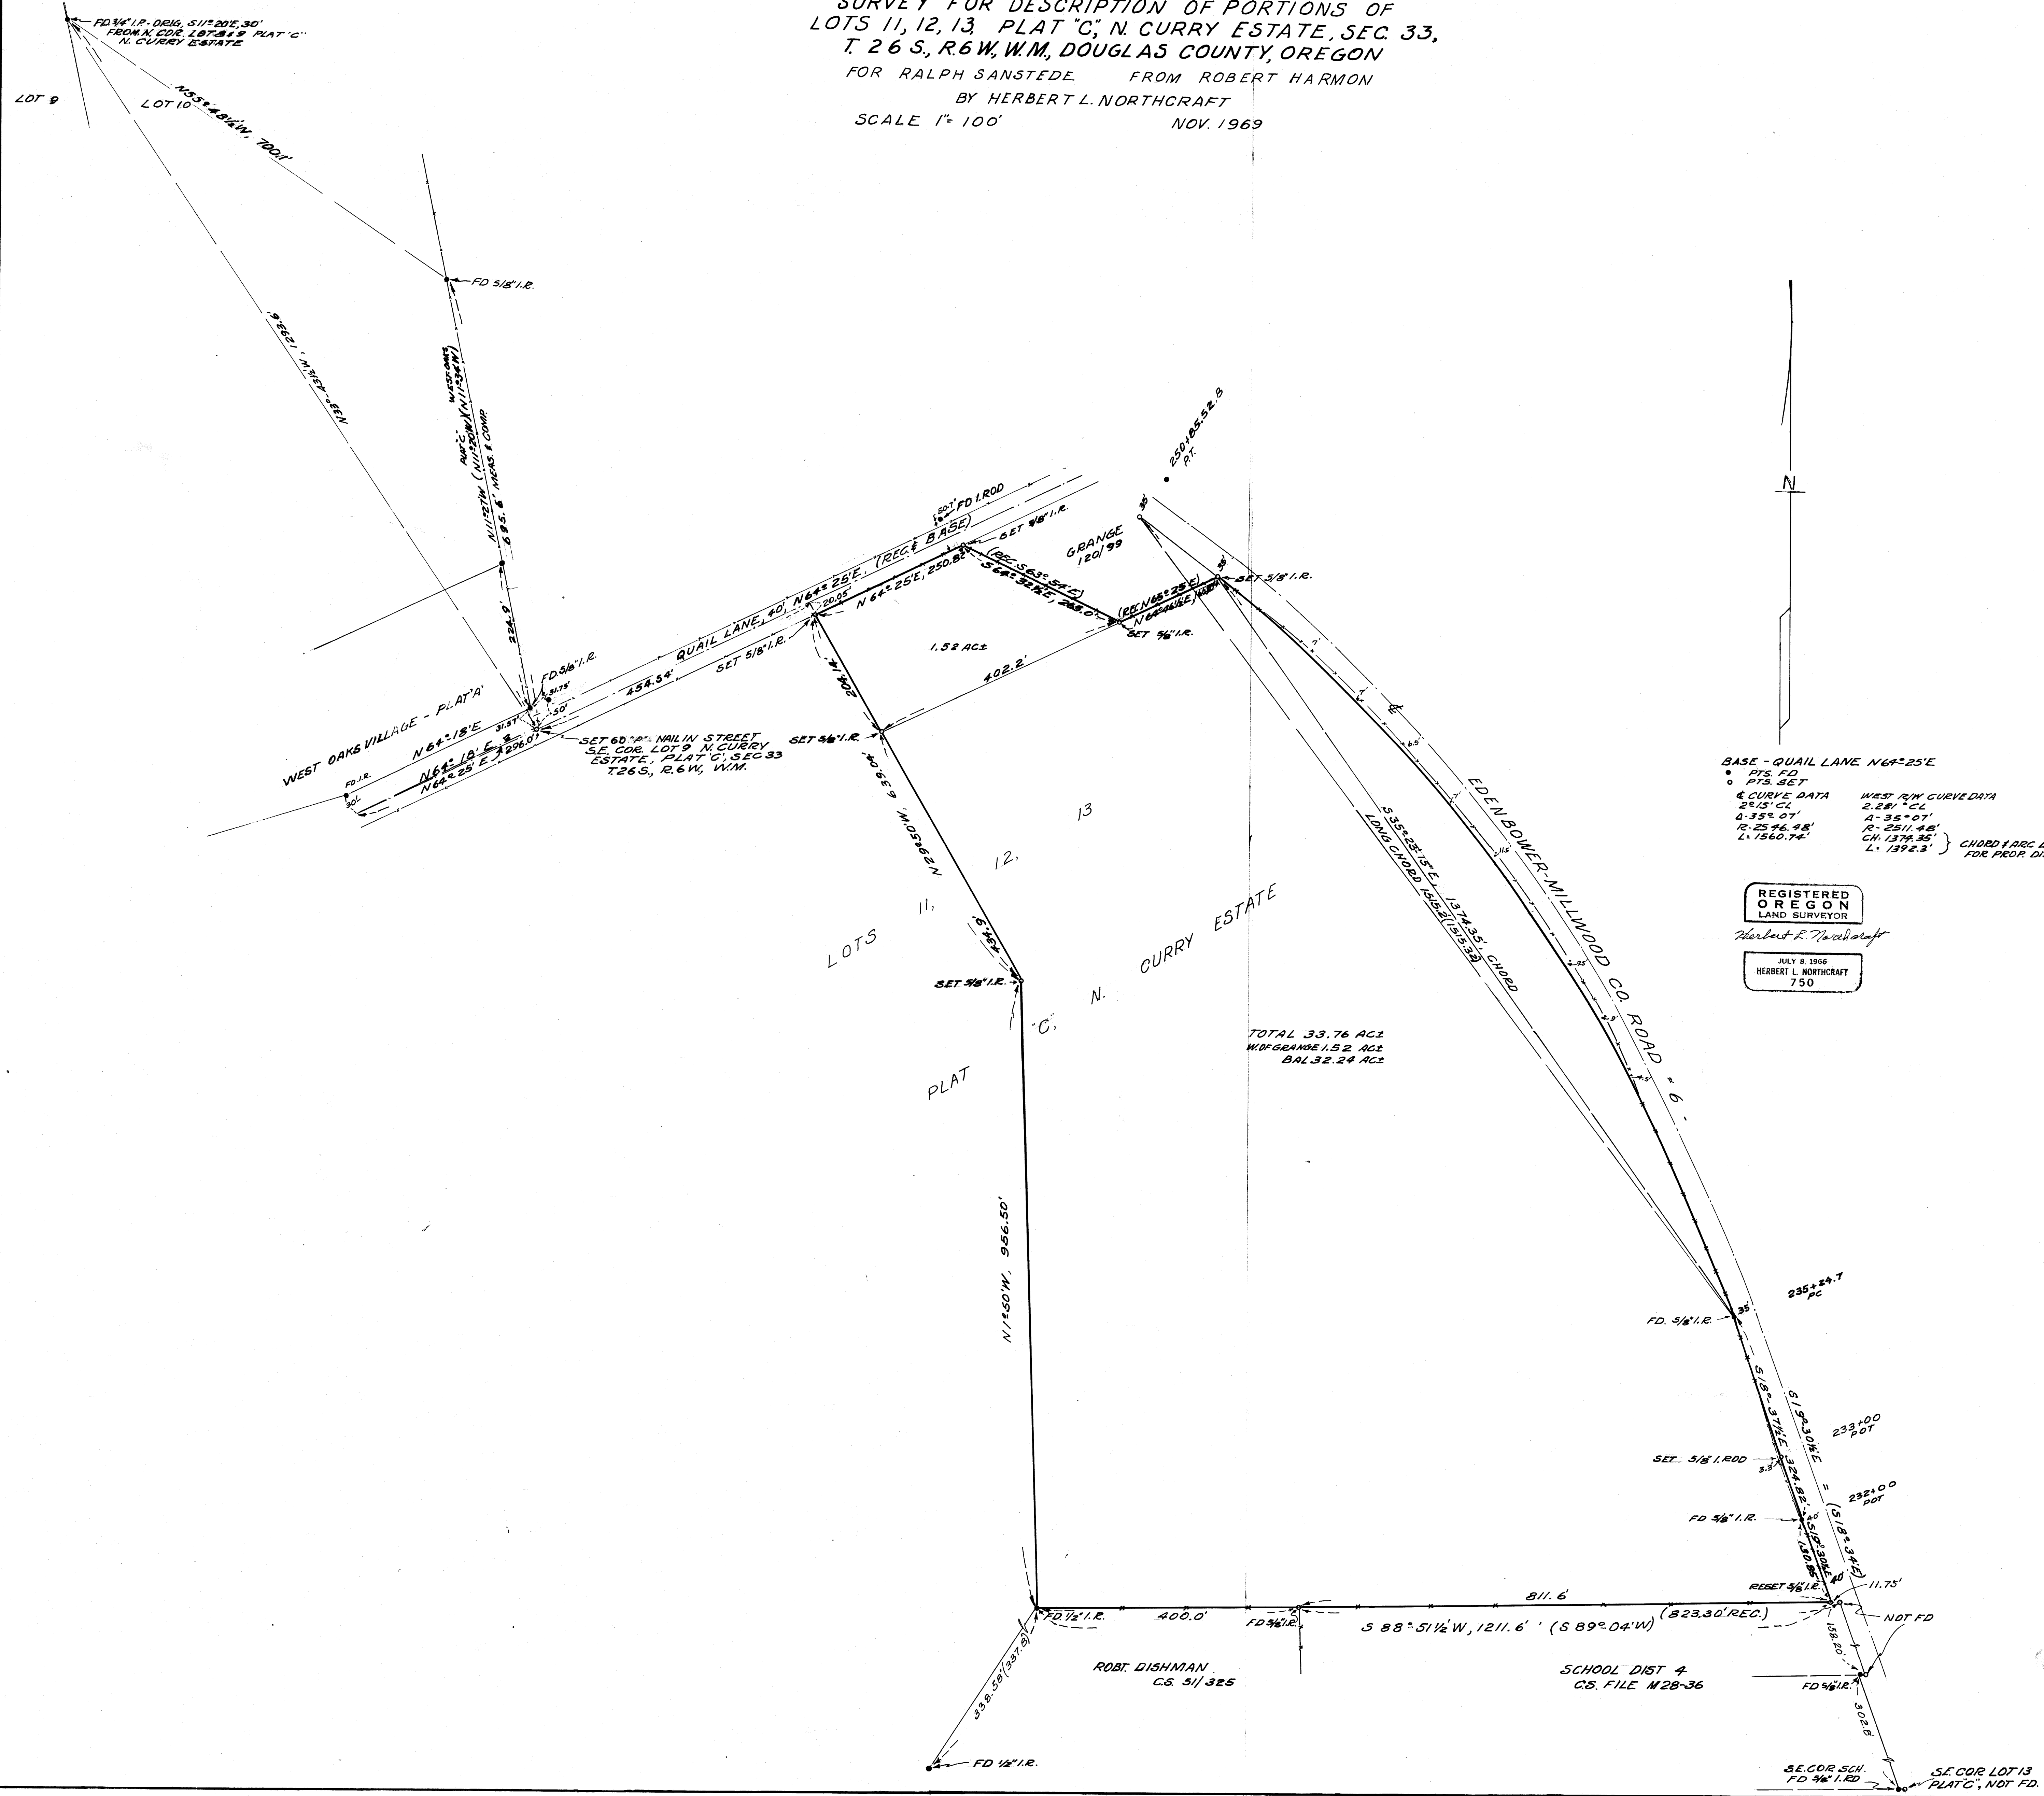

BASE - QUAIL LANE N64°25'E
 • PTS. SET
 • PIS. SET
 & CURVE DATA WEST R/W CURVE DATA
 25.15' CL 2.28' RCL
 0-35° 07' 4-35° 07'
 R-2511.48' R-2511.48'
 L-1560.74' CH-1379.85' L-1379.85'
 CHORD & ARC LINES FOR PROP. DISC.

REGISTERED
 OREGON
 LAND SURVEYOR

Herbert L. Northcraft

JULY 8 1968
 HERBERT L. NORTHCRAFT
 750

TOTAL 33.76 AC±
 W/GRANGE 1.52 AC±
 BAL 32.24 AC±

15W 1-18

15W 1-18