


FILED
RECEIVED
JAN 13 1970
COUNTY SURVEYOR
DOUGLAS COUNTY, ORE.

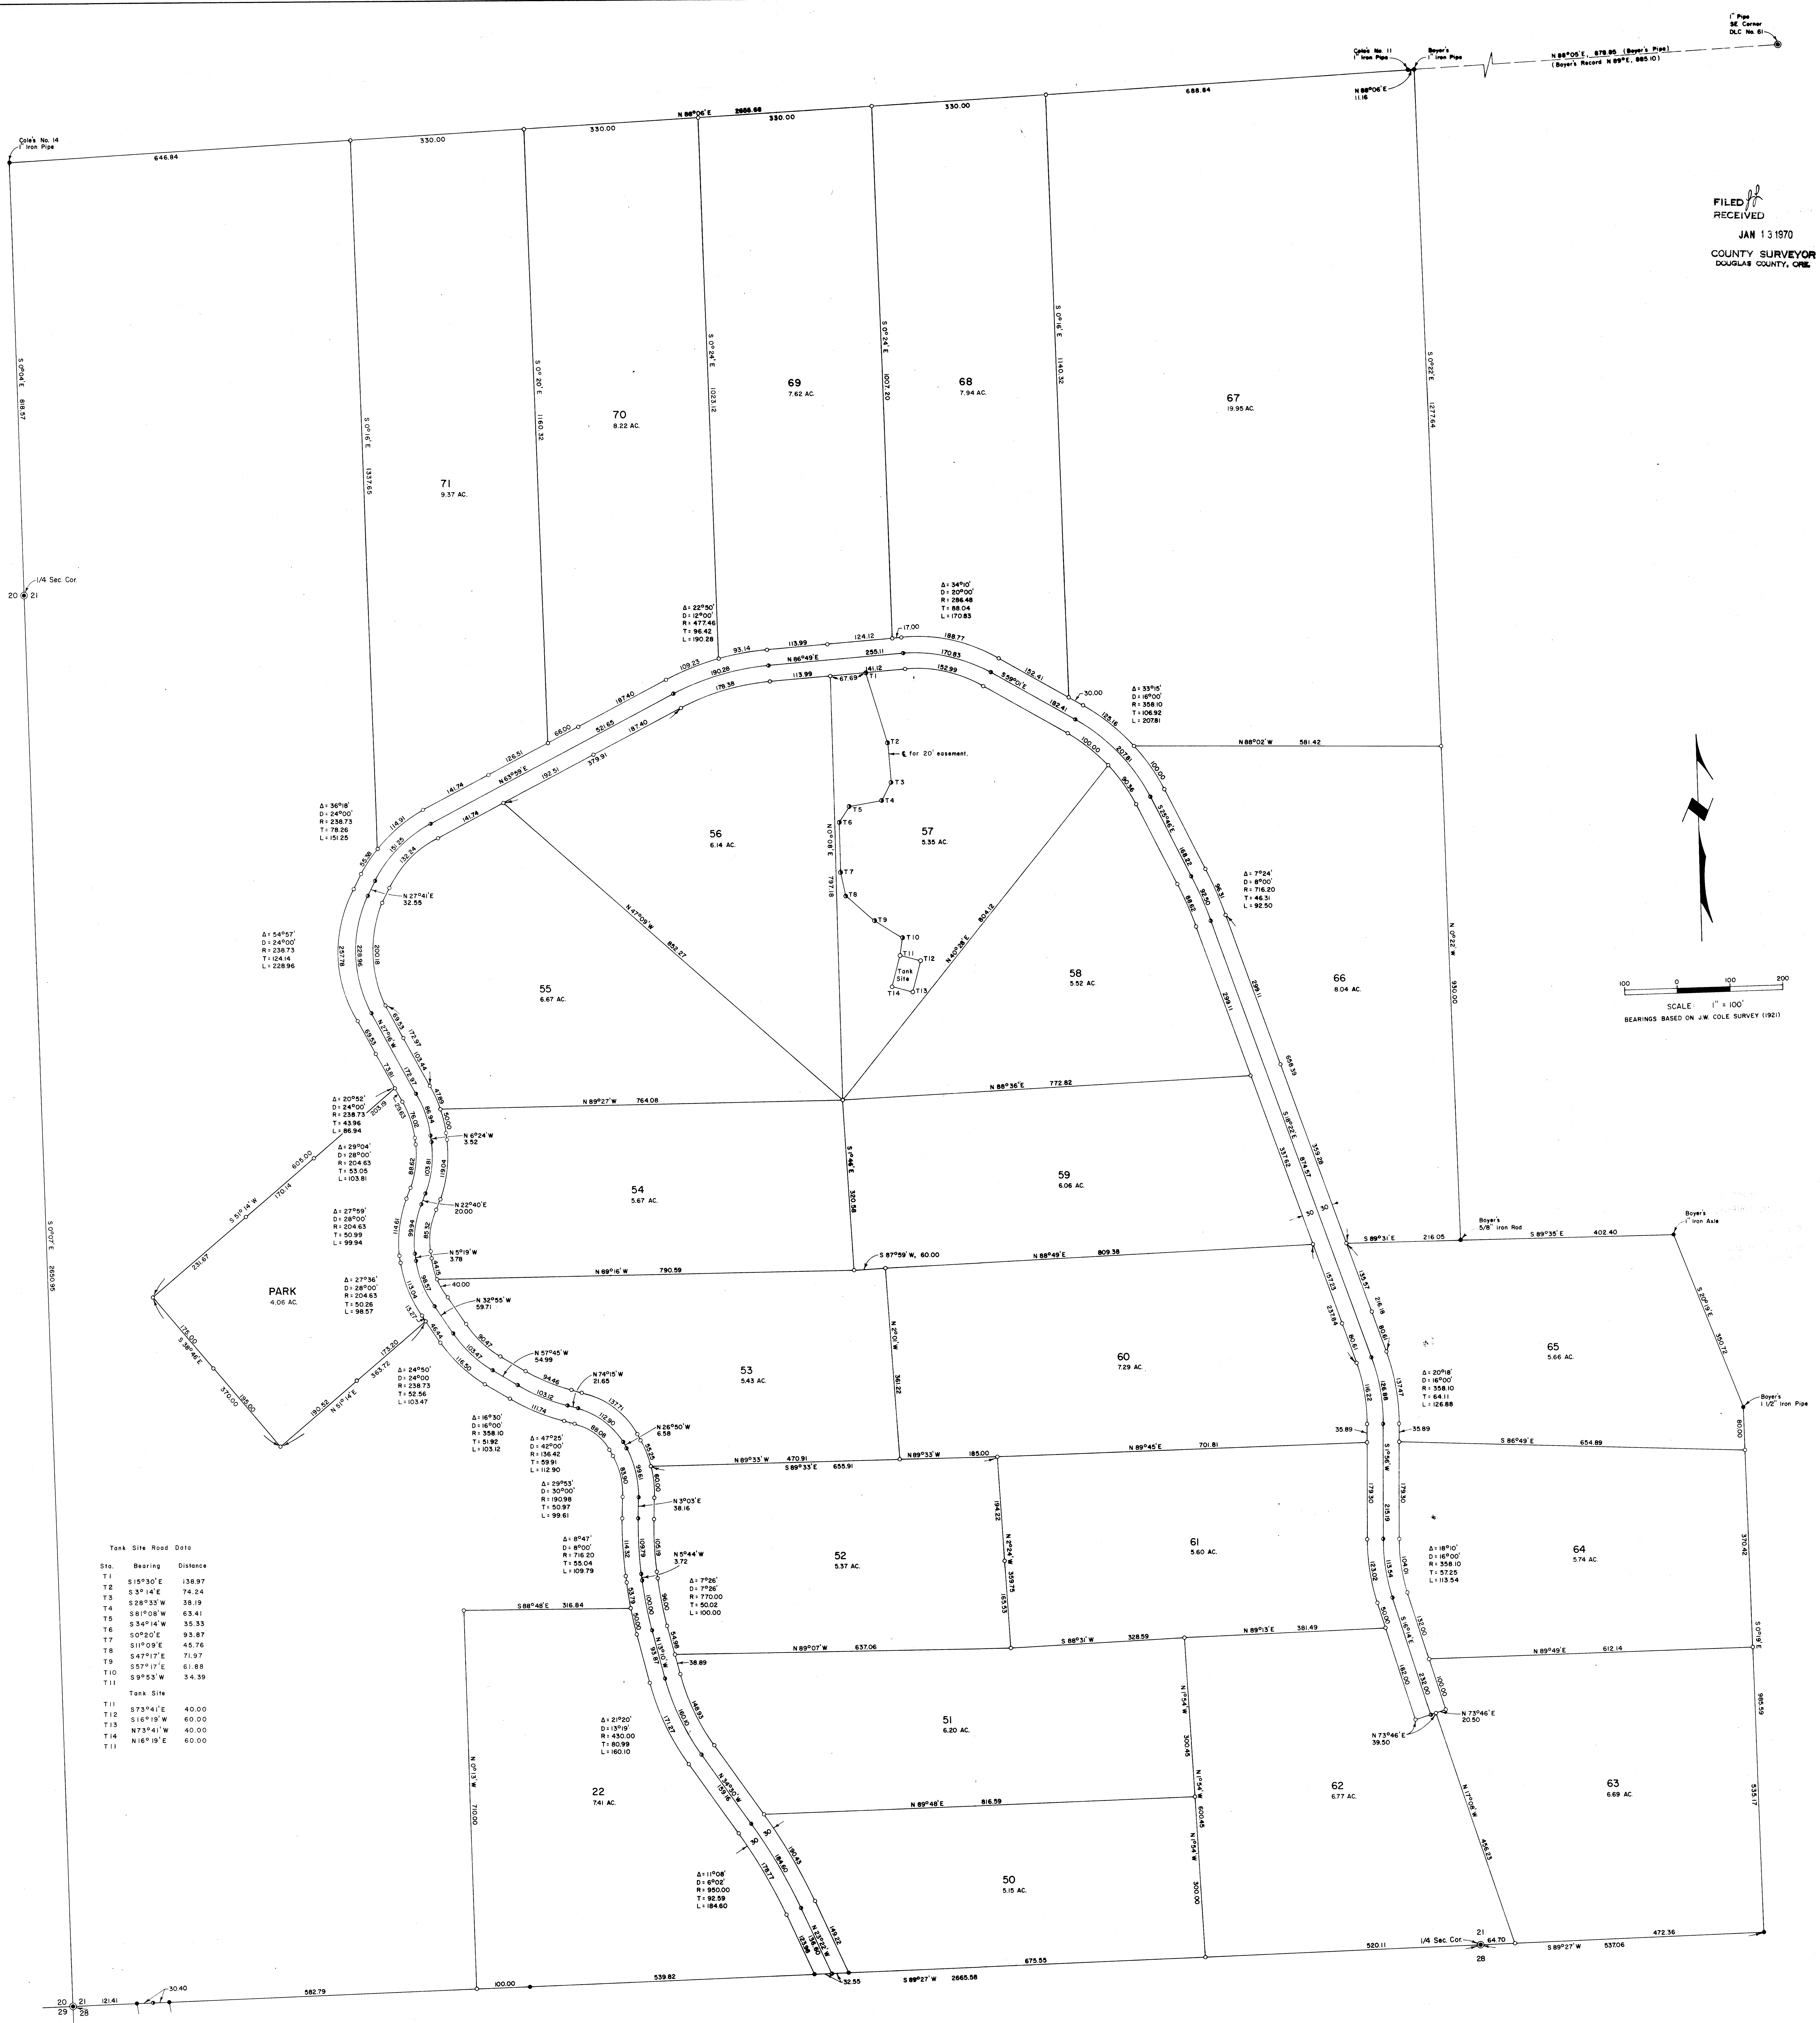

Δ: 54°57'
D: 24°00'
R: 238.73
T: 78.26
L: 124.14
L: 228.96

Δ: 20°52'
D: 24°00'
R: 238.73
T: 43.86
L: 86.94

Δ: 27°59'
D: 28°00'
R: 204.63
T: 50.99
L: 99.84

Δ: 27°36'
D: 28°00'
R: 204.63
T: 50.26
L: 98.57

Δ: 24°50'
D: 24°00'
R: 238.73
T: 32.56
L: 103.47

Δ: 16°30'
D: 16°00'
R: 358.10
T: 51.92
L: 109.79

Δ: 47°25'
D: 40°00'
R: 136.42
T: 59.91
L: 112.90

Δ: 29°53'
D: 30°00'
R: 190.38
T: 50.97
L: 99.61

Δ: 8°41'
D: 8°00'
R: 716.30
T: 55.04
L: 109.79

Δ: 7°28'
D: 8°00'
R: 770.00
T: 50.02
L: 100.00

Δ: 2°00'
D: 8°00'
R: 430.00
T: 40.99
L: 160.10

Δ: 11°08'
D: 8°00'
R: 850.00
T: 92.59
L: 184.60

Tank Site Road Data

Sta.	Bearing	Distance
T1	S15°30'E	138.97
T2	S3°14'E	74.24
T3	S28°33'W	38.19
T4	S81°08'W	63.41
T5	S34°14'W	35.33
T6	S0°20'E	93.87
T7	S11°09'E	45.76
T8	S47°13'E	71.97
T9	S57°13'E	61.88
T10	S9°53'W	34.39
T11		
T12	S73°41'E	40.00
T13	S16°15'W	60.00
T14	N73°41'W	40.00
T15	N16°15'E	60.00

NOTE:
ROAD R/W WIDTH 60 FEET - 30 FEET EACH SIDE OF E.

LEGEND:
● CORNERS FOUND - 5/8" IRON ROD UNLESS NOTED
○ CORNERS SET - 5/8" IRON ROD
● CORNERS COMPUTED BUT NOT SET
● SECTION CORNERS



TRACT SURVEY FOR GARDEN VALLEY
WEST, OREGON LTD. PROPERTY
IN SECTION 21, T 26 S, R 6 W, W.M.
DOUGLAS COUNTY, OREGON
SEPTEMBER 26, 1969
BRUCE A. SHANER, ENGINEER