



NOTE: ELEVATION OF 8' OF U.S. BENCH WEST OF S.E. CORNER 101.5' ASSUMED ELEVATION 106.5' TOP OUTLET CAP HOLE AT FIRE HYP.

NOTE: BEARINGS BASED ON PLAT OF "KRUSE TERRACE TRACTS"

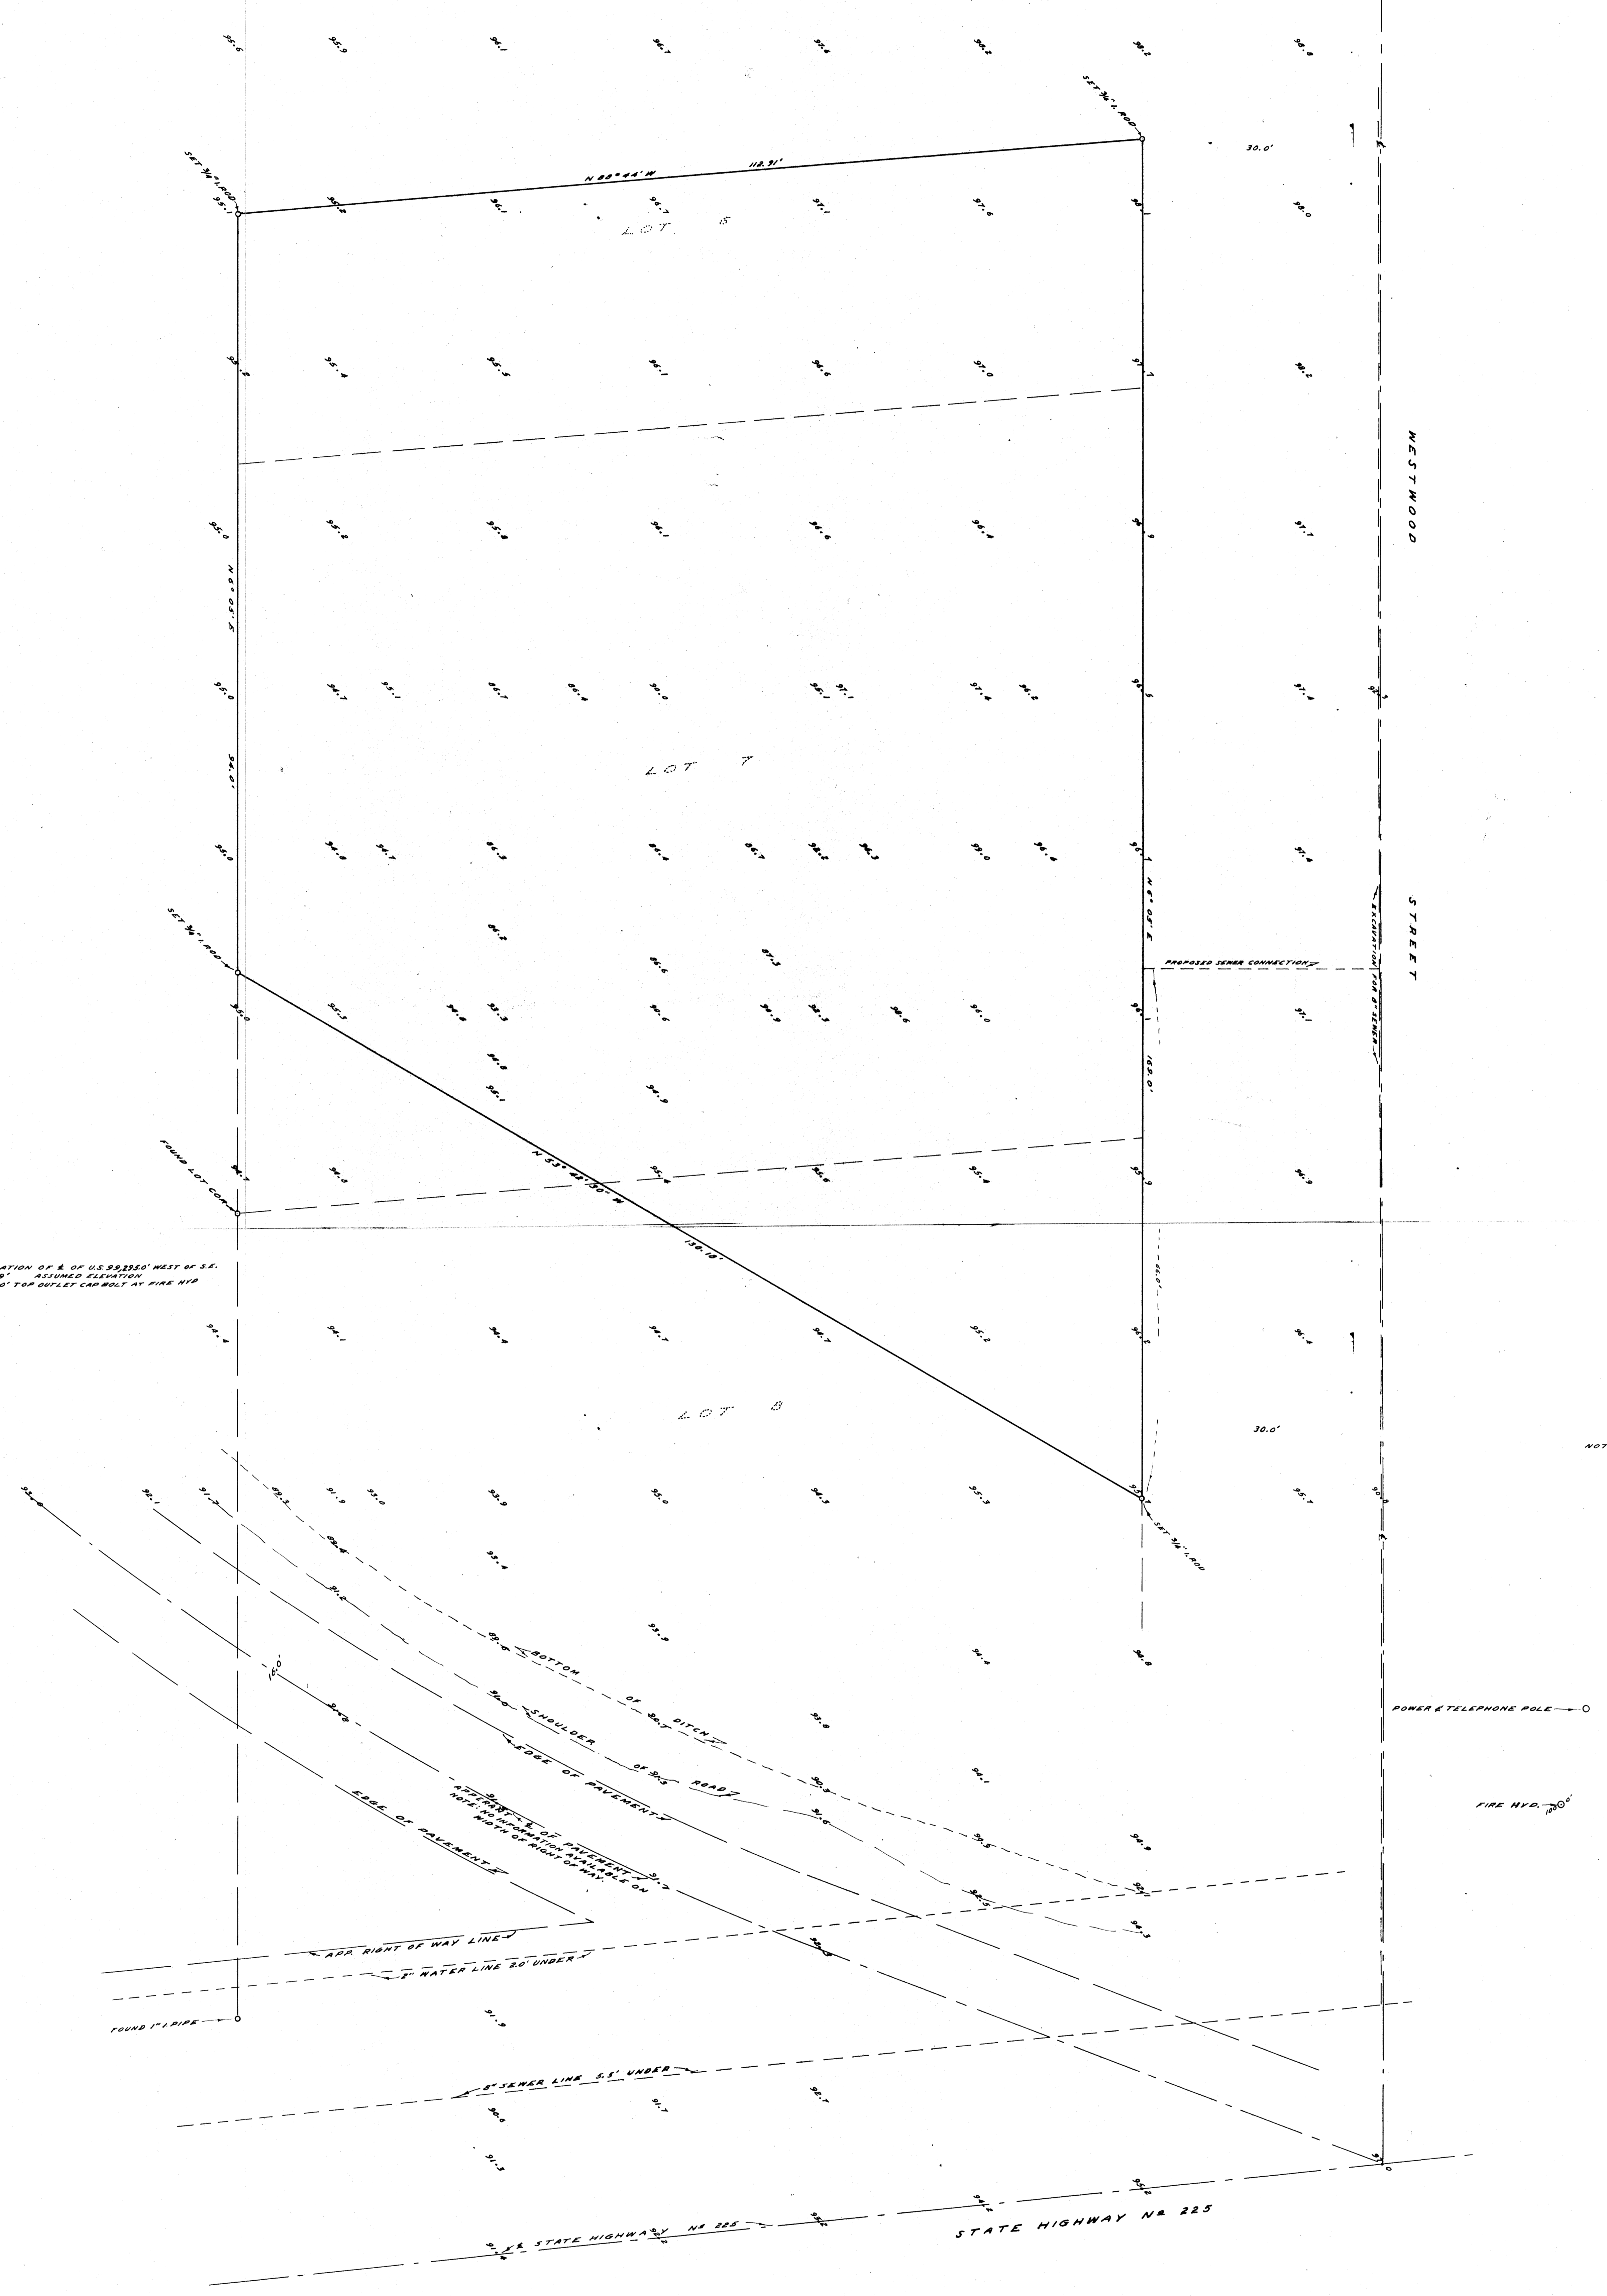

COUNTY SURVEYOR'S OFFICE
DOUGLAS COUNTY, OREGON
TOPOGRAPHY SURVEY IN LOTS 6, 7 & 8
KRUSE TERRACE TRACTS

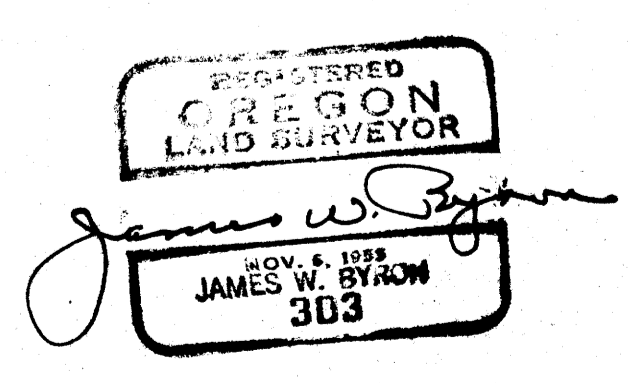

FRED M. DARBY COUNTY SURVEYOR
SURVEYED AUG. 6, 1959 BY
JAMES W. BYRON - DEPUTY SCALE 1" = 8'
SURVEYED FOR TIDEWATER OIL CO.