


\* F.d. original 24"x12"x8" stone with 1 notch on E & S notches on S with a rock mound 4 feet to West. Moving stone 0.5 feet N, 1 set brass cap.

Bearings based on solar observation  
Magnetic declination 211/2° E

**PROPERTY LINE SURVEY IN  
SECTION 6, T. 32 S., R. 1 W., W. M.  
SECTION 1, T. 32 S., R. 2 W., W. M.  
Umpqua National Forest  
Tiller Ranger District**

**Bruce A. Shaner** Engineer  
Scale 1" = 300'  
October 31, 1970  
Contract No. 002821 Field books 1 through 7

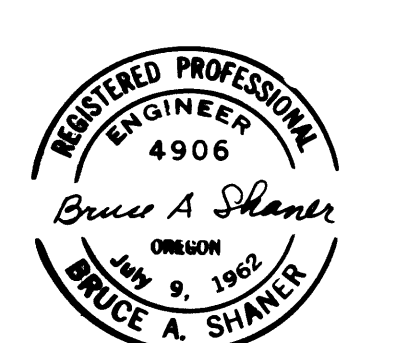

**CERTIFICATION**  
I, Bruce A. Shaner, a registered Professional Engineer in the State of Oregon, hereby certify that this plan and the notes hereon, or attached, are a correct representation of a survey I performed during Aug., Sept., and Oct. 1970, for the U. S. Forest Service, in accordance with the statutes of the State of Oregon and with the articles of my contract.

**LEGEND**

- Corner set
- Corner found
- Corner computed (not set)
- Property line marked with steel fence posts and signs

