

Fd. brass cap mkd.
County Surveyor's Office
T33S, R7W
S3, S2 1965 DEPLS 5
From which a:
8" madrone BT
Scribes vis.
Bears S83°E, 4.3 ft.
16" chinquapin BT
Scribes vis.
Bears S18°48'E, 17.0 ft.
(Record, 16.6 ft.)
24" chinquapin BT
Scribes vis.
Bears S82°50'E, 28.0 ft.
Note: Brass cap is at a
fence corner, fence running
South and West.

Fd. 5/8" iron rod
with plastic cap mkd.
Masters RS 457
From which a:
10" madrone BT
Scribes vis.
Bears S63°W, 26.9 ft.
(Record, S55°W)
8" madrone BT
Scribes vis.
Bears S11°E, 16.1 ft.
1" iron rod
Bears N9°33'W, 17.28 ft.

Set brass cap mkd.
T33S, R7W, WM
NW1/6 S3, S2 1974
From which a:
6" Douglas fir, 1 scribed,
"N1/16 S3 BT"
Bears N61°W, 21.5 ft.
7" Douglas fir, 1 scribed,
"N1/16 S3 BT"
Bears S11°W, 143.4 ft.
3/4" iron rod bears
S83°W, 4.01 ft.

Set 5/8" iron rod
with aluminum cap mkd.
NW1/16 S2
From which a:
8" Douglas fir, 1 scribed,
NW1/16 S2 BT
Bears S2°W, 117.9 ft.
22" ponderosa pine, 1 scribed,
"NW1/16 S2 B"
Bears N34°E, 81.3 ft.

Fd. 3/4" iron pipe with metal
tag mkd. 1/4S 1543
From which a:
10" fir, original BT
Stump completely rotted
Fd. piece of wood
mkd. "S BT"
Bears N33°W, 25.1 ft.
40" fir, original BT
Now rotted stump
Bears S40°E, 31.0 ft.
10" chinquapin BT
Scribes vis.
Bears S44°W, 26.6 ft.
12" madrone BT
Scribes vis.
Bears N45°E, 21.6 ft.


At C1/4 Sec. Cor.
Fd. 5/8" iron rod
with plastic cap mkd.
Masters RS 457
From which a:
6" madrone BT
Scribes vis.
Bears N36°W, 2.9 ft.
4" madrone BT
Scribes vis.
Bears N67°E, 34.8 ft.
4" madrone BT
Scribes vis.
Bears S42 3/4°E, 73.3 ft.
Copco power pole No. E3014
Bears S26 1/4°W, 77.9 ft.

PROPERTY LINE SURVEY IN THE
NW1/4 SEC. 2, T. 33 S., R. 7 W., W. M.

For: Robert Hissong
Glendale, Oregon

By: Shaner Engineering
Roseburg, Oregon

May 8, 1974

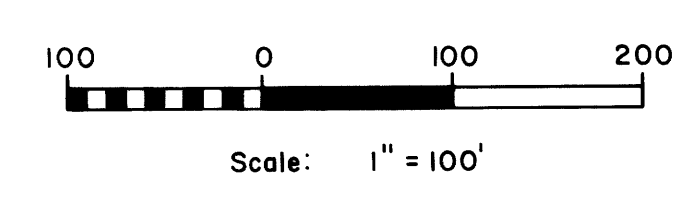

Basis of bearings: Survey
by Claude Masters, Douglas
County Surveyor's Map
File No. M.41-39.

LEGEND

Corner found	●
Corner set	○
Corner computed, not set	○
5/8" iron rod with aluminum cap, set	•
Property corner or point not set	○
Property line	—
Random line	- - -
Line computed, not run	- - - - -
Fence	- x - x -