


SURVEY TO SET PROPERTY CORNERS IN SECTIONS 16, 17, 20 & 21, T.25S.R.5W.W.M.

FOR: FRED HARRINGTON, ETAL.
 BY: BAUGHMAN SURVEYING SERVICE
 SEPTEMBER 1974 SCALE: 1" = 200'
 RM 2-66 REVISED FEBRUARY 1975

FILED 2
 REC'D 27
 FEB 19 1975
 COUNTY CLERK OF
 TOWNSHIP SURVEY, ORE.

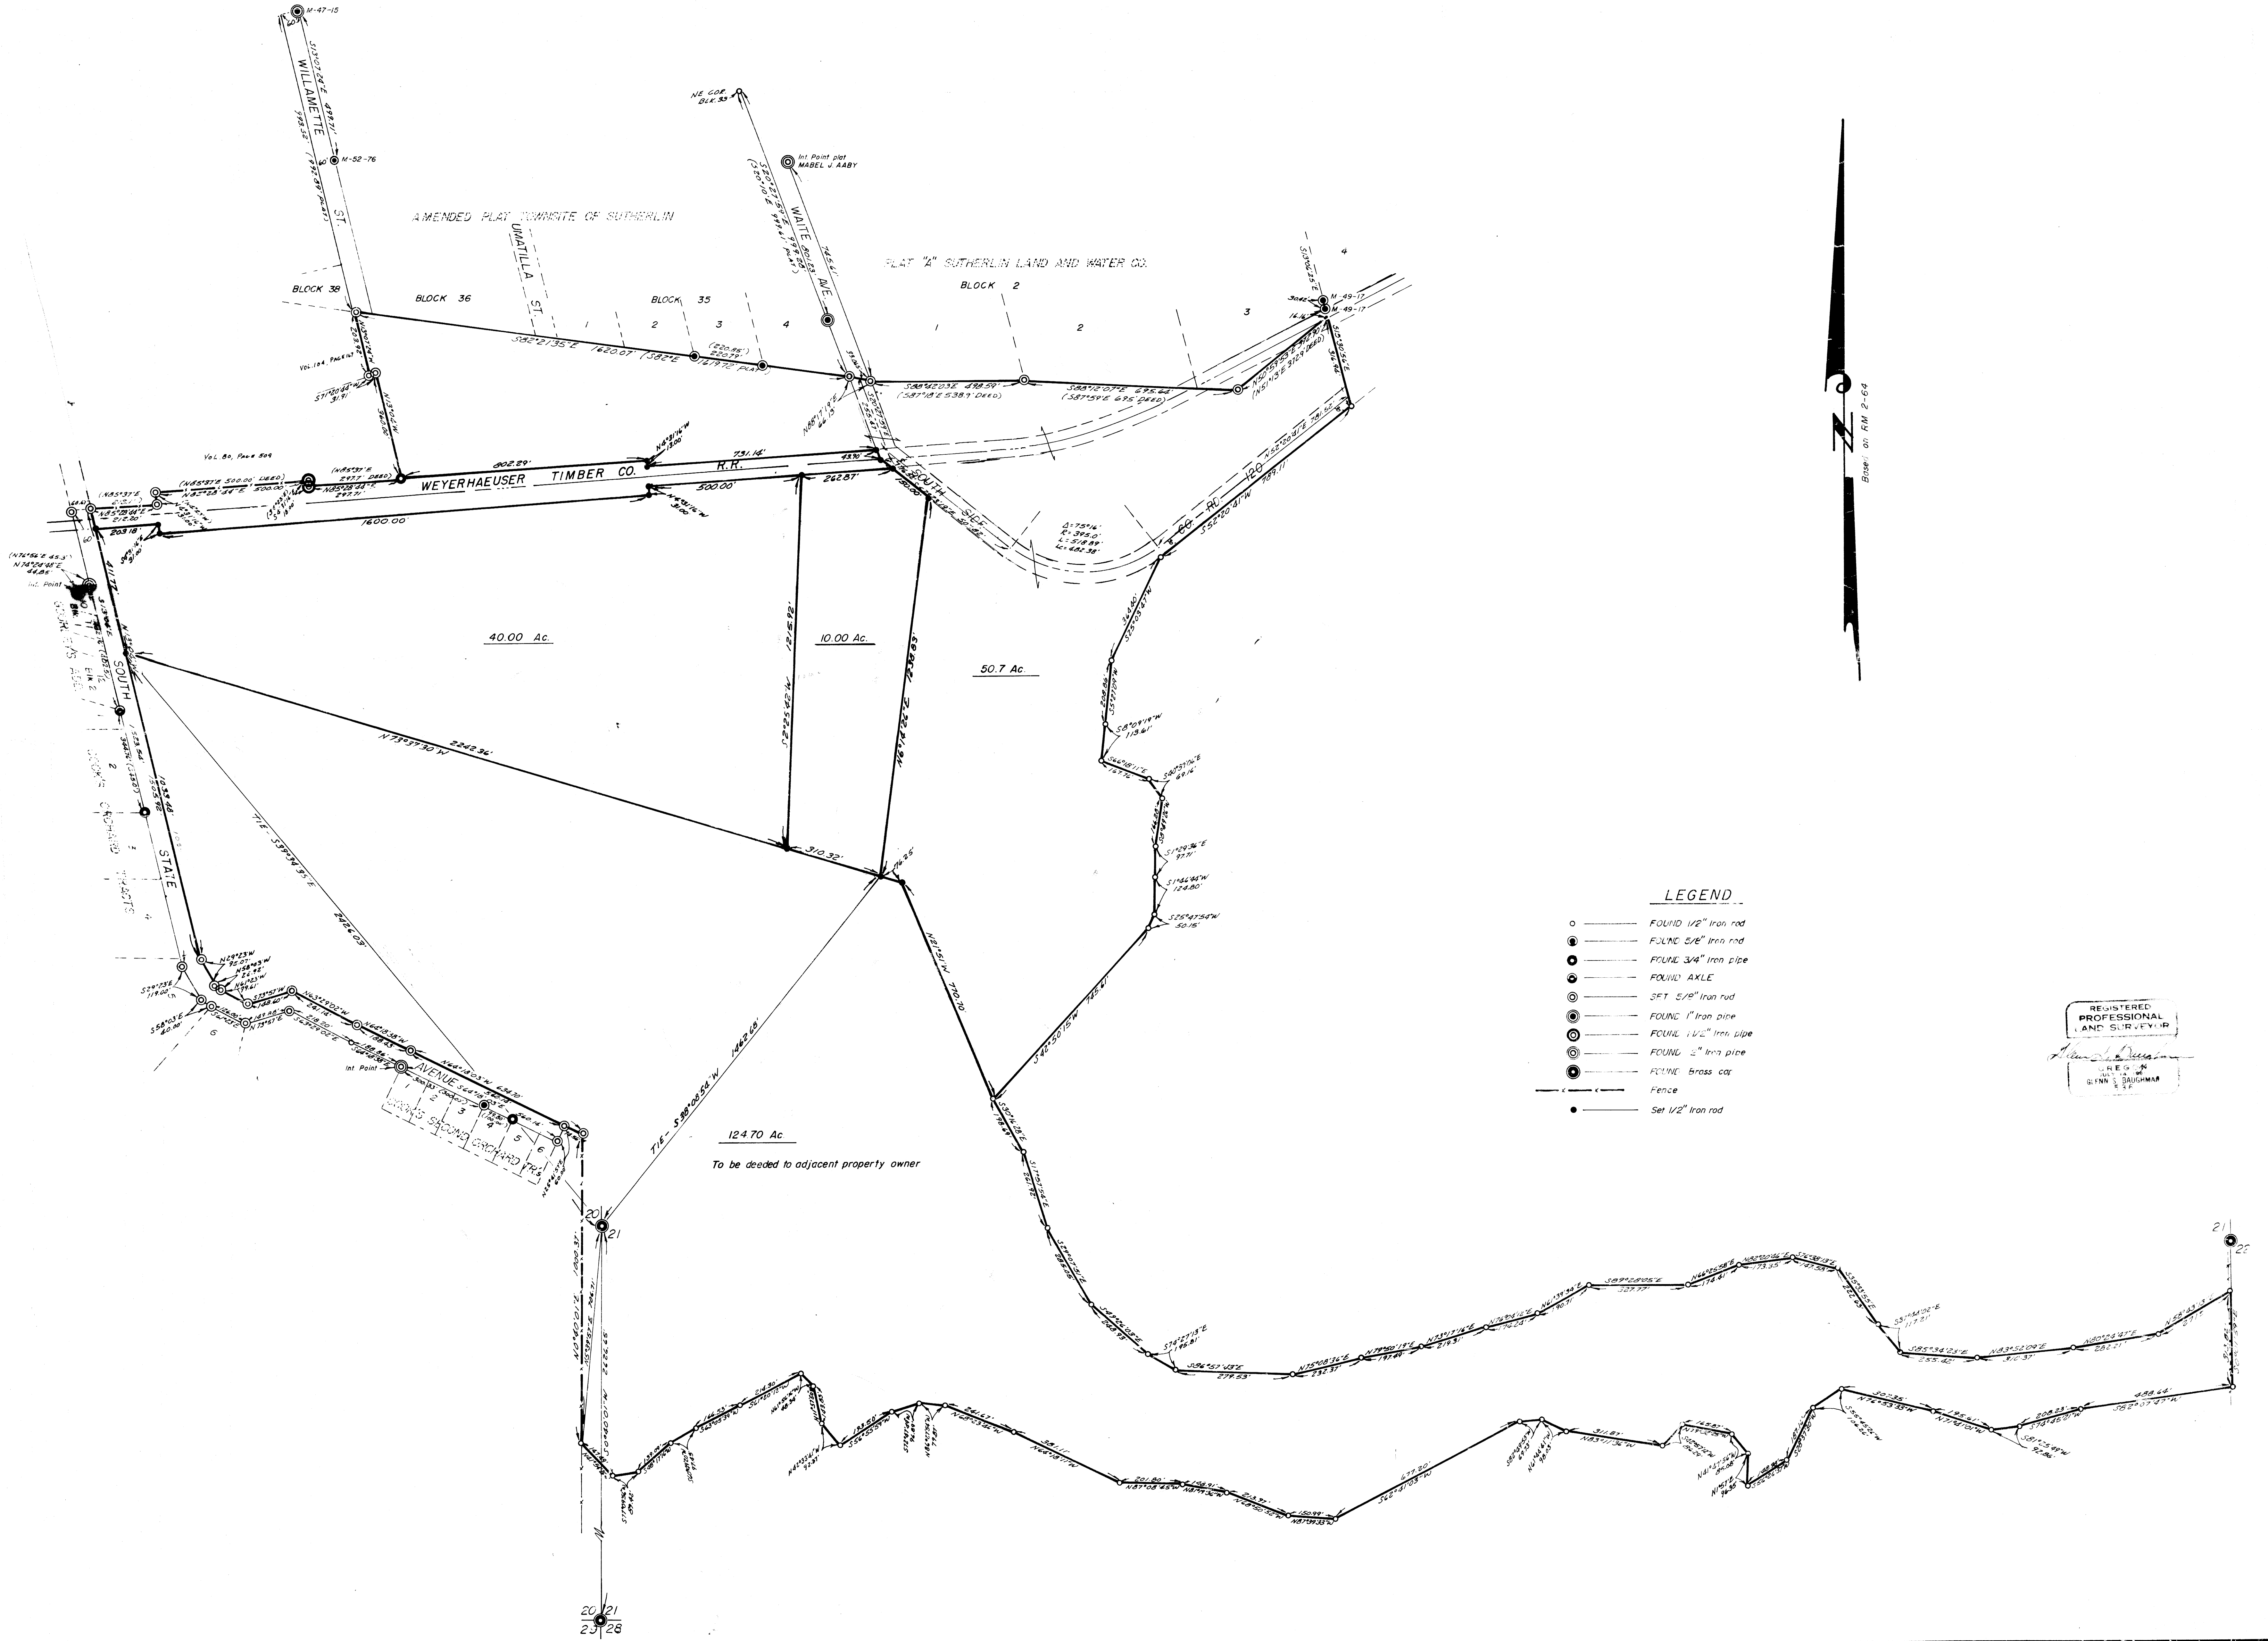

- LEGEND**
- FOUND 1/2" Iron rod
 - FOUND 5/8" Iron rod
 - FOUND 3/4" Iron pipe
 - FOUND AXLE
 - SET 5/8" Iron rod
 - FOUND 1" Iron pipe
 - FOUND 1 1/2" Iron pipe
 - FOUND 2" Iron pipe
 - FOUND Brass cap
 - Fence
 - Set 1/2" Iron rod

REGISTERED
 PROFESSIONAL
 AND SURVEYOR
 Glenn S. Baughman
 U.S. GEOLOGICAL SURVEY
 GLENN S. BAUGHMAN
 S.F.P.