


NARRATIVE

Section 5 was subdivided as per map for the purpose of setting property corners and marking property lines. A Franke 20" theodolite and a "Mac" EDM were used. The exterior corners of the Section were found to be as set by the U.S.B.L.M. and other surveys as shown on map. On all B.T.'s I scribed, I placed a brass disk marked "R.L.S. 430".

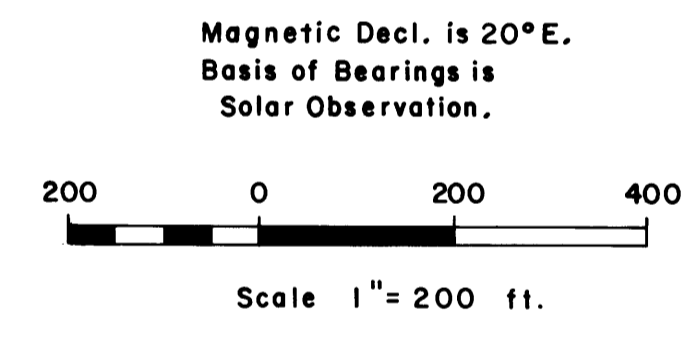

LEGEND

Corner found	●
Corner set	⊙
Corner computed, not set	○
True line marked with posted signs & painted blazes	—
True line marked with posted signs	—
Line traversed	—
Line computed, not run	—
Rock Road	—
Creek	—

CERTIFICATE OF SURVEYOR

I Bruce A. Shoner, registered land surveyor in the State of Oregon, hereby certify that this plot and the notes hereon or attached, are a correct representation of a survey we performed during July, thru October, 1980, for the U.S. Forest Service in accordance with statutes of the State of Oregon and with the articles of the contract.

BA Shoner
 Bruce A. Shoner
 Registered Land Surveyor
 Oregon License 430



Found 3" square Yew post original corner in which place I set Brass cap mkd. T32S, RIW, W.M. 1/4, S5, S8 R.L.S. 430, 1980 From which a: 24" Douglas fir, B.T. Scribes 1/4 visible Bears N80°W, 9.2 ft. 45" Douglas fir stump, original B.T. Bears S40°E, 25.7 ft. to face (Record S40°E) 10" Douglas fir B.T., I scribed "1/4, S8, B.T." Bears S46°E, 45.4 ft. 8" Douglas fir B.T., I scribed "1/4, S5, B.T." Bears N32°E, 25.4 ft.

TILLER LAND SURVEY NO. 36 OF SEC. 5, T32S, R1W, W.M. DOUGLAS COUNTY, OREGON (Contract No. 53-04HI-9-7462 N)

For: Tiller Ranger District, Umpqua National Forest
 By: Shoner Engineering, Inc. P.O. Box 1430 Roseburg, Oregon
 October, 1980

Found Brass cap mkd. T32S, RIW, S5, S4, S8, S9 1968, Co. Surveyor From which a: 24" Douglas fir, B.T. Healed over face Bears N61°E, 24.6 ft. 11" Cedar B.T. Healed over face Bears N63°W, 9.9 ft. (Record 9.2 ft.) 38" Douglas fir, B.T. Scribes visible Bears S49°W, 17.8 ft. 14" Cedar B.T. Scribes visible Bears S18°E, 14.8 ft.