


FILED *BS*
 RECEIVED *BS*
 JAN 20 1981
 COUNTY SURVEYOR
 DOUGLAS COUNTY, OREGON
BS

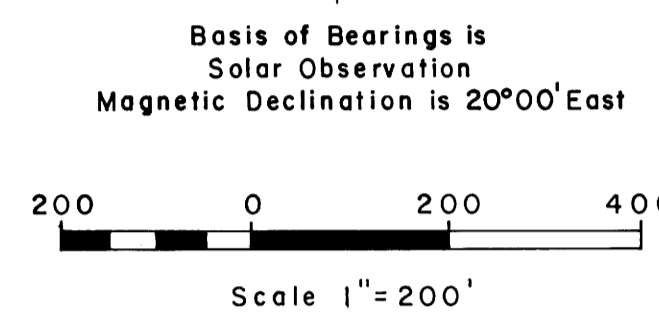

NARRATIVE

Section 15 was subdivided as per map for the purpose of setting property corners and marking property lines. A Franke 20" theodolite and a "Mac I" EDM were used. The north line of Section 15 was surveyed by Hathorn, U.S.G.L.O. in 1857 and later by Mensch, U.S.G.L.O., 1904. I replaced the lost corner by proportioning it to Mensch' record, as per method of irregular boundaries, as described in Section 5-36 of the 1973 U.S.B.L.M. Manual of Surveying Instructions. On all BT's I scribed, I placed a Brass disc marked "R.L.S. 430."

CERTIFICATE OF SURVEYOR

I, Bruce A. Shaner, registered land surveyor in the State of Oregon, hereby certify that this plat and the notes hereon or attached, are a correct representation of a survey we performed during December 1980 thru January 1981, for the U.S. Forest Service in accordance with the statutes of the State of Oregon and with the articles of the contract.

BA Shaner
 Bruce A. Shaner
 Registered Land Surveyor
 Oregon License 430

LEGEND

- Corner found
- Corner set
- Line Traversed and Posted
- Line Traversed
- Line computed, not run
- Creek
- Dirt Road

TILLER LAND SURVEY NO. 36 OF SEC. 15, T 30 S, R 1 W, W. M., DOUGLAS COUNTY, OREGON (Contract No. 53-04HI-9-7462N)

For: Tiller Ranger District, Umpqua National Forest

By: Shaner Engineering, Inc.
 P.O. Box 1430
 Roseburg, Or. 97470

Note:
 Above record bearings and distances shown are from Douglas Co. Surveyor renewal 1975.