


NARRATIVE

The survey was performed as per map for the purpose of setting property corners and marking property lines. A Franke 20" theodolite and a "Mac" EDM was used. The corners of the Sections were found to be set by the U.S.B.L.M. and other surveyors as shown on map. On all BT's I scribed, I placed a brass disk marked "R.L.S. 430."

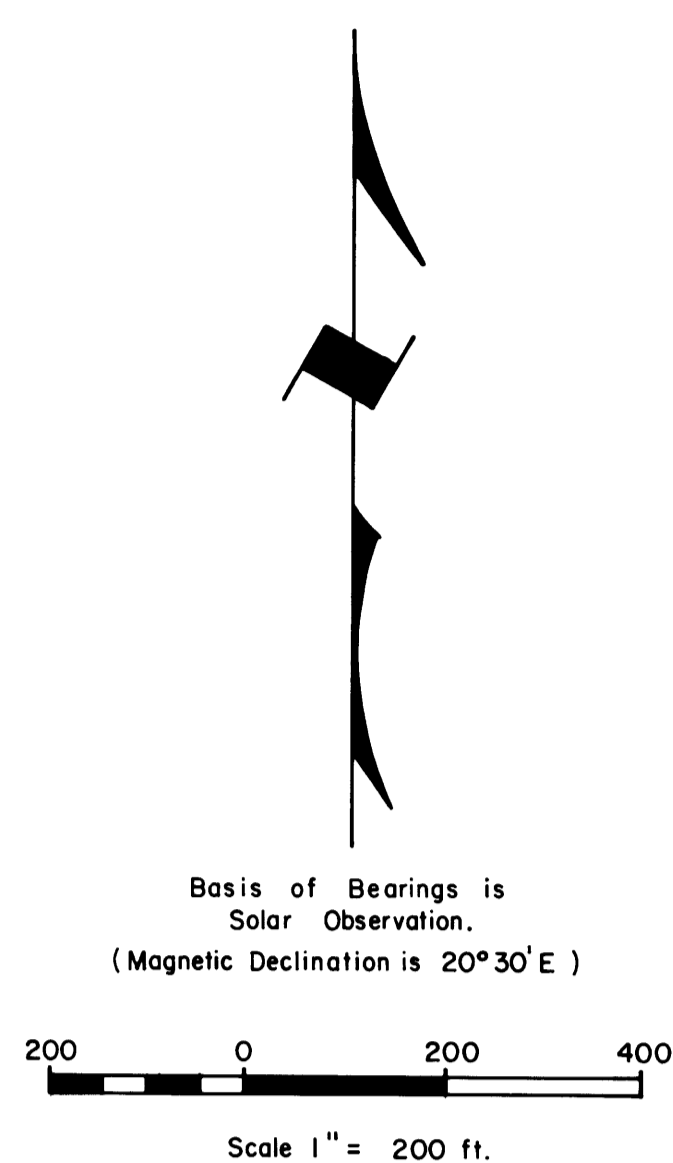

LEGEND

- Corner found (circle with dot)
Corner set (circle with cross)
True line marked with posted signs (solid line)
Rock road (dashed line)
Creek (wavy line)

CERTIFICATE OF SURVEYOR

I, Bruce A. Shaner, registered land surveyor in the State of Oregon, hereby certify that this plat and the notes hereon are a correct representation of a survey we performed during January, 1981, for the U.S. Forest Service in accordance with statutes of the State of Oregon and with the articles of the contract.

BA Shaner

Bruce A. Shaner
Registered Land Surveyor
Oregon License 430



TILLER LAND SURVEY NO. 36 OF SOUTH & EAST LINES OF SECTION 29, T30S, RIW, W.M. DOUGLAS COUNTY, OREGON (Contract No. 53-04HI-9-7462 N)

For: Tiller Ranger District, Umpqua National Forest

By: Shaner Engineering, Inc. P.O. Box 1430 Roseburg, Oregon

January, 1981

Found 1" Iron Pipe. Set Brass cap in its place mkd. T30S, RIW, W.M. S29, S30, S31, S32, R.L.S. 430, 1981 From which a:

20" Douglas Fir snag, original BT Scribes visible Bears N46°W, 19.8 ft.

25" Douglas Fir stump, original BT Partial Face Bears N47°E, 13.2 ft. (U.S.G.L.O. Record N20°E) (Markham Record, 1961, N47°E)

22" White Fir BT Scribes visible Bears S29°W, 8.7 ft.

30" Douglas Fir BT Bark scribes visible Bears S6°W, 38.0 ft.

32" White Fir stump BT Face visible Bears N55°E, 31.7 ft.

16" Douglas Fir BT Scribes visible Bears N8°W, 96.0 ft.

6" Douglas Fir BT, I scribed T30S, RIW, S29, BT Bears N74°E, 25.1 ft.

6" Douglas Fir BT, I scribed T30S, RIW, S32, BT Bears S68°E, 8.1 ft.

Set Brass cap mkd. T30S, RIW, W.M. 1/4, S29, S32, R.L.S. 430, 1981 From which a:

18" Douglas Fir, I scribed 1/4, S29 BT Bears N54 1/2°W, 48.5 ft.

18" Douglas Fir, I scribed 1/4, S32 BT Bears S5°E, 41.7 ft.

FILED BS RECEIVED BS FEB 12 1981 COUNTY SURVEYOR DOUGLAS COUNTY, ORE BS

Found Brass cap mkd. T30S, RIW, W.M. S20, S21, S28, S29 County Surveyor, 1967 From which a: 30" Douglas Fir snag, original BT Scribes visible Bears N62°W, 23.0 ft. (County Record N60°W, 21.8 ft.) 12" Cedar windfall, original BT Burnt out face Bears S2°E, 50.8 ft. 26" Cedar BT Scribes visible Bears S3 1/2°E, 72.2 ft. 24" Cedar BT Scribes visible Bears S53°W, 39.5 ft. 34" Douglas stump BT Scribes visible Bears N81°W, 68.0 ft. 14" Madrone BT Scribes visible Bears N79°E, 25.6 ft. 10" Cedar BT, I scribed T30S, RIW, S20 BT Bears N33°W, 37.7 ft.

U. S. Section 29, T30S, RIW, W.M.

20 21 29 28

S0°11'54.9"W, 2680.03 (816.873 m.) (U.S.G.L.O. Record, Hathorn, 1857, South, 2640.00) (Briggs Record, 1889, South, 2659.80)

1/4 S 29 28 PRIVATE

Set Brass cap mkd. T30S, RIW, W.M. 1/4, S28, S29 R.L.S. 430, 1981 From which a: 12" Douglas Fir BT, I scribed 1/4, S28 BT Bears N34°E, 19.0 ft. 10" Douglas Fir BT, I scribed 1/4, S29 BT Bears N38 1/2°W, 30.6 ft.

S 89° 57' 25.8"W, 2698.08 (822.375 m.) (U.S.G.L.O. Record, Hathorn, 1857, N 89° 53' W, 2654.52)

1/4 S 29 32 PRIVATE

S 89° 57' 25.8"W, 2698.09 (822.378 m.) (U.S.G.L.O. Record, Hathorn, 1857, N 89° 53' W, 2654.52)

Found Brass cap mkd. T30S, RIW, W.M. S28, S29, S32, S33 County Surveyor, 1967 From which a: 22" Douglas Fir snag, original BT Scribes visible Bears N55°W, 25.7 ft. 48" Pine stub, original BT Bears S48°E, 23.8 ft. to face. 22" Douglas Fir BT Face visible Bears N25°W, 43.8 ft. 22" Cedar BT Scribes visible Bears N56°E, 28.2 ft. 16" Cedar BT Scribes visible Bears S28 1/2°E, 73.0 ft. (Record 73.6 ft.) 23" Cedar BT Good face Bears S8°W, 47.2 ft.

S 0°11'54.9"W, 2680.02 (816.870 m.) (U.S.G.L.O. Record, Hathorn, 1857, South, 2640.00) (Briggs Record, 1889, South, 2640.00)

29 28 31 32 33