


FOUND:
18\"/>

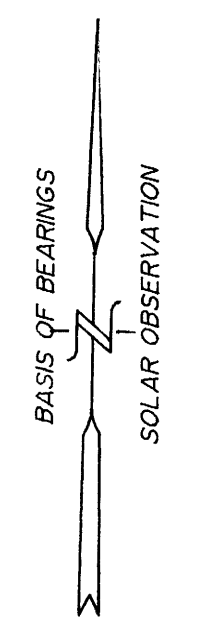

SURVEY TO SET PROPERTY CORNERS
SECTION 11, T.31S., R.5W., W.M.
DECEMBER, 1987 SCALE 1\"/>

FOR: HOWARD & RUTH MOORE
HC BI BOX 1 R
REEDSPORT, OR 97467
BY: BAUGHMAN TECHNICAL SERVICE INC.
433 S.E. MAIN STREET
ROSEBURG, OR 97470
PHONE 673-0966

NARRATIVE ACCOMPANIED ON SEPARATE DOCUMENT
SEE ADDITIONAL FILING.

REGISTERED
PROFESSIONAL
LAND SURVEYOR
Glenn S. Baughman
OREGON
GLENN S. BAUGHMAN
536

FOUND:
10\"/>

FOUND:
12\"/>

FOUND:
18\"/>

LEGEND
 ○ = Set 2\"/>