


• 2" diameter T.V. ANTENNA

FILED
Date: 1/14/2001 By: J.P.
This survey covers of:
Map: RM 4-8
Name:
Corner Pts:
DOUGLAS COUNTY
SURVEYOR

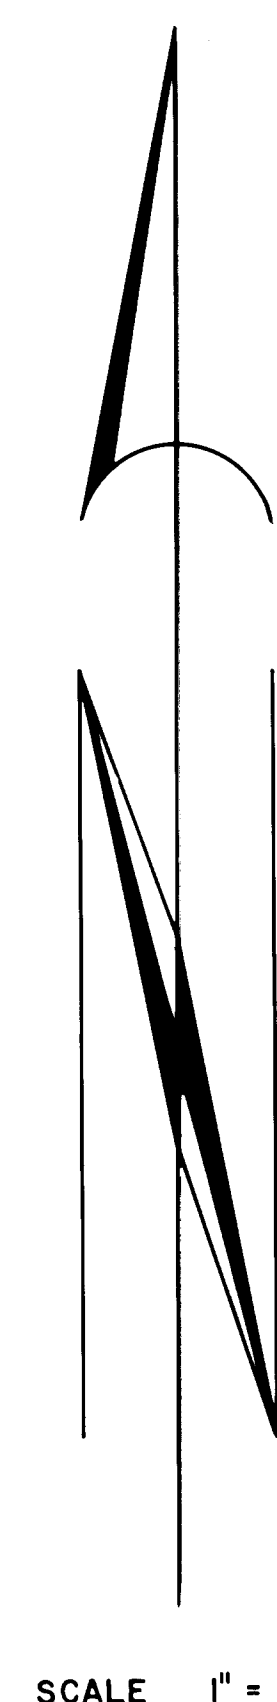

LEGEND

- GUY WIRE ANCHOR
- 12" diam. POLE
- 17" diam. POLE
- △ TRIANGULAR TOWER LEG
- ▲ TRAVERSE POINTS
- △ BRASS CAP
- DISH ANTENNA
- - - APPROX. UNDERGROUND POWER LOCATION
- - - APPROX. LOCATION OF BONNEVILLE POWER'S EASEMENT (PER VOL. 293 PAGE 139 D.C. CLERK'S OFFICE)

