


NW 1/4, NE 1/4, SEC. 17, T. 22 S., R. 5 W., W.M.

FILED
 Date: 4-18-2006 By: *xc*
 This survey consists of:
 Map: ST HWY 38-013A-C
 Narrative:
 Corner Rpt:
 DOUGLAS COUNTY
 SURVEYOR

REGISTERED
 PROFESSIONAL
 LAND SURVEYOR
Marshall R. Wagstaff
 OREGON
 JANUARY 9, 2001
 MARSHALL R. WAGSTAFF
 49476LS
 EXPIRES 06/30/06

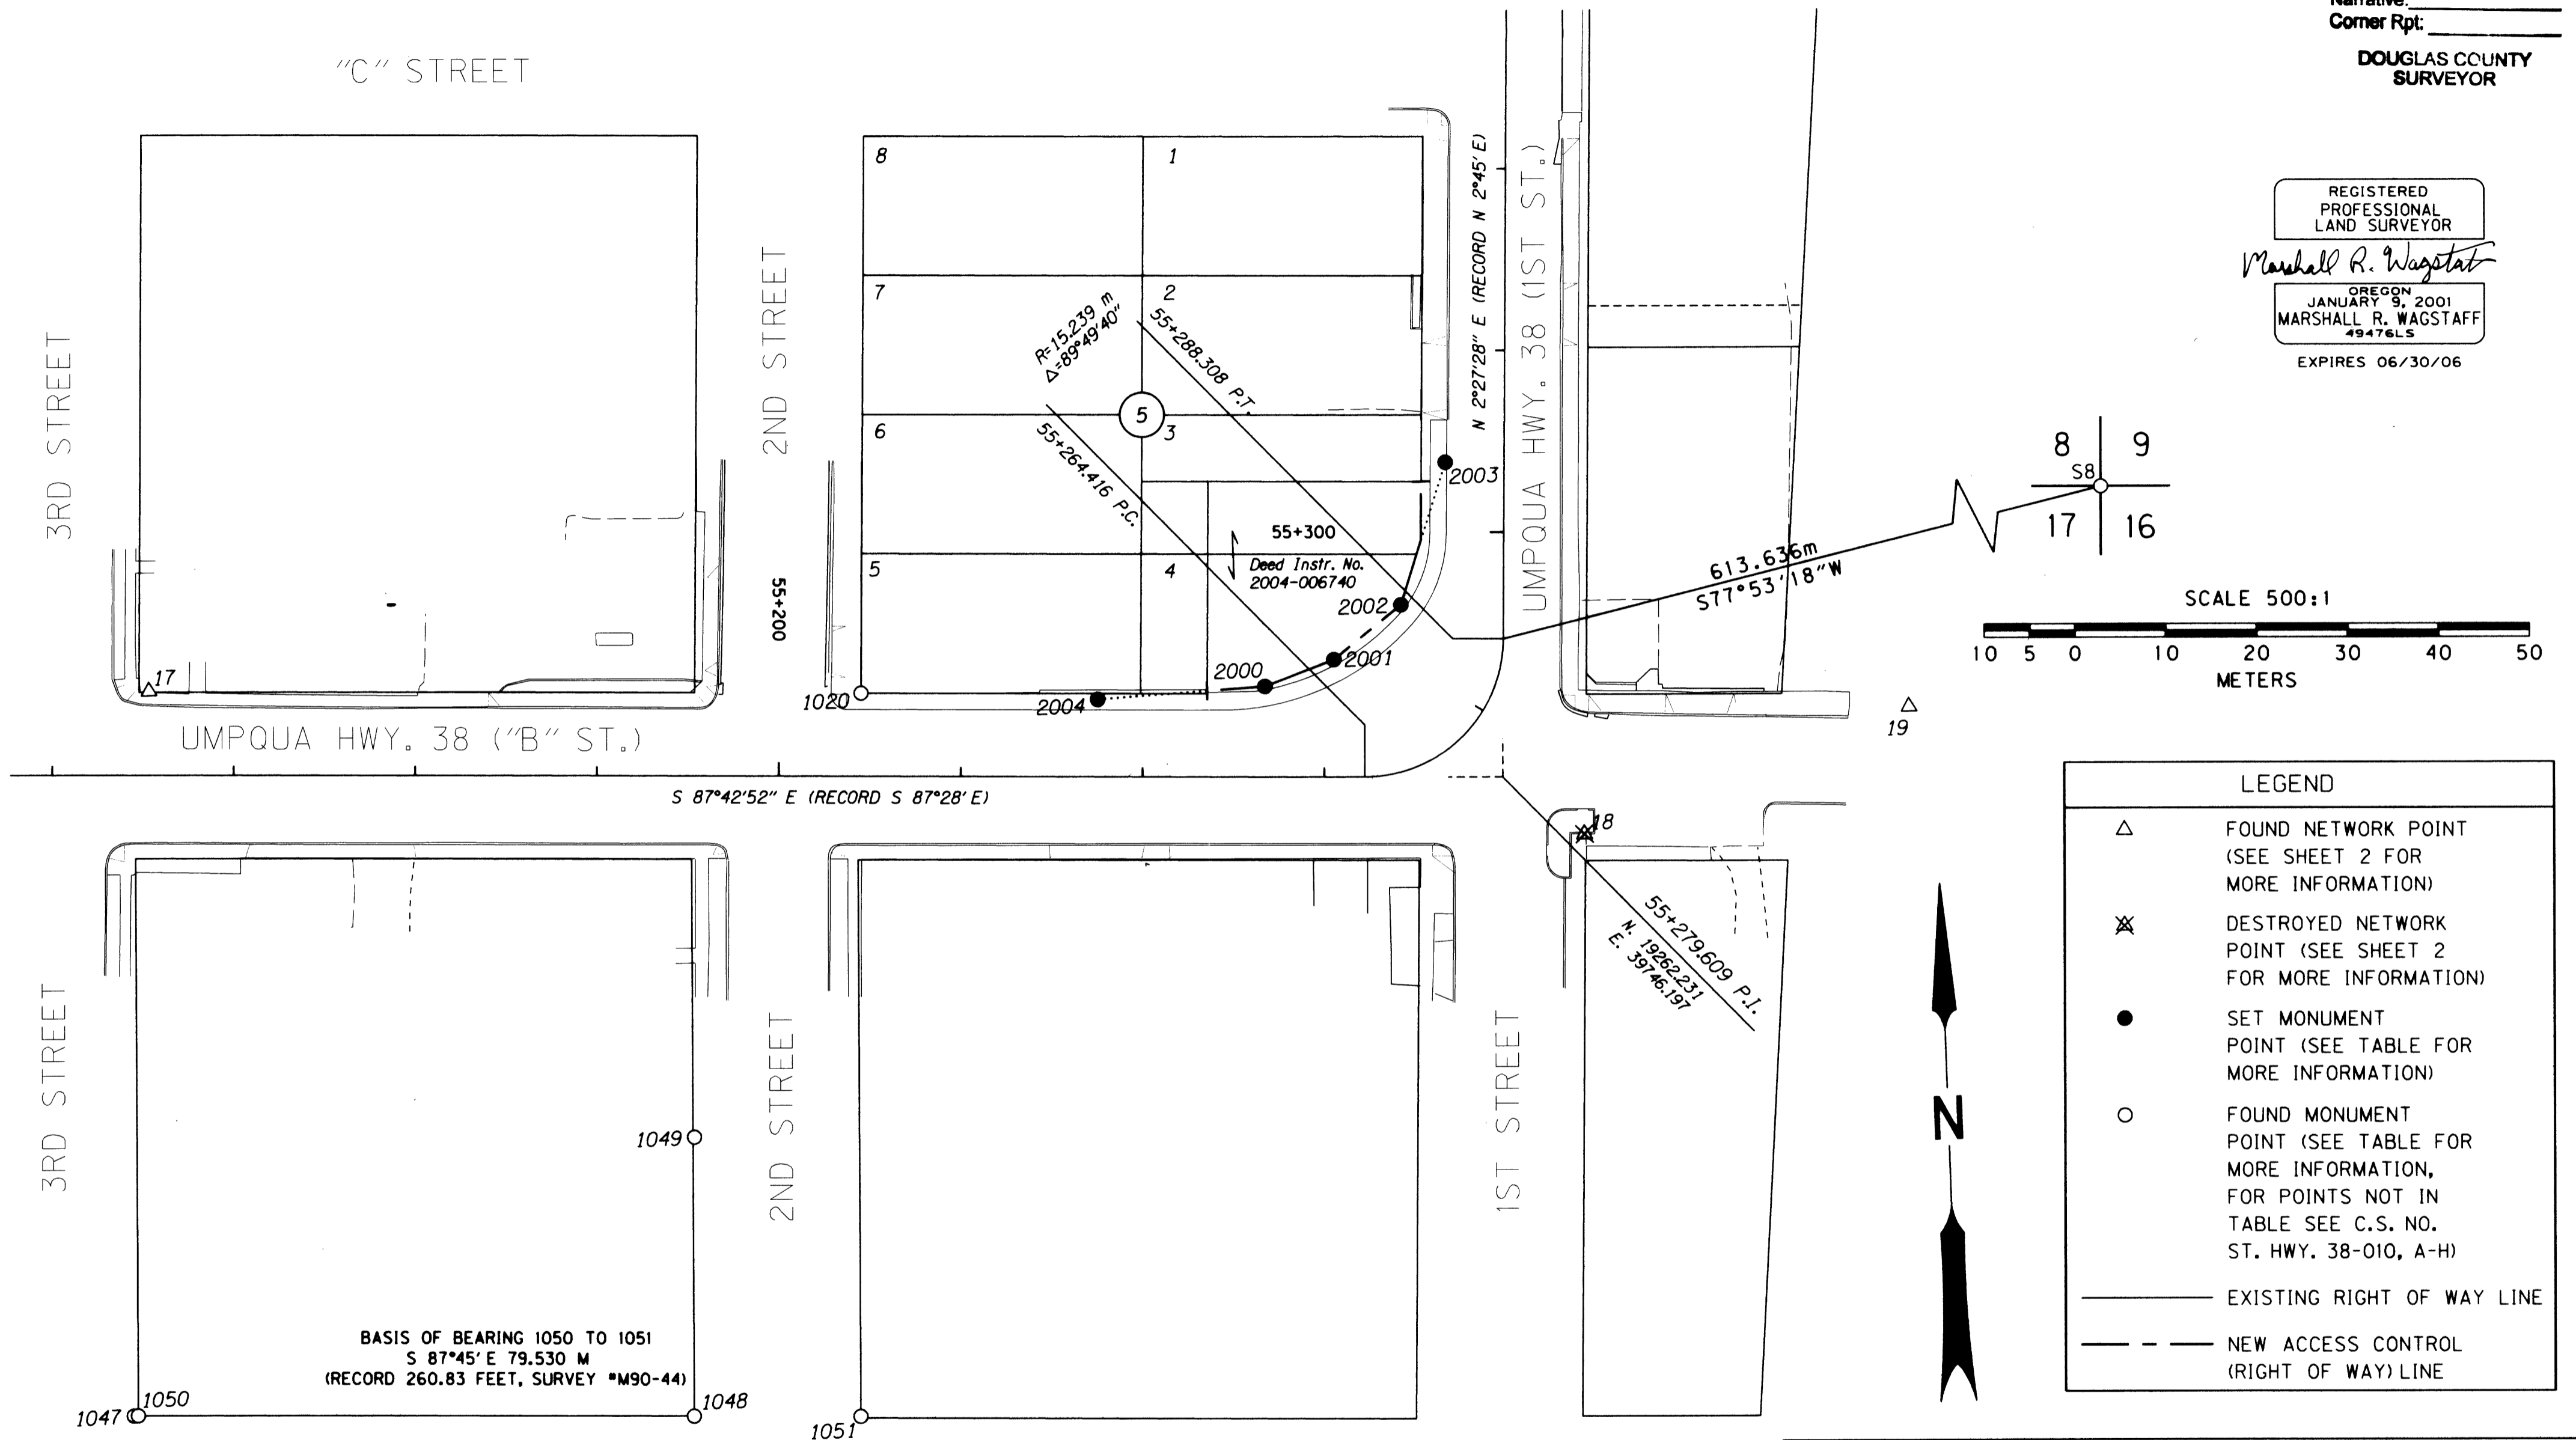

MONUMENT LIST

PT. NO.	LDP NORTHING	LDP EASTING	STATION	OFFSET	DESCRIPTION
2000	19273.212	39720.446	55+253.440	-9.945	SET 16 mm X 760 mm IRON REBAR W/ 38 mm ALUM. CAP STAMPED "ODOT RIGHT OF WAY"
2001	19275.863	39728.117	55+261.000	-12.900	SET 16 mm X 760 mm IRON REBAR W/ 38 mm ALUM. CAP STAMPED "ODOT RIGHT OF WAY"
2002	19281.584	39735.718	55+292.000	-11.300	SET 16 mm X 760 mm IRON REBAR W/ 38 mm ALUM. CAP STAMPED "ODOT RIGHT OF WAY"
2003	19297.043	39741.186	55+307.679	-6.500	SET 25 mm BRASS PLUG IN CONC. SIDEWALK STAMPED "ODOT CONTROL FC"
2004	19272.502	39702.000	55+235.037	-8.500	SET 25 mm BRASS PLUG IN CONC. SIDEWALK STAMPED "ODOT CONTROL FC"
S8	19406.161	40346.826			FOUND 32 mm O.D. IRON PIPE W/ 64 mm BRASS DISK STAMPED "COUNTY SURVEYORS OFFICE S8-S9-S17-S16, T22S, R5W", 60 mm ABOVE SURFACE, GOOD CONDITION

NOTES: 1) POINTS 2003 & 2004 ARE FALSE CALL POINTS WHICH DEFINE THE RIGHT OF WAY LINE DIRECTION BUT NOT DISTANCE
 2) OFFSETS WITH A - (MINUS) ARE LEFT, WITHOUT ARE RIGHT

METRIC SURVEY OREGON DEPARTMENT OF TRANSPORTATION
 RIGHT-OF-WAY BOUNDARY MONUMENTATION MAP
 OR38: HANCOCK CREEK - LAUREL HILLS DRIVE
 UMPQUA HIGHWAY
 DOUGLAS COUNTY
 KEY NO. 10966
 FOR ODOT REGION 3
 3500 NW STEWART PKWY., STE. 164
 ROSEBURG, OR 97470
 APRIL 14, 2006
 SCALE: 500:1
 SHEET 3 OF 3

ST. HWY 38-013 C