

Date: 1-15-2009 By: JC  
 This survey consists of:  
 Map: ST HWY 38-017A-I  
 Narrative: \_\_\_\_\_  
 Corner Rpt: \_\_\_\_\_  
**DOUGLAS COUNTY**  
**SURVEYOR**

NOTE:  
 FOR PURPOSES OF THIS SURVEY,  
 "HELD" DENOTES RECOVERED  
 MONUMENT POSITION WITHIN 0.2' OF  
 CALCULATED ALIGNMENT POSITION.

SEE SHEET 7

6°00'02" C.R.  
 R = 954.83'  
 Δ = 47°17'47"  
 T = 418.11' } CALC.

6° C.R.  
 Δ = 47°18'  
 T = 418.2' } OD 4B-16-12

"4B" 1203+34.50 P.O.T. AH = EQ.

HELD #1033  
 AS 40' LT.  
 OF P.T.

HELD #1032  
 AS 40' RT.  
 OF P.T.

HELD #1035  
 AS 40' RT. OF  
 "4B" 1205+00

HELD #1034  
 AS 50' RT. OF  
 "4B" 1205+00

HELD #1037  
 AS 50' RT. OF  
 "4B" 1207+00

HELD #1038  
 AS 50' RT.



1205+00

1040  
1039

EQ. "4B" 1212+69.80 P.C. AH =  
 N. 736.6447390  
 E. 4122.920233  
 P.O.T. BK

N 85°03'50" E 739.40 - HELD PER OD 4B-16-12  
 (N 82°58' E OD 4B-16-12)

UMPQUA HWY. NO. 45 (OR 38)

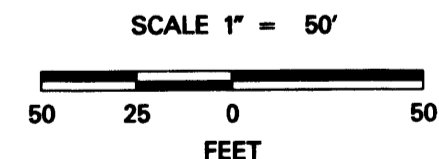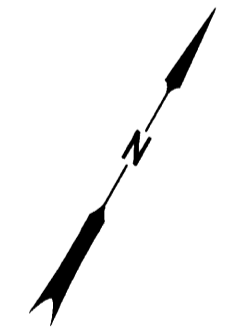

LEGEND	
△	FOUND NETWORK POINT AS DESCRIBED ON SHEET 9
▲	SET NETWORK POINT AS DESCRIBED ON SHEET 3
○	FOUND MONUMENT AS DESCRIBED ON SHEET 9
---	EDGE OF PAVEMENT
CALC.	DENOTES CALCULATED VALUE
OD	DENOTES ODOT DRAWING
"4B"	DENOTES ODOT CONSTRUCTED LINE DRAWING NO. 4B-16-12

REGISTERED  
 PROFESSIONAL  
 LAND SURVEYOR  
  
 OREGON  
 JULY 15, 1983  
 JOHN A. CARLSON  
 2044  
 RENEWS 12/31/09



FILE NAME: 14221\_01601RET.DGN

OREGON DEPARTMENT OF TRANSPORTATION  
 HORIZONTAL CONTROL, RECOVERY AND RETRACEMENT SURVEY  
 FOR ODOT THROUGH THE OREGON BRIDGE DELIVERY PARTNERS (OBDP)  
 OR 38: ELK CR. - HARDSCRABBLE CR. (D/B) - BUNDLE 401  
 DOUGLAS COUNTY, OREGON

17355 SW BOONES FERRY RD.  
 LAKE OSWEGO, OREGON 97035  
 PHONE: (503) 635-3618  
 FAX: (503) 635-5395  
 www.otak.com

DECEMBER 12, 2008  
 KEY NO. 14221  
 PROJ. NO. 13855-9  
 SCALE: 1" = 50'  
 SHEET 8 OF 9