


Sec. 20, 29, T22S, R7W

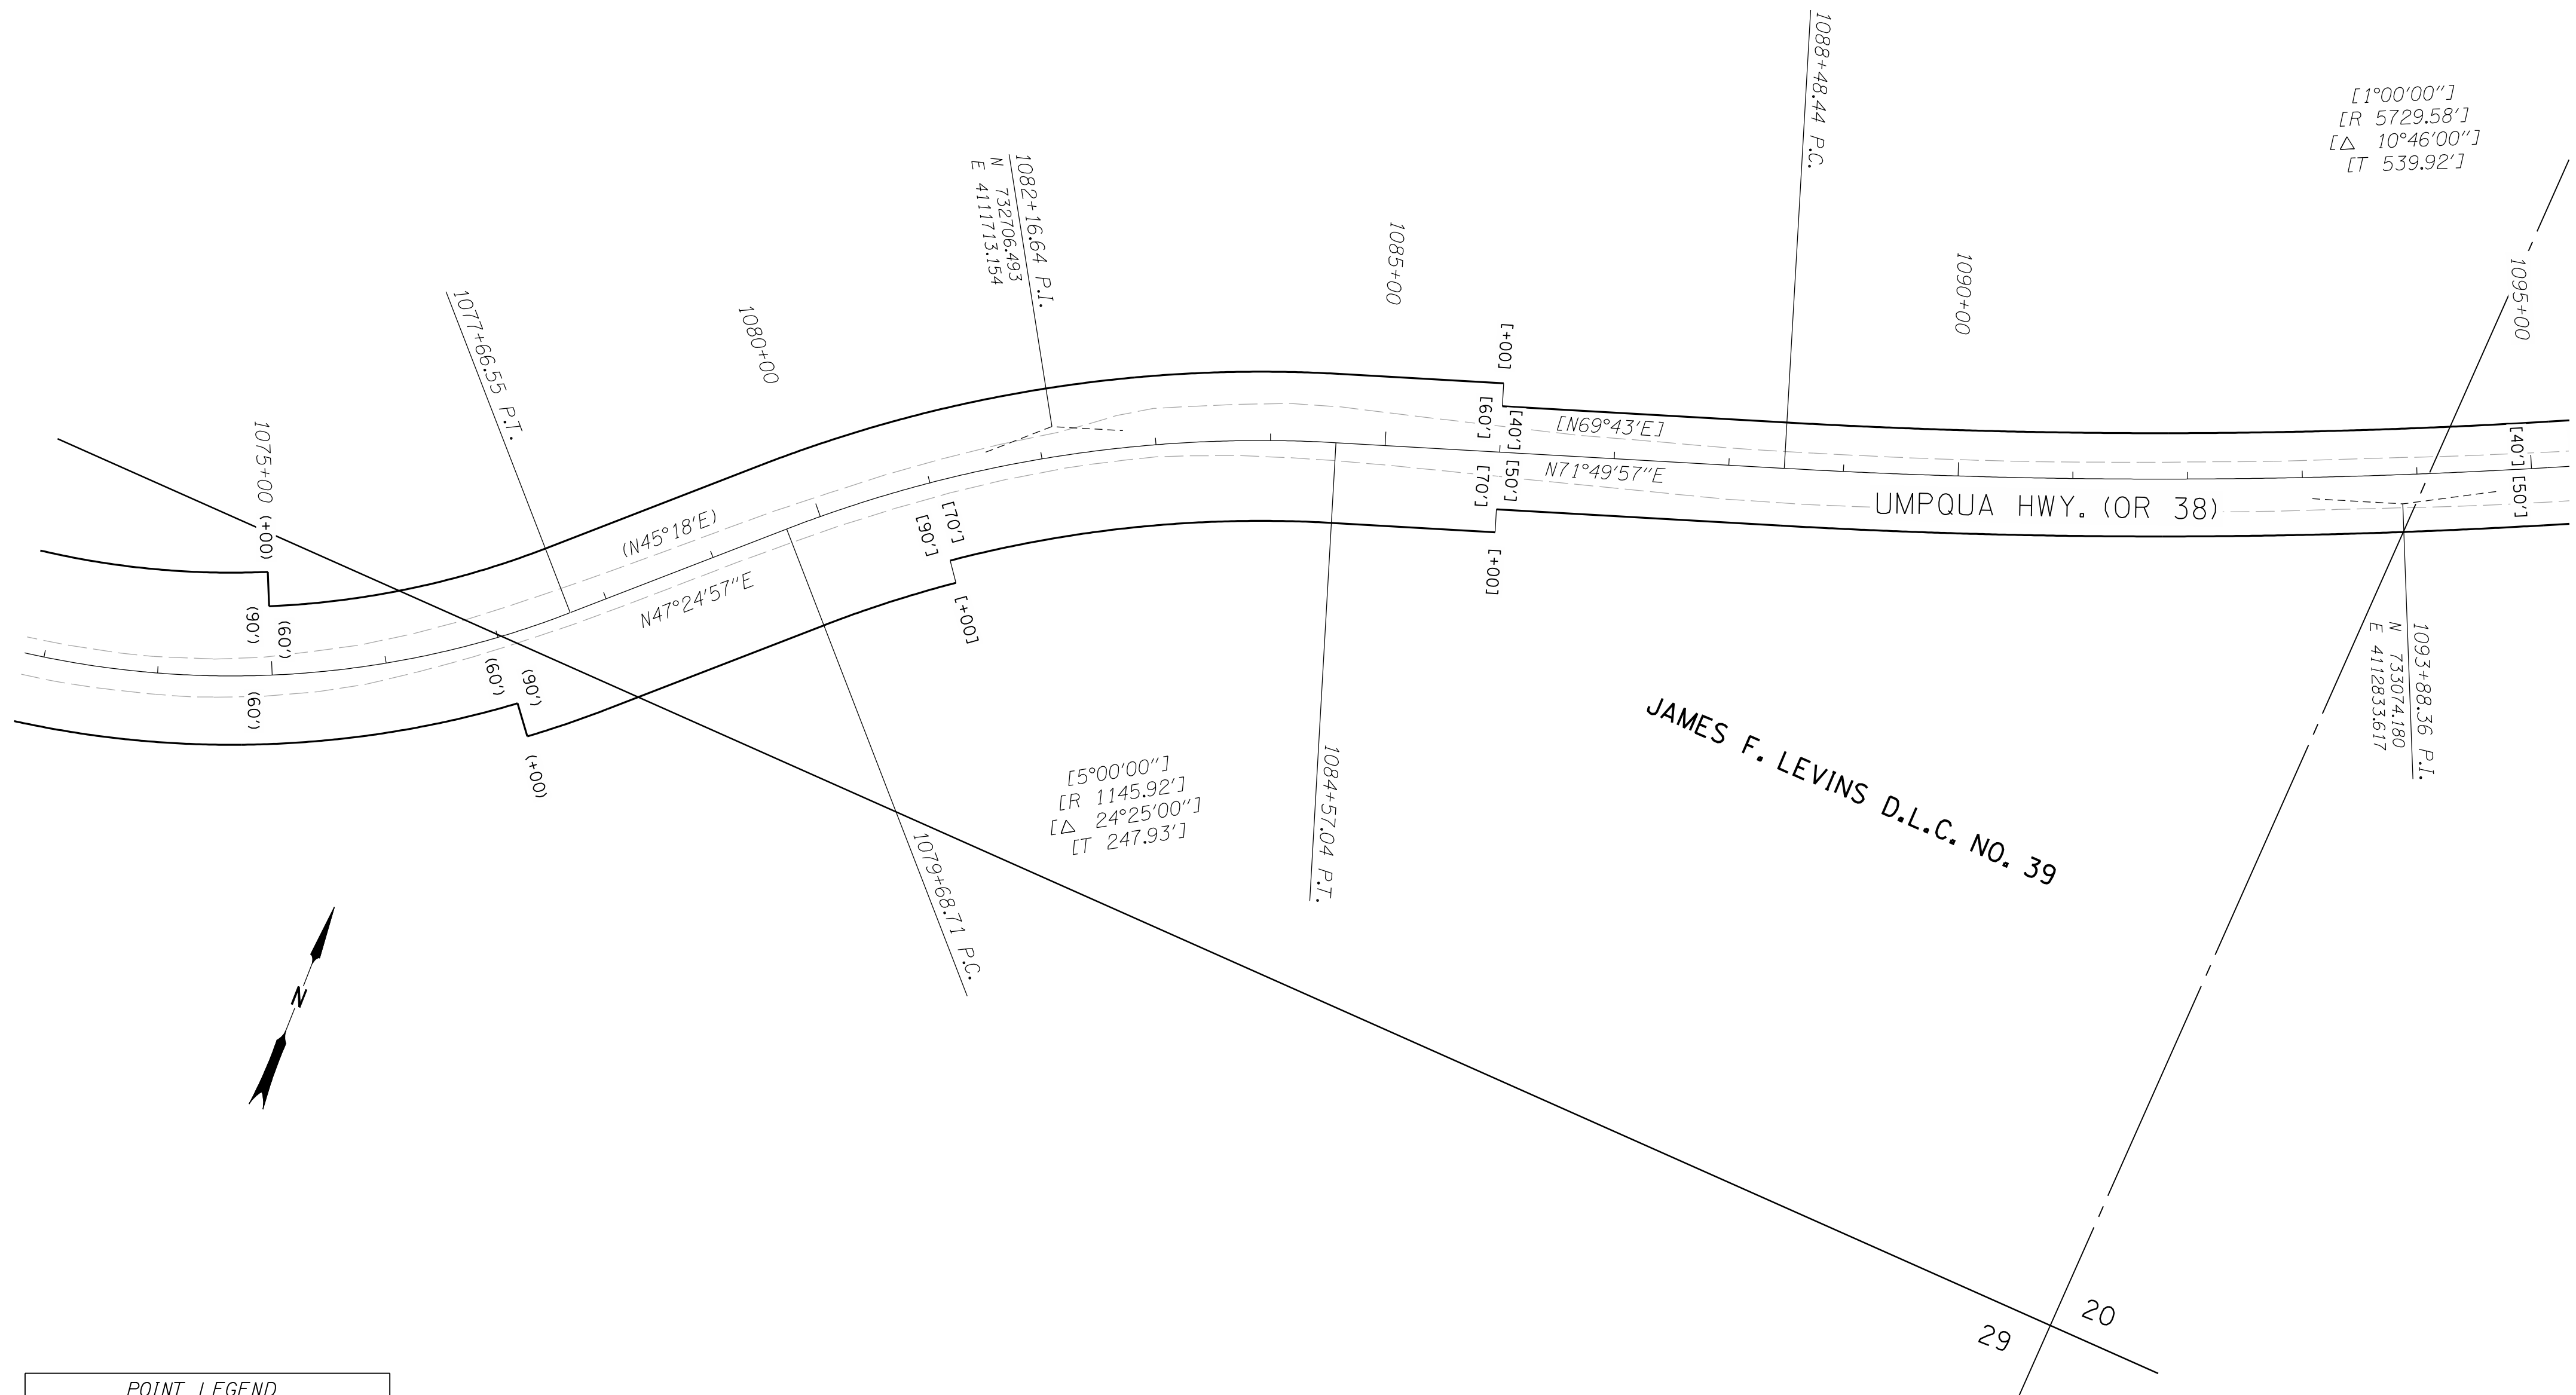


POINT LEGEND

- FOUND MONUMENT
- ☆ FOUND GPS STATION *
- ▲ SET NETWORK POINT *
- SET STRATEGIC POINT *
- ⊕ FOUND BENCH MARK *
- ⊗ DESTROYED BENCH MARK *

* CONTROL MONUMENT TABLE & BOUNDARY LINE LEGEND ON SHEET 3

RECORD DATA

()	PER ODOT DRG. 1B-22-23 & 2B-26-14
(())	PER ODOT DRG. 9B-34-17
[]	PER ODOT DRG. 4B-16-12
NO BRACKET	MEASURED/RESOLVED SUPERCEDES RECORD

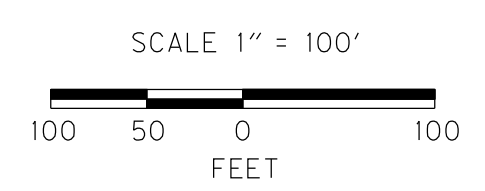

SI FEET OREGON DEPARTMENT OF TRANSPORTATION

HORIZONTAL CONTROL, RECOVERY AND RETRACEMENT MAP
 OR 38: ELKTON SLIDE - HANCOCK MOUNTAIN ROAD PAVING
 UMPQUA HWY. NO. 45, OR 38, M.P. 31.74 - 38.09
 DOUGLAS COUNTY
 FILE:13802RW.DGN MODEL:SHEETS

FOR ODOT REGION 3
 3500 NW. STEWART PKWY.
 ROSEBURG, OR. 97470

AUGUST 3, 2010
 SCALE: 1" = 100'
 SHEET 8 OF 9