



SE 1/4 SECTION 11 T22S R7W WM S 1/2 SECTION 12 T22S R7W WM

FILED

Date: 8-21-2019 By: Qi  
 This survey consist of:  
 Map: St. Hwy 38-024 A-C  
 Narrative:  
 Corner Rpt: DOUGLAS COUNTY SURVEYOR

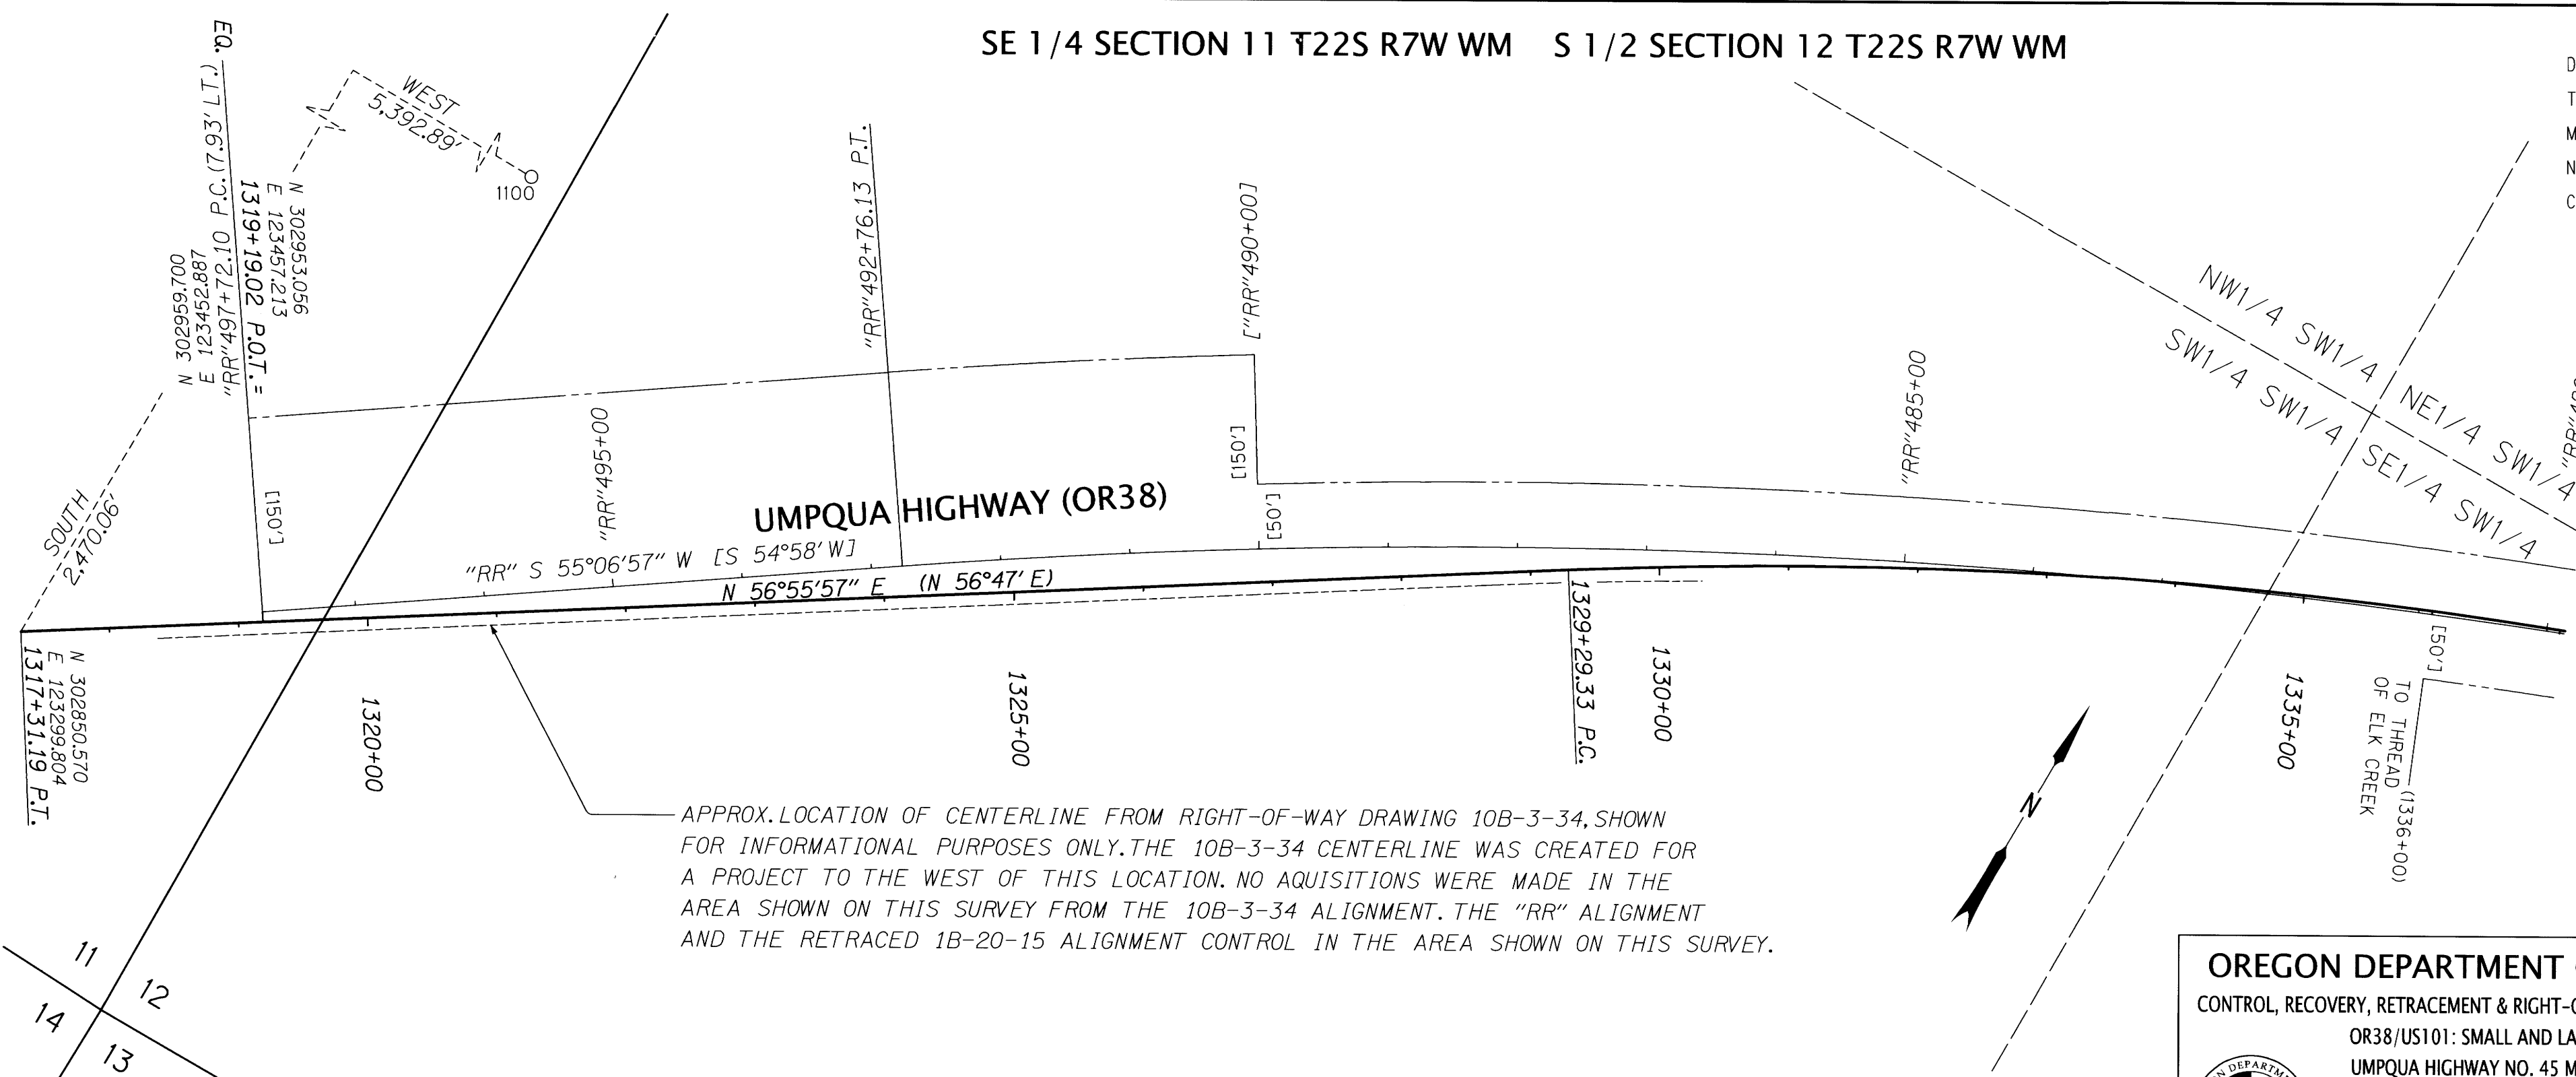


FOR LINE LEGEND SEE SHEET 1

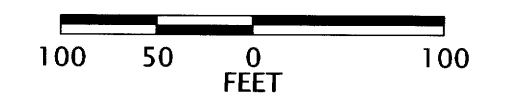

**OREGON DEPARTMENT OF TRANSPORTATION**  
 CONTROL, RECOVERY, RETRACEMENT & RIGHT-OF-WAY BOUNDARY MONUMENTATION MAP  
 OR38/US101: SMALL AND LARGE CULVERT UPGRADES  
 UMPQUA HIGHWAY NO. 45 M.P. 41.98 (GREEN CREEK)  
 DOUGLAS COUNTY  
 FILE: 19737RW.DGN :: RWM

ODOT REGION 3 TECH CENTER  
 3500 NW STEWART PKWY.  
 ROSEBURG, OR 97470 KEY No. 19737


AUGUST 20, 2019  
 SCALE: 1" = 100'  
 SHEET 2 OF 3

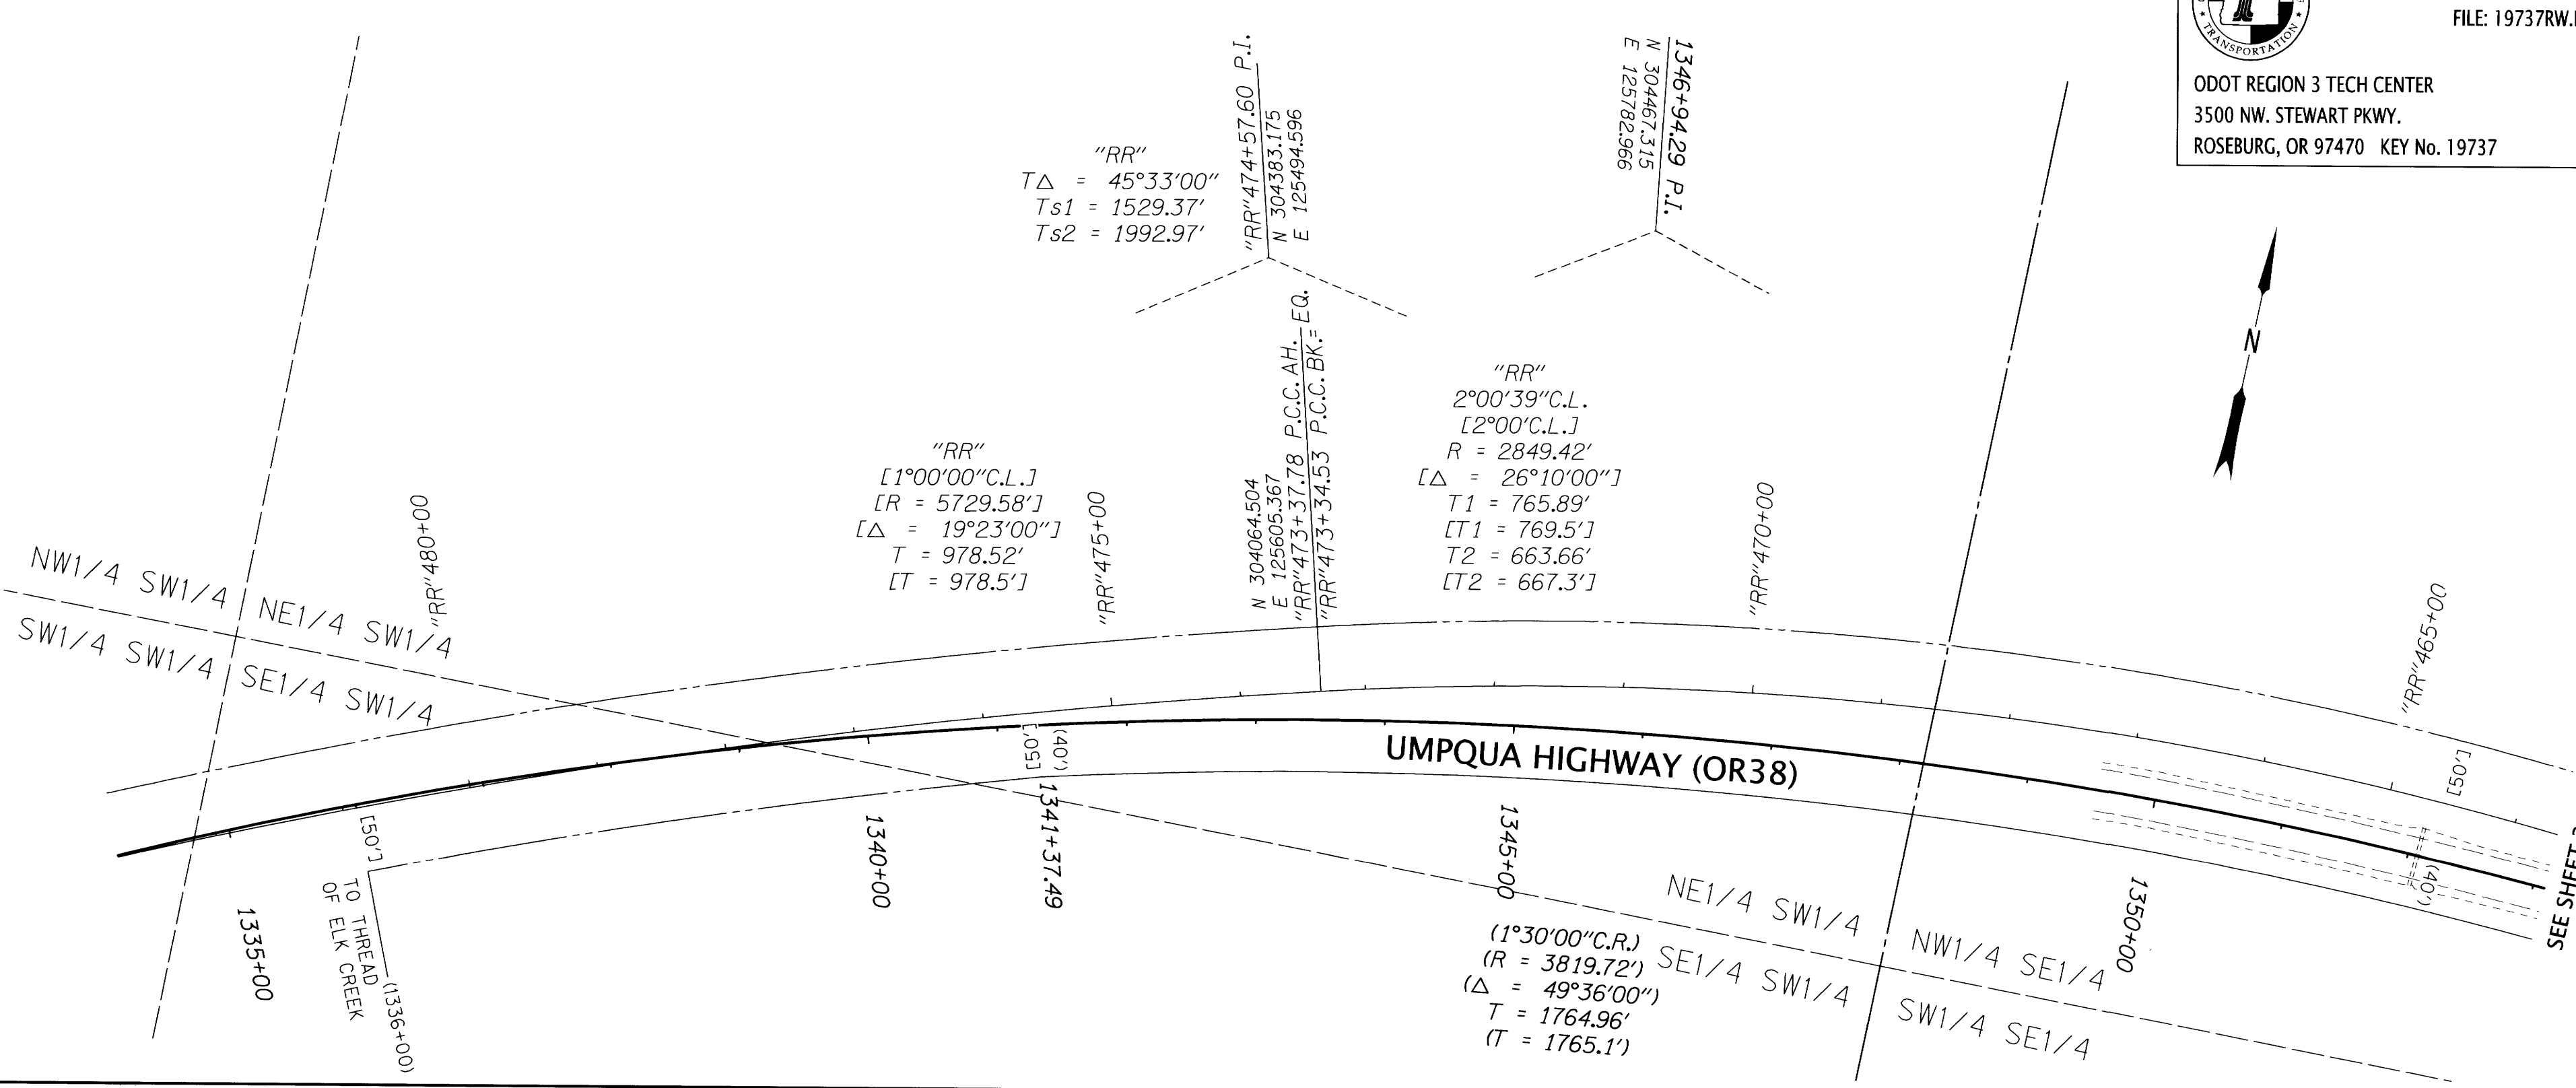

RECORD DATA FROM DRG. 1B-20-15

( )	HIGHWAY CENTER LINE
[ ]	RR CENTER LINE
NO BRACKET	MEASURED/RESOLVED SUPERCEDES RECORD

FOR LINE LEGEND SEE SHEET 1

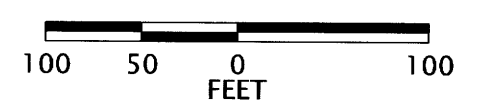

REGISTERED PROFESSIONAL LAND SURVEYOR

*Mickey D. Calvert*  
 OREGON  
 NOVEMBER 10, 2011  
 MICKEY D. CALVERT  
 75099

RENEWS: 12-31-2019

ST. HWY. 38-024 B