


SE 1/4 SEC 8 T22S R5W WM
NE 1/4 SEC 17 T22S R5W WM

FILED
Date: 4-12-2022 By: DE
This survey consists of:
Map: ST HWY 38-028AF
Narrative:
Corner Rpt:
DOUGLAS COUNTY
SURVEYOR

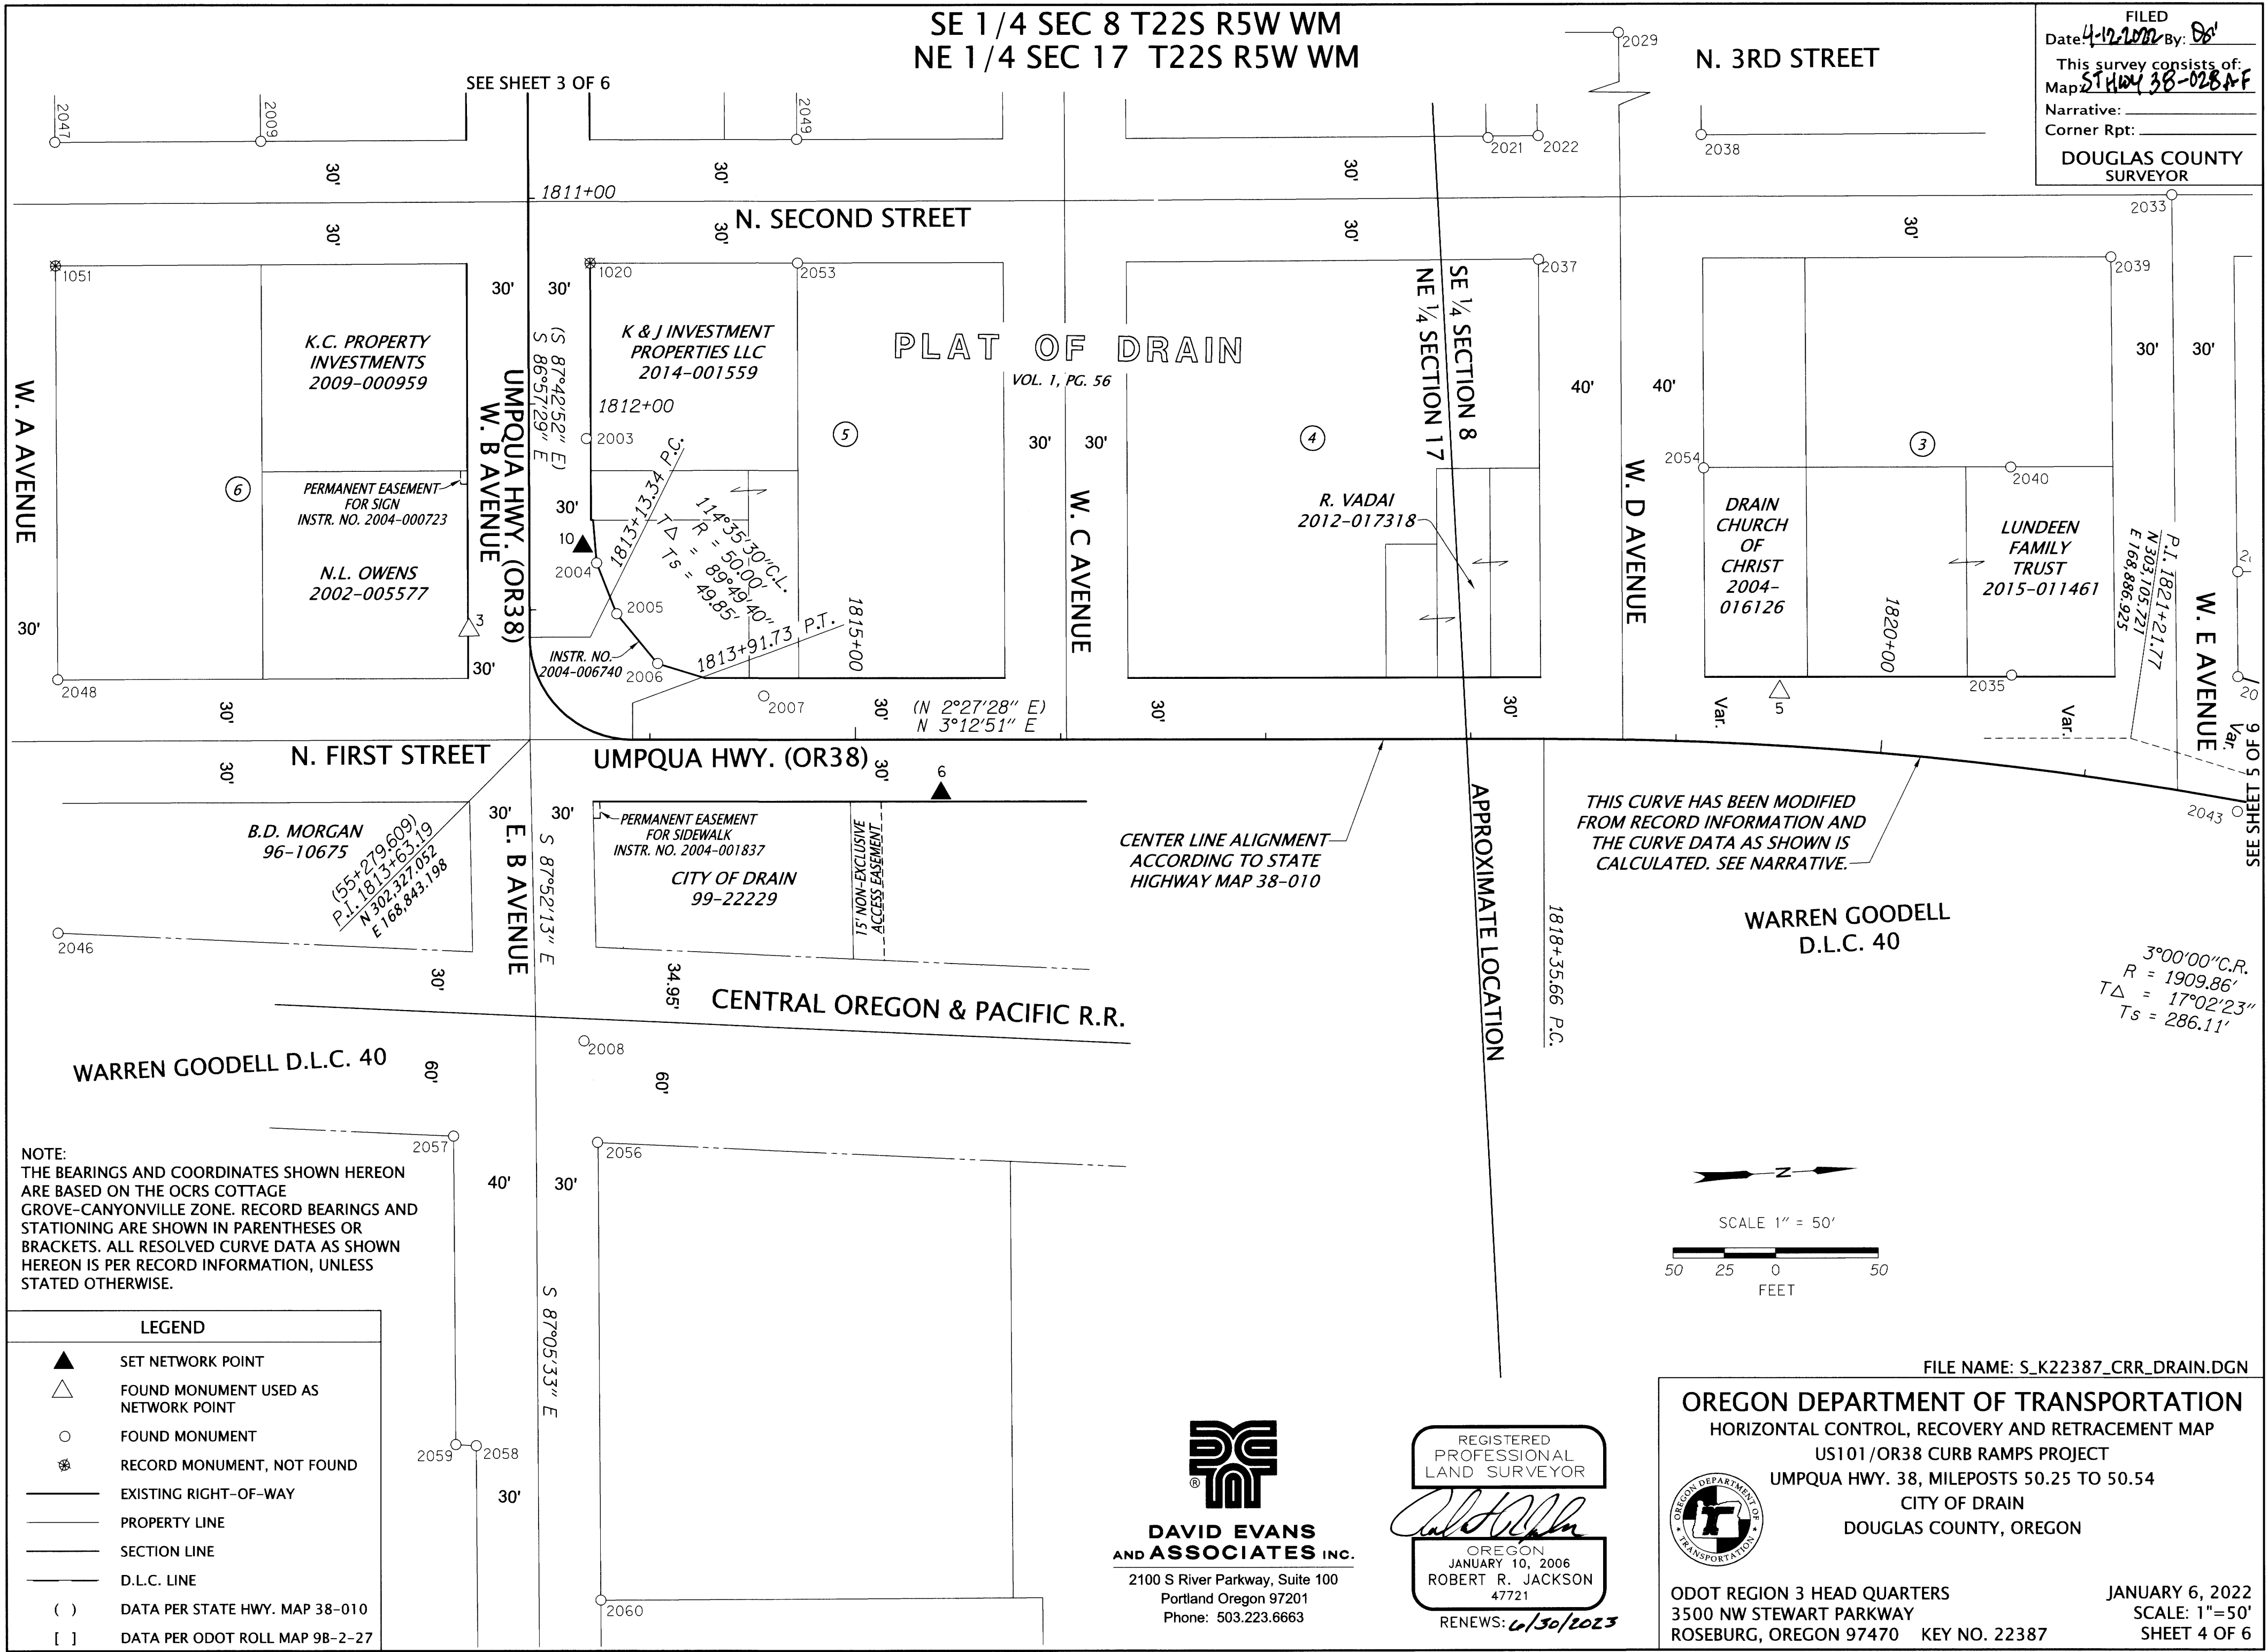

NOTE:
THE BEARINGS AND COORDINATES SHOWN HEREON
ARE BASED ON THE OCRS COTTAGE
GROVE-CANYONVILLE ZONE. RECORD BEARINGS AND
STATIONING ARE SHOWN IN PARENTHESES OR
BRACKETS. ALL RESOLVED CURVE DATA AS SHOWN
HEREON IS PER RECORD INFORMATION, UNLESS
STATED OTHERWISE.

LEGEND	
▲	SET NETWORK POINT
△	FOUND MONUMENT USED AS NETWORK POINT
○	FOUND MONUMENT
⊛	RECORD MONUMENT, NOT FOUND
—	EXISTING RIGHT-OF-WAY
—	PROPERTY LINE
—	SECTION LINE
—	D.L.C. LINE
()	DATA PER STATE HWY. MAP 38-010
[]	DATA PER ODOT ROLL MAP 9B-2-27

DAVID EVANS AND ASSOCIATES INC.
2100 S River Parkway, Suite 100
Portland Oregon 97201
Phone: 503.223.6663

REGISTERED PROFESSIONAL LAND SURVEYOR
Robert R. Jackson
OREGON
JANUARY 10, 2006
ROBERT R. JACKSON
47721
RENEWS: 6/30/2023

FILE NAME: S_K22387_CRR_DRAIN.DGN
OREGON DEPARTMENT OF TRANSPORTATION
HORIZONTAL CONTROL, RECOVERY AND RETRACEMENT MAP
US101/OR38 CURB RAMPS PROJECT
UMPQUA HWY. 38, MILEPOSTS 50.25 TO 50.54
CITY OF DRAIN
DOUGLAS COUNTY, OREGON
ODOT REGION 3 HEAD QUARTERS
3500 NW STEWART PARKWAY
ROSEBURG, OREGON 97470 KEY NO. 22387
JANUARY 6, 2022
SCALE: 1"=50'
SHEET 4 OF 6