


SE 1/4 SEC. 20, T.28S., R.6W., W.M.

FILED
Date: 6-27-2007 By: JP
This survey consists of: 7 Pgs
Map: 42-012 C
Narrative: _____
Corner Rpt: _____
DOUGLAS COUNTY
SURVEYOR

John Cox
DLC 49
James Belieu
DLC 52

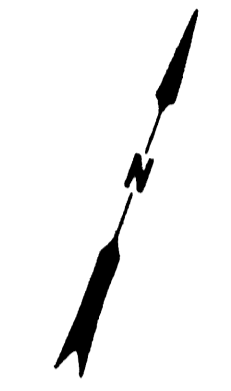

1446+00.00 P.O.T.
N. 542.419.537
E. 1219.248.571

1450

WINSTON CITY LIMITS

1527
O

1455


WINSTON CITY LIMITS
N. 70°27'50" E.

COOS BAY - ROSEBURG HWY. (OR42)

WINSTON CITY LIMITS

LEGEND	
✕	DESTROYED NETWORK POINT
△	FOUND NETWORK POINT
○	FOUND MONUMENT

SEE LINE LEGEND &
MONUMENT TABLE
ON SHEET 2

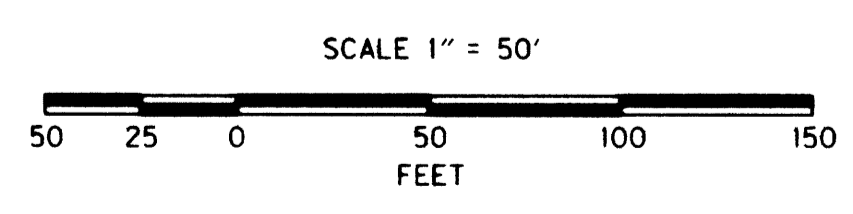

REGISTERED
PROFESSIONAL
LAND SURVEYOR
Marshall R. Wagstaff
OREGON
JANUARY 9, 2001
MARSHALL R. WAGSTAFF
49476LS
EXPIRES 06/30/08

OREGON DEPARTMENT OF TRANSPORTATION
RIGHT-OF-WAY BOUNDARY MONUMENTATION MAP
OR42: LOOKINGGLASS CR. - GLENHART AVE.
COOS BAY - ROSEBURG HWY. (42)
DOUGLAS COUNTY FILE: 12731RW.DGN

FOR ODOT REGION 3
3500 NW. STEWART PKWY.
ROSEBURG, OR. 97470

JUNE 26, 2007
SCALE: 1" = 50'
SHEET 3 OF 7