


SEC. 25, T.28S., R.7W., W.M.

FILED
 Date: 4-3-2009 By: JC
 This survey consists of:
 Map: SHW 42-014A-N
 Narrative:
 Corner Rpt:
 DOUGLAS COUNTY
 SURVEYOR


NE1/4 SW1/4 SEC. 25

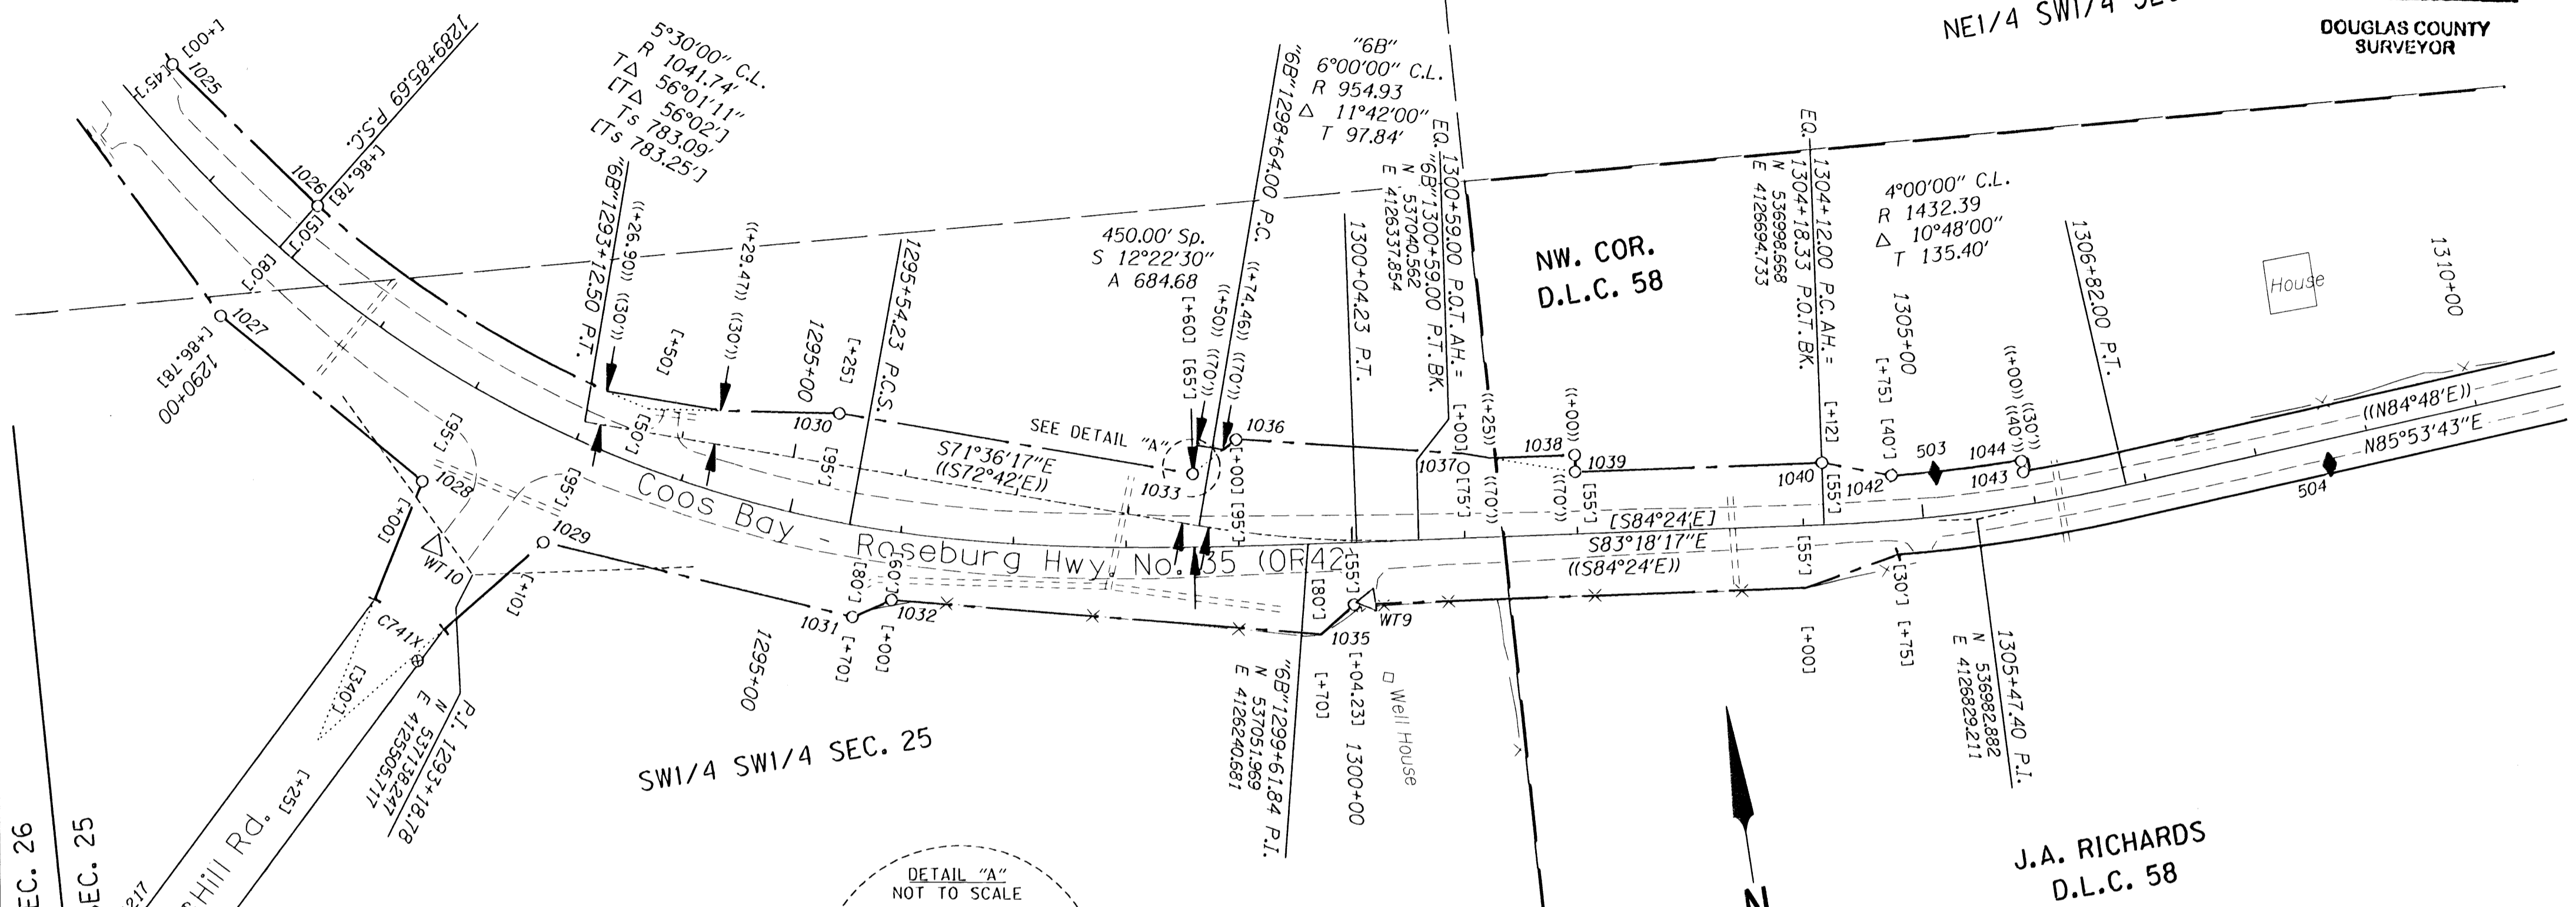

SEC. 26
 SEC. 25


Hoover Hill Rd.
 1216
 1217
 1218
SW1/4 SW1/4 SEC. 25

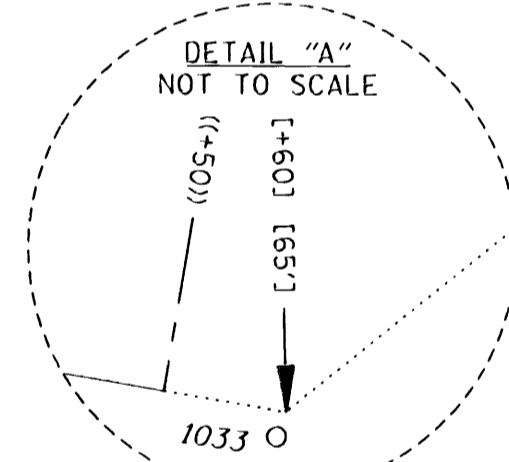

SEE CONTROL MONUMENT TABLE ON SHEET 1

SEE LINE LEGEND ON SHEET 3

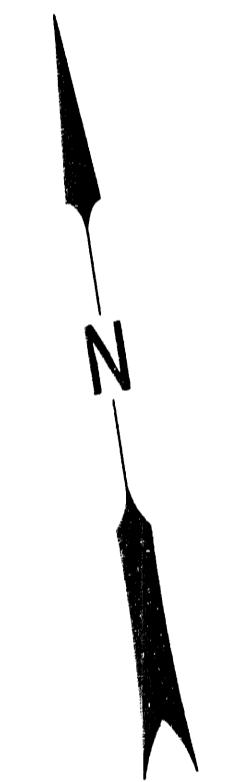


J.A. RICHARDS
 D.L.C. 58

RECORD DATA	
()	PER ODOT R/W DRG. 10B-8-11
(())	PER ODOT R/W DRG. 6B-28-22
[]	PER ODOT R/W DRG. 10C-54-2
[[]]	PER ODOT R/W DRG. 9B-34-12

POINT LEGEND	
○	FOUND MONUMENT
⊕	FOUND BENCH MARK
⊙	SET BENCH MARK
△	FOUND ODOT NETWORK OR TRAVERSE POINT
◆	SET STRATEGIC POINT

RECOVERED MONUMENTS

PT. ID.	LDP NORTHING	LDP EASTING	ELEV.	LINE	STATION	OFFSET (- IS LEFT)	DATE	DESCRIPTION	REFERENCE
1028	537482.027	4125419.951			1289+88.82	-50.01	8/28/2008	FD. 5/8" I. REBAR W/ 1 1/4" PLASTIC CAP STAMPED "OREGON STATE HIGHWAY DIV." 0.3 FT. ABOVE SURFACE GOOD COND. RW STATION 1289+88.78 PSC 50 LT	10C-54-2
1027	537399.021	4125319.940			1289+88.78	79.98	8/28/2008	FD. 5/8" I. REBAR W/ 1 1/4" PLASTIC CAP STAMPED "OREGON STATE HIGHWAY DIV." 0.1 FT. ABOVE SURFACE GOOD COND. PADDLE BOARD NEARBY MARKED "SHRW 1284+00 POT 80 RT" CORRECT RW STATION IS 1289+88.78 PSC	10C-54-2
1028	537228.888	4125474.224			1291+99.93	95.00	8/28/2008	FD. 5/8" I. REBAR W/ 1 1/4" PLASTIC CAP STAMPED "OREGON STATE HIGHWAY DIV." 0.4 FT. BELOW SURFACE GOOD COND. PADDLE BOARD NEARBY MARKED "SHRW 1292+00 POC 95 RT"	10C-54-2
1029	537157.002	4125571.855			1293+10.01	95.14	8/28/2008	FD. 5/8" I. REBAR W/ 1 1/4" PLASTIC CAP STAMPED "OREGON STATE HIGHWAY DIV." 0.3 FT. BELOW SURFACE GOOD COND. PADDLE BOARD NEARBY MARKED "SHRW 1293+10 POC 95 RT"	10C-54-2
1030	537229.818	4125848.384		"6B"	1295+33.45	-44.98	8/24/2008	FD. 5/8" I. REBAR W/ 1 1/4" PLASTIC CAP STAMPED "OREGON STATE HIGHWAY DIV." 0.3 FT. BELOW SURFACE GOOD COND. STINGER NEARBY.	10C-54-2
1031	537050.107	4125832.178			1295+69.92	80.14	8/28/2008	FD. 5/8" I. REBAR W/ 1 1/4" PLASTIC CAP STAMPED "OREGON STATE HIGHWAY DIV." 0.2 FT. BELOW SURFACE GOOD COND. PADDLE BOARD NEARBY MARKED "SHRW 1295+00 POS 80 RT"	10C-54-2
1032	537059.838	4125868.820			1295+99.94	60.12	8/28/2008	FD. 5/8" I. REBAR W/ 1 1/4" PLASTIC CAP STAMPED "OREGON STATE HIGHWAY DIV." 0.2 FT. BELOW SURFACE GOOD COND. BENT PADDLE BOARD NEARBY MARKED "SHRW 1298+00 POS 80 RT"	10C-54-2
1033	537129.045	4128149.265			1298+59.93	-84.84	8/28/2008	FD. 5/8" I. REBAR W/ 1 1/4" PLASTIC CAP STAMPED "OREGON STATE HIGHWAY DIV." 0.3 FT. BELOW SURFACE GOOD COND. PADDLE BOARD NEARBY MARKED "SHRW 1298+00 POS 85 LT"	10C-54-2
1035	536992.823	4128272.788			1299+99.94	55.00	8/28/2008	FD. 5/8" I. REBAR W/ 1 1/4" PLASTIC CAP STAMPED "OREGON STATE HIGHWAY DIV." FLUSH W/ SURFACE GOOD COND. PADDLE BOARD NEARBY MARKED "SHRW 1300+00 POS 55 RT"	10C-54-2
1038	537153.260	4128191.791			1298+59.99	-94.50	8/28/2008	FD. 5/8" I. REBAR W/ 1 1/4" PLASTIC CAP STAMPED "OREGON STATE HIGHWAY DIV." 0.3 FT. ABOVE SURFACE GOOD COND. PADDLE BOARD NEARBY MARKED "SHRW 1301+00 POT 75 LT"	10C-54-2
1037	537097.403	4128388.885	747.80		1301+01.07	-82.17	8/24/2008	FD. 5/8" I. REBAR W/ 1 1/4" PLASTIC CAP STAMPED "OREGON STATE HIGHWAY DIV." 0.2 FT. ABOVE SURFACE GOOD COND. PADDLE BOARD NEARBY MARKED "SHRW 1301+00 POT 75 LT"	10C-54-2
1038	537093.542	4128488.031			1301+99.99	-69.89	8/24/2008	FD. 5/8" I. ROD 0.15 FT. ABOVE SURFACE GOOD COND. RW STATION 1302+00 OFFSET UNKNOWN	10C-54-2
1039	537078.738	4128484.079			1301+99.78	-54.98	8/24/2008	FD. 5/8" I. REBAR W/ 1 1/4" PLASTIC CAP STAMPED "OREGON STATE HIGHWAY DIV." 0.1 FT. BELOW SURFACE GOOD COND. PADDLE BOARD NEARBY MARKED "SHRW 1302+00 POT 55 LT"	10C-54-2
1040	537053.293	4128701.147			1304+12.00	-55.00	8/24/2008	FD. 5/8" I. REBAR W/ 1 1/4" PLASTIC CAP STAMPED "OREGON STATE HIGHWAY DIV." 0.2 FT. BELOW SURFACE GOOD COND. PADDLE BOARD NEARBY MARKED "SHRW 1304+12.00 PC AH = 1304+18.51 POT BK 55 LT"	10C-54-2
1042	537032.732	4128760.248			1304+74.88	-40.13	8/24/2008	FD. 5/8" I. REBAR 0.40 FT. BELOW SURFACE FAIR COND. BENT TO NW RW STATION 1304+75 50 LT	10C-54-2
1043	537017.791	4128875.981			1306+93.92	-28.82	8/24/2008	FD. 3/4" I. ROD 0.10 FT. BELOW SURFACE BENT EASTERLY TIED WHERE ROD ENTERS GROUND POOR COND. RW STATION 1308+00 30 LT	8B-28-22
1044	537027.882	4128875.730	717.88		1306+93.77	-38.71	8/24/2008	FD. 3/4" I. ROD 0.10 FT. BELOW SURFACE BENT WESTERLY TIED WHERE ROD ENTERS GROUND POOR COND. RW STATION 1308+00 40 LT	8B-28-22
1218	536831.321	4125205.500			1292+23.44	572.23	8/28/2008	FD. 5/8" I. REBAR 0.2 FT. ABOVE SURFACE GOOD COND. DOUG. CO. RW STA. 15+79.74 PC 35 LT	CO. RD. 125 SHT 5
1217	536817.392	4125160.054			1291+81.88	584.38	8/28/2008	FD. 5/8" I. REBAR 0.5 FT. ABOVE SURFACE POOR COND. BENT EASTERLY TIED WHERE ENTERS GROUND. DOUG. CO. RW STA. 15+79.74 PC 30 RT	CO. RD. 125 SHT 5

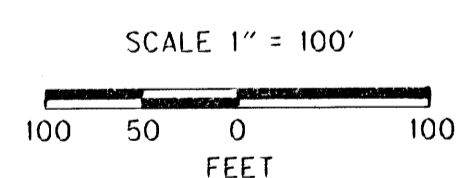

REGISTERED PROFESSIONAL LAND SURVEYOR
 Marshall R. Wagstaff
 OREGON
 JANUARY 9, 2001
 MARSHALL R. WAGSTAFF
 49476LS
 EXPIRES 06/30/10

SI FEET
OREGON DEPARTMENT OF TRANSPORTATION
 HORIZONTAL CONTROL, RECOVERY AND RETRACEMENT MAP
 OR42: HOOVER HILL - LOOKINGGLASS CREEK PAVING
 COOS BAY - ROSEBURG HWY. NO. 35, OR42, M.P. 68.61-72.52
 DOUGLAS COUNTY
 FILE: 13820RW.DGN
 FOR ODOT REGION 3
 3500 NW. STEWART PKWY.
 ROSEBURG, OR. 97470
 JULY 30, 2009
 SCALE: 1" = 100'
 SHEET 6 OF 14

ST. HWY 42 - Q14 F