

NW 1/4 SECTION 4, T. 25 S., R. 5 W., W.M.  
 SW 1/4 SECTION 4, T. 25 S., R. 5 W., W.M.

FILED  
 Date: 11-30-2020 By: D.  
 This survey consists of:  
 Map: ST. HWY 99-006 A-F  
 Narrative: \_\_\_\_\_  
 Corner Rpt: \_\_\_\_\_  
 DOUGLAS COUNTY  
 SURVEYOR



ASSESSOR'S MAPS:  
 25 5 4  
 25 5 4BD  
 25 5 4CA


SEE SHEET 1 FOR LINE LEGEND

RECORD DATA & POINT LEGEND	
( )	RECORD DATA PER ODOT DRG. 38-11-12
( ) R2	RECORD DATA PER M 117-17
( ) R3	RECORD DATA PER M 22-44
( ) R4	RECORD DATA PER RM 2-59
★	SET GPS STATION (SEE SHEET 2)
▲	SET NETWORK POINT (SEE SHEET 2)
○	FOUND MONUMENT

RECOVERED MONUMENT LIST

PT. NO.	STATION	OFFSET	OCRS NORTHING	OCRS EASTING	DATE	DESCRIPTION	REFERENCE DOCUMENT
1000	-	-	215340.49	173005.60	1/9/2020	FOUND 5/8" IRON REBAR w/ YELLOW PLASTIC CAP, STAMPING UNREADABLE, EXPOSED 0.5'	M 118-57
1005	-	-	215108.61	173091.29	1/9/2020	FOUND 5/8" IRON REBAR, DOWN 0.4'	REF M 117-17
1006	-	-	214863.94	173217.24	1/9/2020	FOUND MAG NAIL, FLUSH	UNKNOWN ORIGIN
1024	1705+29.05	29.93	214713.05	172946.58	3/12/2020	FOUND 5/8" IRON REBAR w/ RED PLASTIC CAP "D.A. EDWARDS L.S. 2339", DOWN 0.5'.	PARTITION PLAT NO. 2001-0091
1025	-	-	214667.02	172857.76	3/12/2020	FOUND 5/8" IRON REBAR, DOWN 0.1'	PARTITION PLAT NO. 2001-0091

REF=REFERENCE DOCUMENT

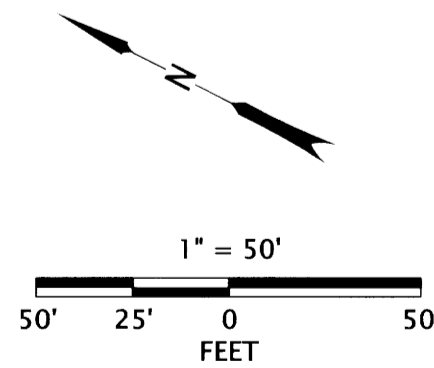

REGISTERED  
 PROFESSIONAL  
 LAND SURVEYOR

*Andrew David Ausland*  
 OREGON  
 JULY 15, 2003  
 ANDREW DAVID AUSLAND  
 56136  
 EXPIRES: 12/31/2021

OREGON DEPARTMENT OF TRANSPORTATION

HORIZONTAL CONTROL, RECOVERY AND RETRACEMENT SURVEY  
 OLD HWY. 99N: OAKLAND BRIDGE  
 OLD HIGHWAY 99 NORTH  
 DOUGLAS COUNTY



ODOT REGION 3 TECH CENTER  
 100 ANTELOPE ROAD  
 WHITE CITY, OREGON, 97503 KEY NO. 21591  
 NOVEMBER 24, 2020  
 SCALE: 1" = 50'  
 SHEET 5 OF 6