

SECTION 4 & 3, T. 29 S., R. 5 1/2 E., W. M.

FILED

Date: 6-9-1999 By: J.P.  
This survey consists of 16 Pages  
Map: M129-48 M  
Narrative:  
Corner Rpt: CS 65/28-14

DOUGLAS COUNTY  
SURVEYOR

PT.\*322  
STA.61+152.897  
OFFSET 8.728 M LT.  
N 159314.366  
E 1369685.626  
SET 61 MM X 910 MM ALUM.PIPES  
WITH 64 MM ALUM.CAP STAMPED,  
"ODOT CONTROL 1998 322 DO NOT  
DISTURB". FLUSH WITH SURFACE.

PT.\*217  
STA.60+898.759  
OFFSET 12.338 M RT.  
N 159297.731  
E 1369431.160  
SET 13 MM X 760 MM SQ.I. ROD  
WITH 38 MM ALUM.CAP STAMPED.  
"ODOT HORIZ.CONTROL 217".

PT.\*1036  
STA.60+371.928  
OFFSET 20.117 M LT.  
N 159339.358  
E 1368904.978  
FOUND 1" (25 MM) BRASS PLUG  
100 MM ABOVE SURFACE IN GOOD  
CONDITION. STA. 778+50.2, 66 FT. LT.

PT. TTN09  
STA.60+323.987  
OFFSET 20.926 M LT.  
N 159344.602  
E 1368860.770  
FOUND 3 1/4" (83 MM) BRASS CAP SET IN CONCRETE  
STAMPED. "U.S. COAST & GEODETIC SURVEY BENCH MARK  
TTN09 USGS RESET 1961 ELEV. FEET ABOVE MEAN SEA  
LEVEL \$250 FINE OR IMPRISONMENT FOR DISTURBING  
THIS MARK". 220 MM ABOVE SURFACE.

PT.\*216  
STA.60+341.968  
OFFSET 10.014 M RT.  
N 159311.370  
E 1368873.545  
SET 13 MM X 760 MM SQ.I. ROD  
WITH 38 MM ALUM.CAP STAMPED.  
"ODOT HORIZ.CONTROL 216".

PT. EC41085  
STA.60+316.524  
OFFSET 25.764 M RT.  
N 159300.261  
E 1368844.336  
FOUND 3 1/4" (83 MM) ALUM.CAP STAMPED.  
"U.S. DEPARTMENT OF THE INTERIOR BUR.  
OF LAND MANAGEMENT CONTROL SURVEY  
STATION UNLAWFUL TO DISTURB EC41085  
GPS 1991". 50 MM BELOW SURFACE SET IN  
170 MM PLASTIC PIPE.

PT.\*1034  
STA.60+282.487  
OFFSET 41.026 M RT.  
N 159295.546  
E 1368803.742  
FOUND 3 1/4" (83 MM) BRASS DISK STAMPED.  
"U.S. DEPT. OF THE INTERIOR BUR. OF LAND  
MANAGEMENT UNLAWFUL TO DISTURB CADASTRAL  
SURVEY RM APT08 51.15 FT. CLNP".

PT.\*215  
STA.60+240.765  
OFFSET 14.893 M RT.  
N 159337.237  
E 1368771.665  
SET 13 MM X 760 MM SQ.I. ROD  
WITH 38 MM ALUM.CAP STAMPED.  
"ODOT HORIZ.CONTROL 215".

PT.\*1033  
STA.60+207.613  
OFFSET 20.068 M LT.  
N 159383.902  
E 1368760.751  
FOUND 3" (76 MM) BRASS DISK SET IN CONCRETE  
STAMPED. "US. DEPT. OF AGRICULTURE BUREAU  
OF PUBLIC ROADS ELEVATION". 80 MM ABOVE  
SURFACE. EQUATION STA. 783+89.9 PT = 81+29.2  
PT BK = 81+19.5 POT AH, 66 FT. RT.

PT.\*214  
STA.60+049.726  
OFFSET 22.303 M RT.  
N 159435.805  
E 1368605.805  
SET 13 MM X 760 MM SQ.I. ROD  
WITH 38 MM ALUM.CAP STAMPED.  
"ODOT HORIZ.CONTROL 214".

PT.\*1032  
STA.60+207.625  
OFFSET 20.071 M RT.  
N 159350.367  
E 1368738.693  
FOUND 1" (25 MM) BRASS PLUG SET  
IN CONCRETE 50 MM ABOVE SURFACE  
IN GOOD CONDITION. EQUATION STA.  
783+89.9 PT = 81+29.2 PT BK =  
81+19.5 POT AH, 66 FT. LT.


PT.\*213  
STA.59+891.814  
OFFSET 8.571 M RT.  
N 159556.075  
E 1368496.133  
SET 13 MM X 760 MM SQ.I. ROD  
WITH 38 MM ALUM.CAP STAMPED.  
"ODOT HORIZ.CONTROL 213".

PT.\*212  
STA.59+762.542  
OFFSET 15.741 M RT.  
N 159677.264  
E 1368440.173  
SET 13 MM X 760 MM SQ.I. ROD  
WITH 38 MM ALUM.CAP STAMPED.  
"ODOT HORIZ.CONTROL 212".

PT.\*211  
STA.59+616.375  
OFFSET 19.698 M RT.  
N 159828.233  
E 1368441.399  
SET 13 MM X 760 MM SQ.I. ROD  
WITH 38 MM ALUM.CAP STAMPED.  
"ODOT HORIZ.CONTROL 211".

PT.\*210  
STA.59+488.320  
OFFSET 18.885 M LT.  
N 159956.162  
E 1368480.612  
SET 13 MM X 760 MM SQ.I. ROD  
WITH 38 MM ALUM.CAP STAMPED.  
"ODOT HORIZ.CONTROL 210".

FOR MORE INFORMATION ON FOUND MONUMENTS  
SEE ADDENDUM FILED IN C.S. FILE 65/28-14

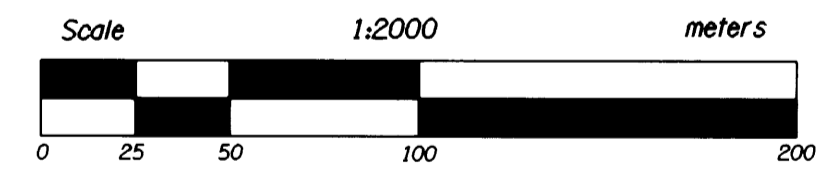

LEGEND  
▲ SET MONUMENT  
○ FOUND MONUMENT  
--- EASEMENT LINE

REGISTERED  
PROFESSIONAL  
LAND SURVEYOR  
*Christine V. Blewins*  
OREGON  
JULY 19, 1994  
CHRISTINE V. BLEWINS  
2669  
EXPIRES : DECEMBER 31, 1999

COUNTY SURVEYORS FILE DATA  
DO NOT REMOVE FROM OFFICE

STUMP LAKE - FOREST BOUNDARY NORTH UMPQUA HIGHWAY DOUGLAS COUNTY		UMPQUA NATIONAL FOREST HIGHWAY EASEMENT SURVEY JUNE 1999	
OREGON DEPT. OF TRANSPORTATION 3500 NW STEWART PARKWAY ROSEBURG, OR 97470		KEY NUMBER 05788	SHEET 13 OF 16