

LEGEND



- ◆ SET CONTROL MONUMENT
- △ FOUND CONTROL MONUMENT
- EXISTING EDGE OF ROAD
- CONTROL TRAVERSE LINE
- - - APPROXIMATE SECTION LINE

NOTE:
 1. ALL BEARINGS AND DISTANCES SHOWN ARE GRID VALUES.
 2. ALL PUBLIC LAND SURVEY LINES SHOWN ARE APPROXIMATE AND ARE FOR REFERENCE ONLY.

FILED
 Date: 6-22-2005 By: JP
 This survey consists of: 8 SHEETS
 Map: ST HWY. 138-007 D
 Narrative:
 Corner Fpt:
 DOUGLAS COUNTY SURVEYOR

SECTION 21, T. 26 S., R. 3 E., W.M.



SECTION 28, T. 26 S., R. 3 E., W.M.

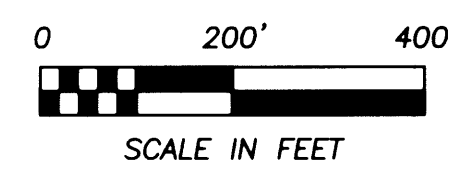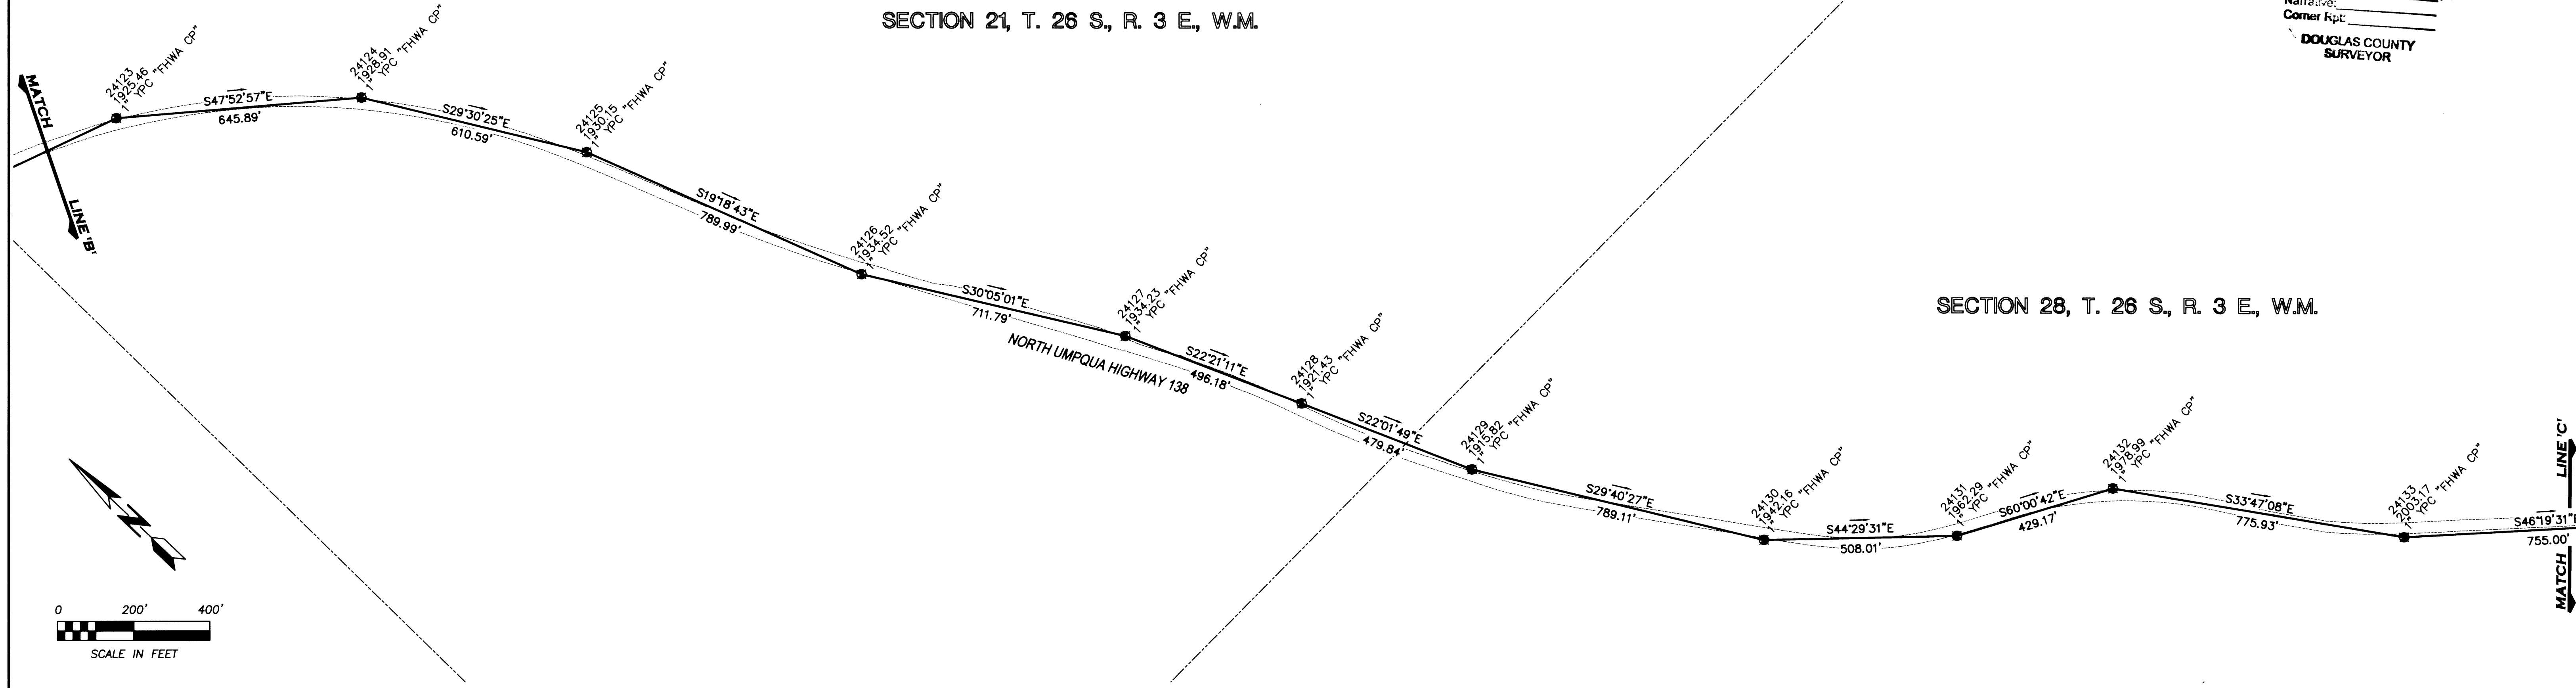

SECTION 27, T. 26 S., R. 3 E., W.M.

SECTION 28, T. 26 S., R. 3 E., W.M.

SECTION 34, T. 26 S., R. 3 E., W.M.

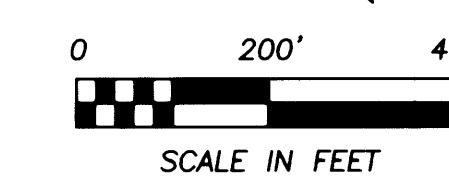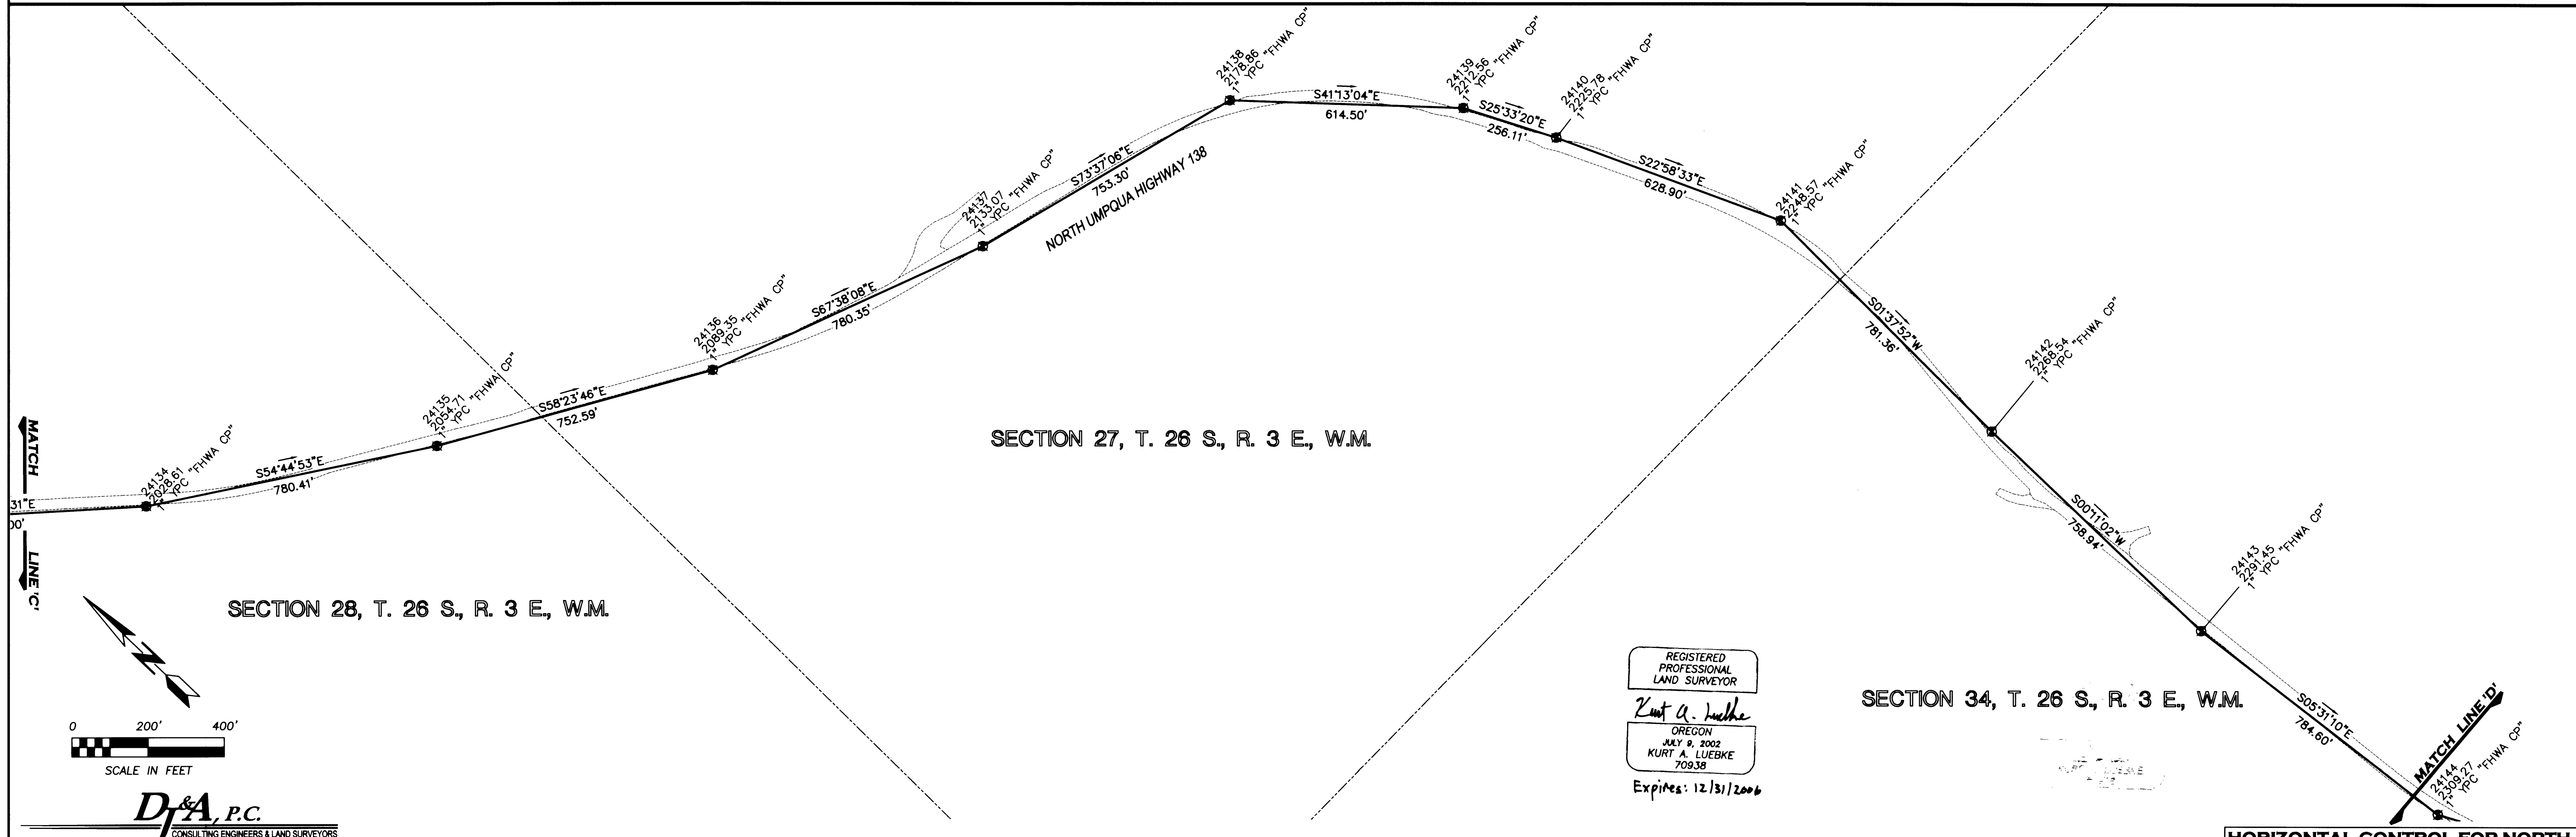

REGISTERED PROFESSIONAL LAND SURVEYOR
Kurt A. Luebke
 OREGON
 JULY 9, 2002
 KURT A. LUEBKE
 70938
 Expires: 12/31/2006

HORIZONTAL CONTROL FOR NORTH UMPQUA HIGHWAY 138 SHEET 4 OF 8

D&A, P.C.
 CONSULTING ENGINEERS & LAND SURVEYORS
 3203 Russell Street, Moscow, Montana 59601-4591
 Phone: 409/721-4329 Fax: 409/644-6371