

LEGEND

- ◆ SET CONTROL MONUMENT
- △ FOUND CONTROL MONUMENT
- EXISTING EDGE OF ROAD
- CONTROL TRAVERSE LINE
- - - APPROXIMATE SECTION LINE

NOTE:
 1. ALL BEARINGS AND DISTANCES SHOWN ARE GRID VALUES.
 2. ALL PUBLIC LAND SURVEY LINES SHOWN ARE APPROXIMATE AND ARE FOR REFERENCE ONLY.



SECTION 34, T. 26 S., R. 3 E., W.M.

SECTION 35, T. 26 S., R. 3 E., W.M.

FILED
 Date: 6-22-2005 By: JP
 This survey consists of: 8 SHEETS
 Map: ST. Hwy. 138-007E
 Name: _____
 Corner Rpt: _____
 DOUGLAS COUNTY
 SURVEYOR

MATCH LINE 'D'


MATCH LINE 'E'

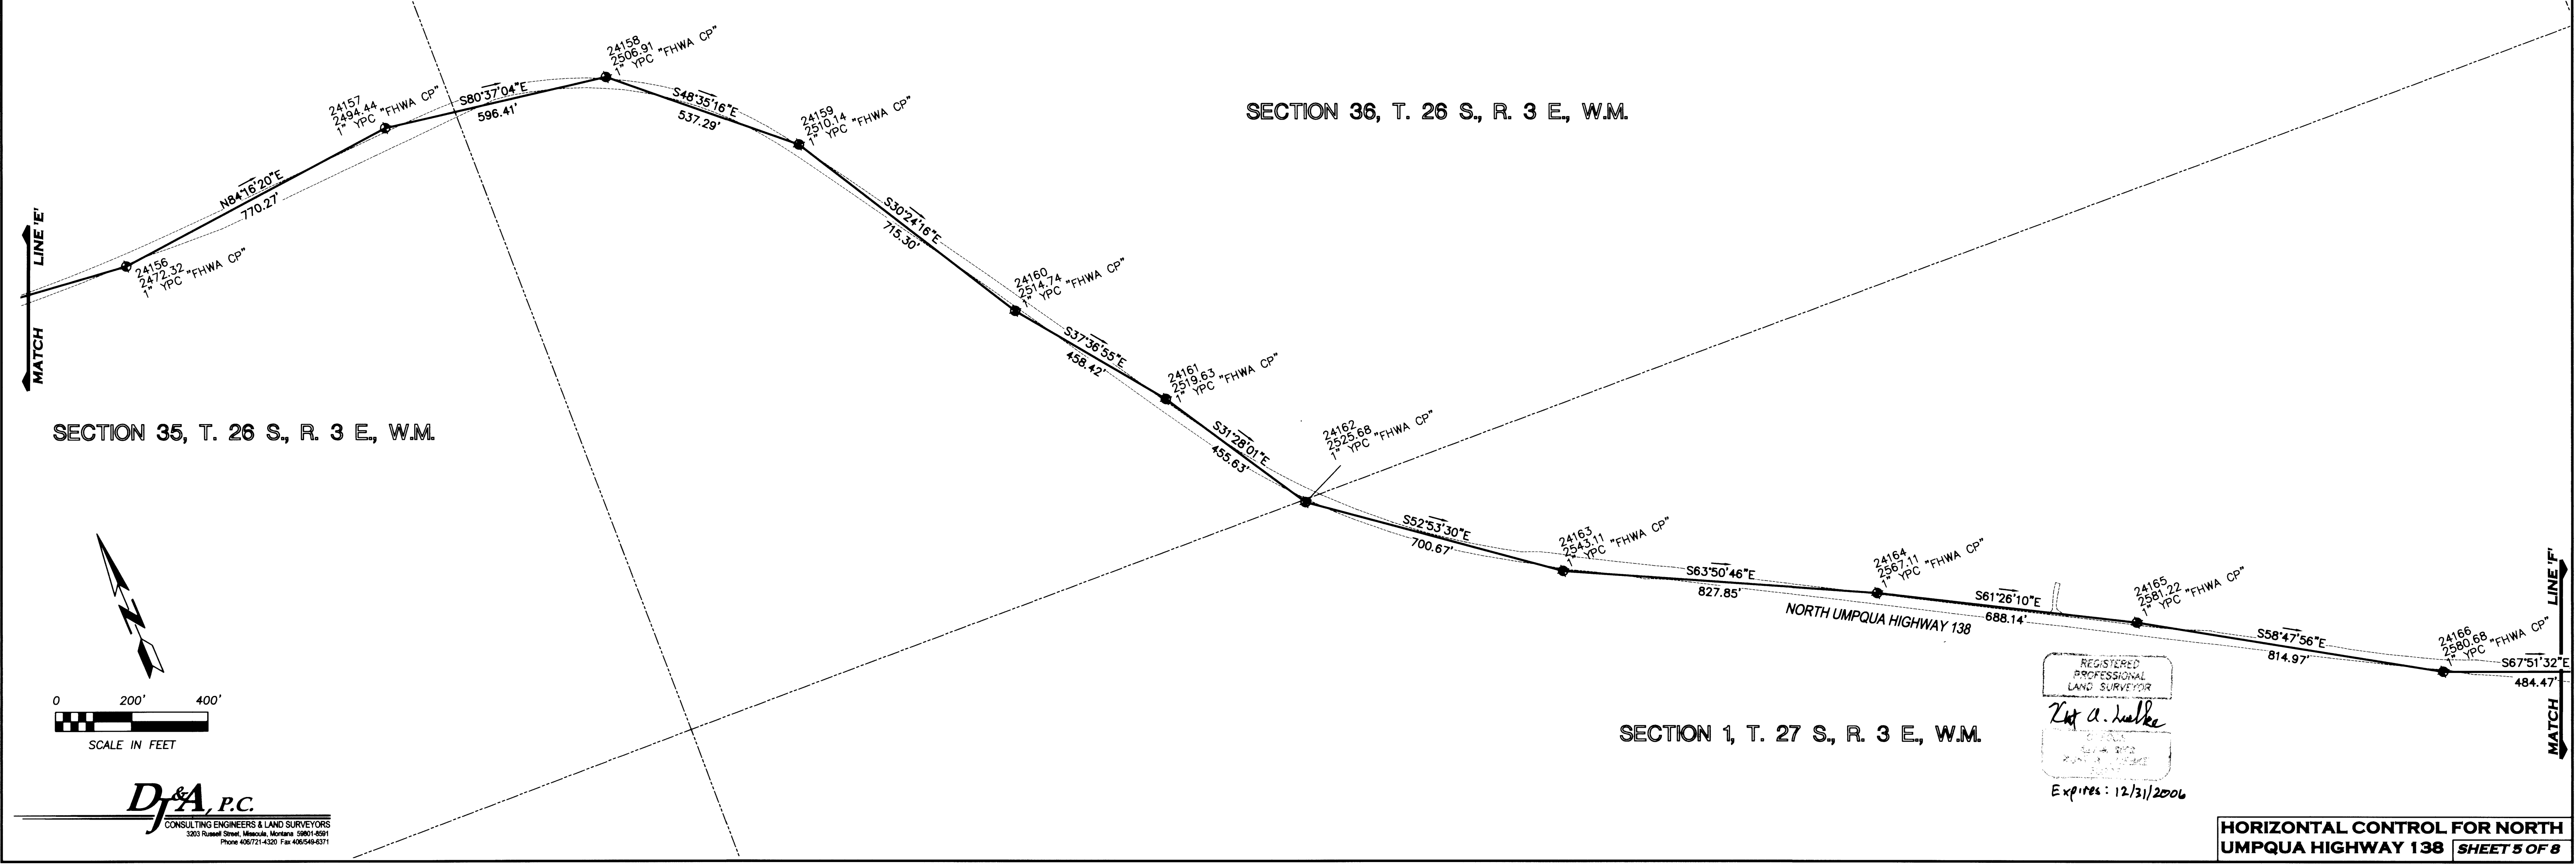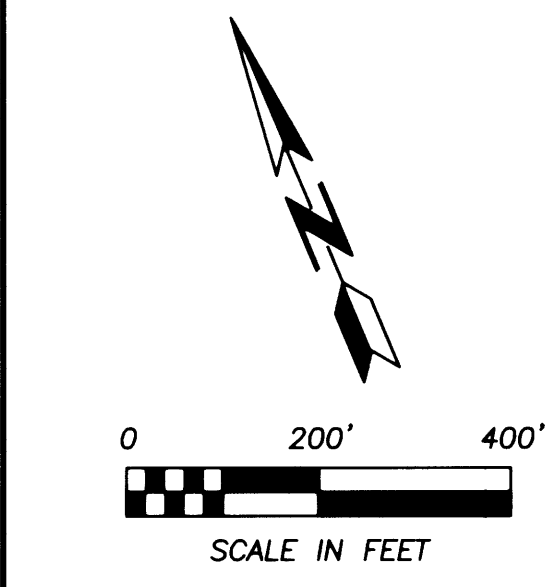

SECTION 36, T. 26 S., R. 3 E., W.M.

SECTION 35, T. 26 S., R. 3 E., W.M.

SECTION 1, T. 27 S., R. 3 E., W.M.

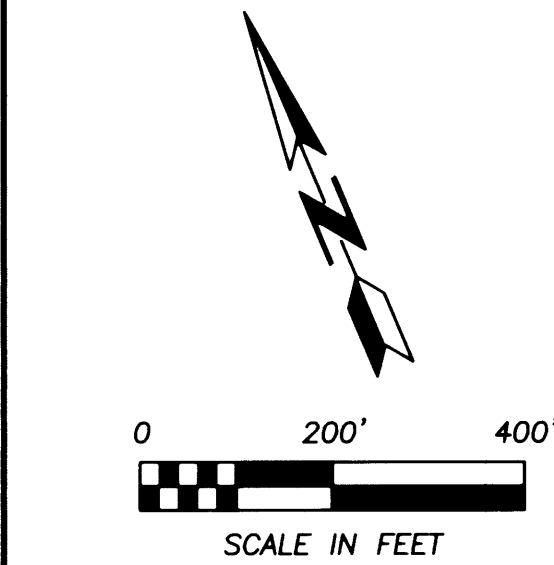

REGISTERED
 PROFESSIONAL
 LAND SURVEYOR
Kit A. Hulke
 Expires: 12/31/2006

HORIZONTAL CONTROL FOR NORTH
 UMPQUA HIGHWAY 138 SHEET 5 OF 8