
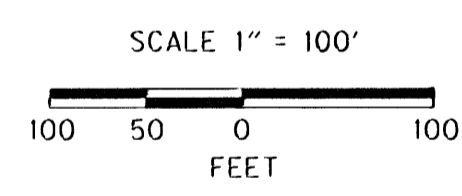


SEC. 13 AND SEC. 24., T. 26 S., R. 2 W., W.M.
 SEC. 18, T. 26 S., R. 1 W., W.M.

FILED
 Date: 7-8-2009 By: JG
 This survey consists of:
 Map: ST HWY 138-011 A-C
 Narrative:
 Corner Rpt:
 DOUGLAS COUNTY
 SURVEYOR

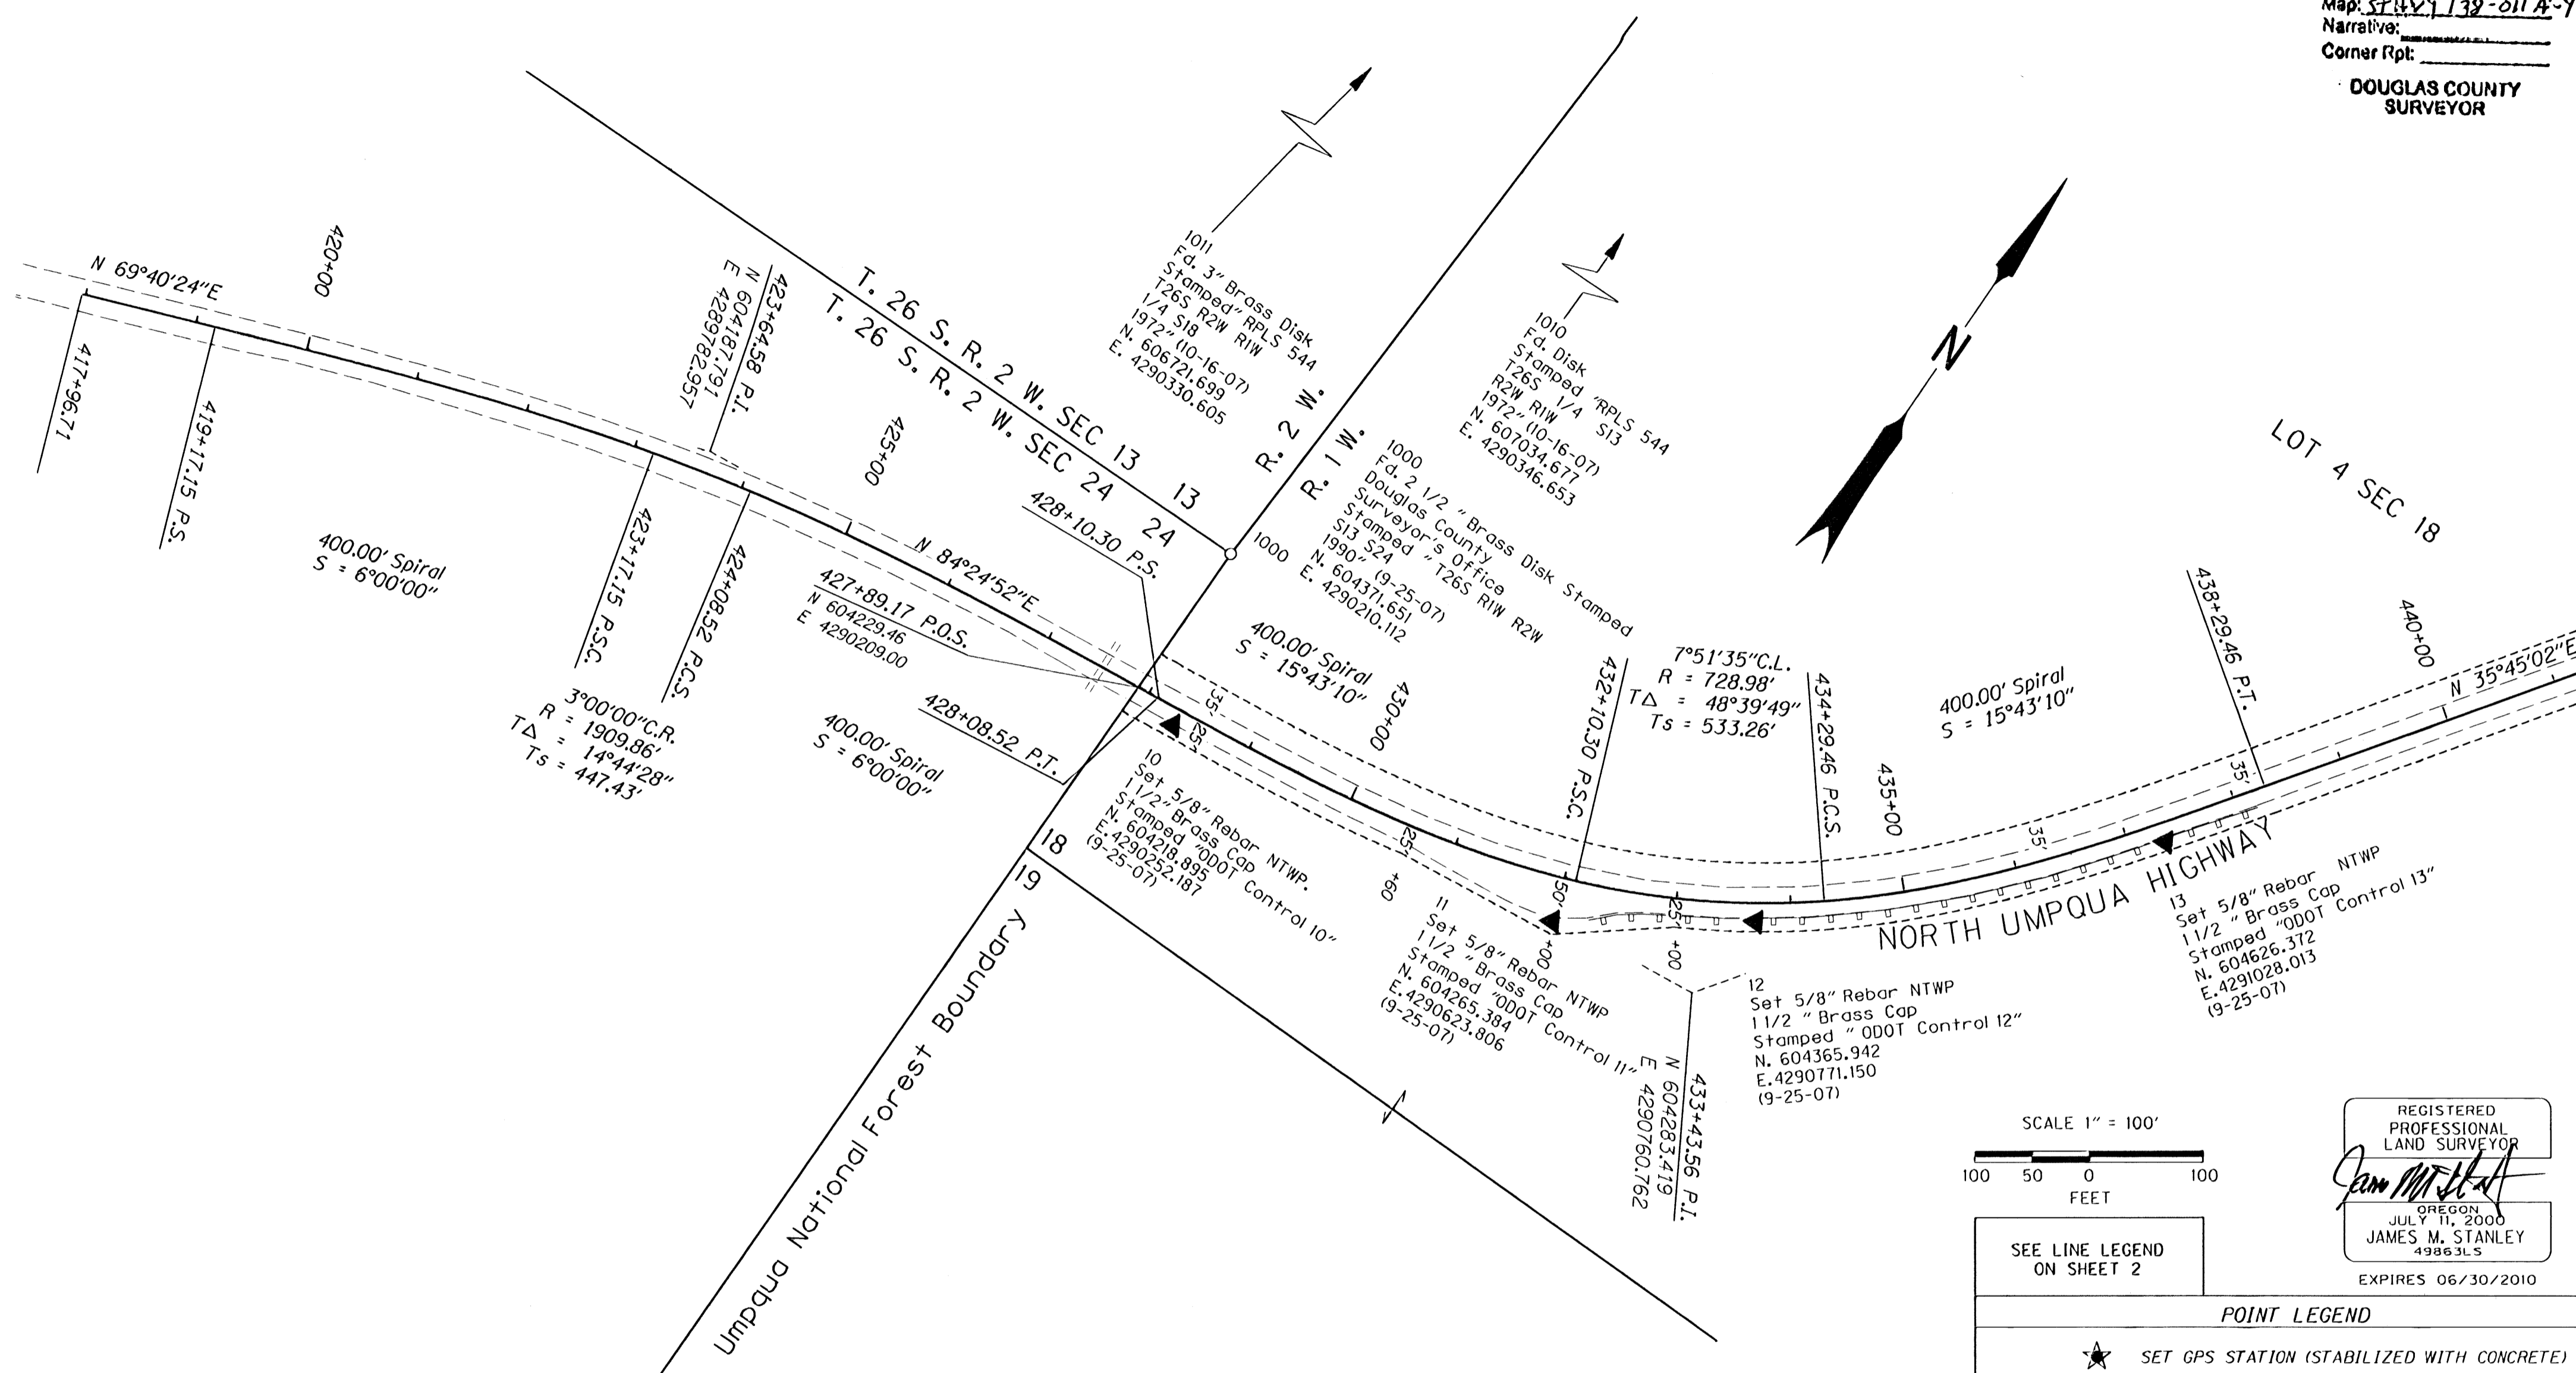

SEE LINE LEGEND
 ON SHEET 2

REGISTERED
 PROFESSIONAL
 LAND SURVEYOR
James M. Stanley
 OREGON
 JULY 11, 2000
 JAMES M. STANLEY
 49863LS
 EXPIRES 06/30/2010

POINT LEGEND

★	SET GPS STATION (STABILIZED WITH CONCRETE)
▲	SET ODOT NETWORK POINT
○	FOUND MONUMENT

SI FEET OREGON DEPARTMENT OF TRANSPORTATION
 HORIZONTAL CONTROL, RECOVERY AND RETRACEMENT MAP
 FOREST BOUNDARY-STEAMBOAT CREEK
 NORTH UMPQUA HWY. ORI38E MP 30.65-39.50
 DOUGLAS COUNTY
 File : 15205rw.dgn

FOR ODOT REGION 3
 3500 NW. STEWART PKWY.
 ROSEBURG, OR. 97470

JUNE 30, 2009
 SCALE: 1" = 100'
 SHEET 3 OF 25

ST. HWY. 138-011 C