
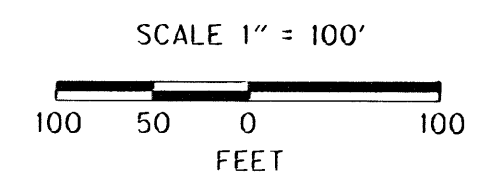


FILED  
 Date: 7/31/2009 By: JC  
 This survey consists of  
 Map: STHWY 138-011 A-Y  
 Narrative:  
 Corner Rpt:

DOUGLAS COUNTY  
 SURVEYOR

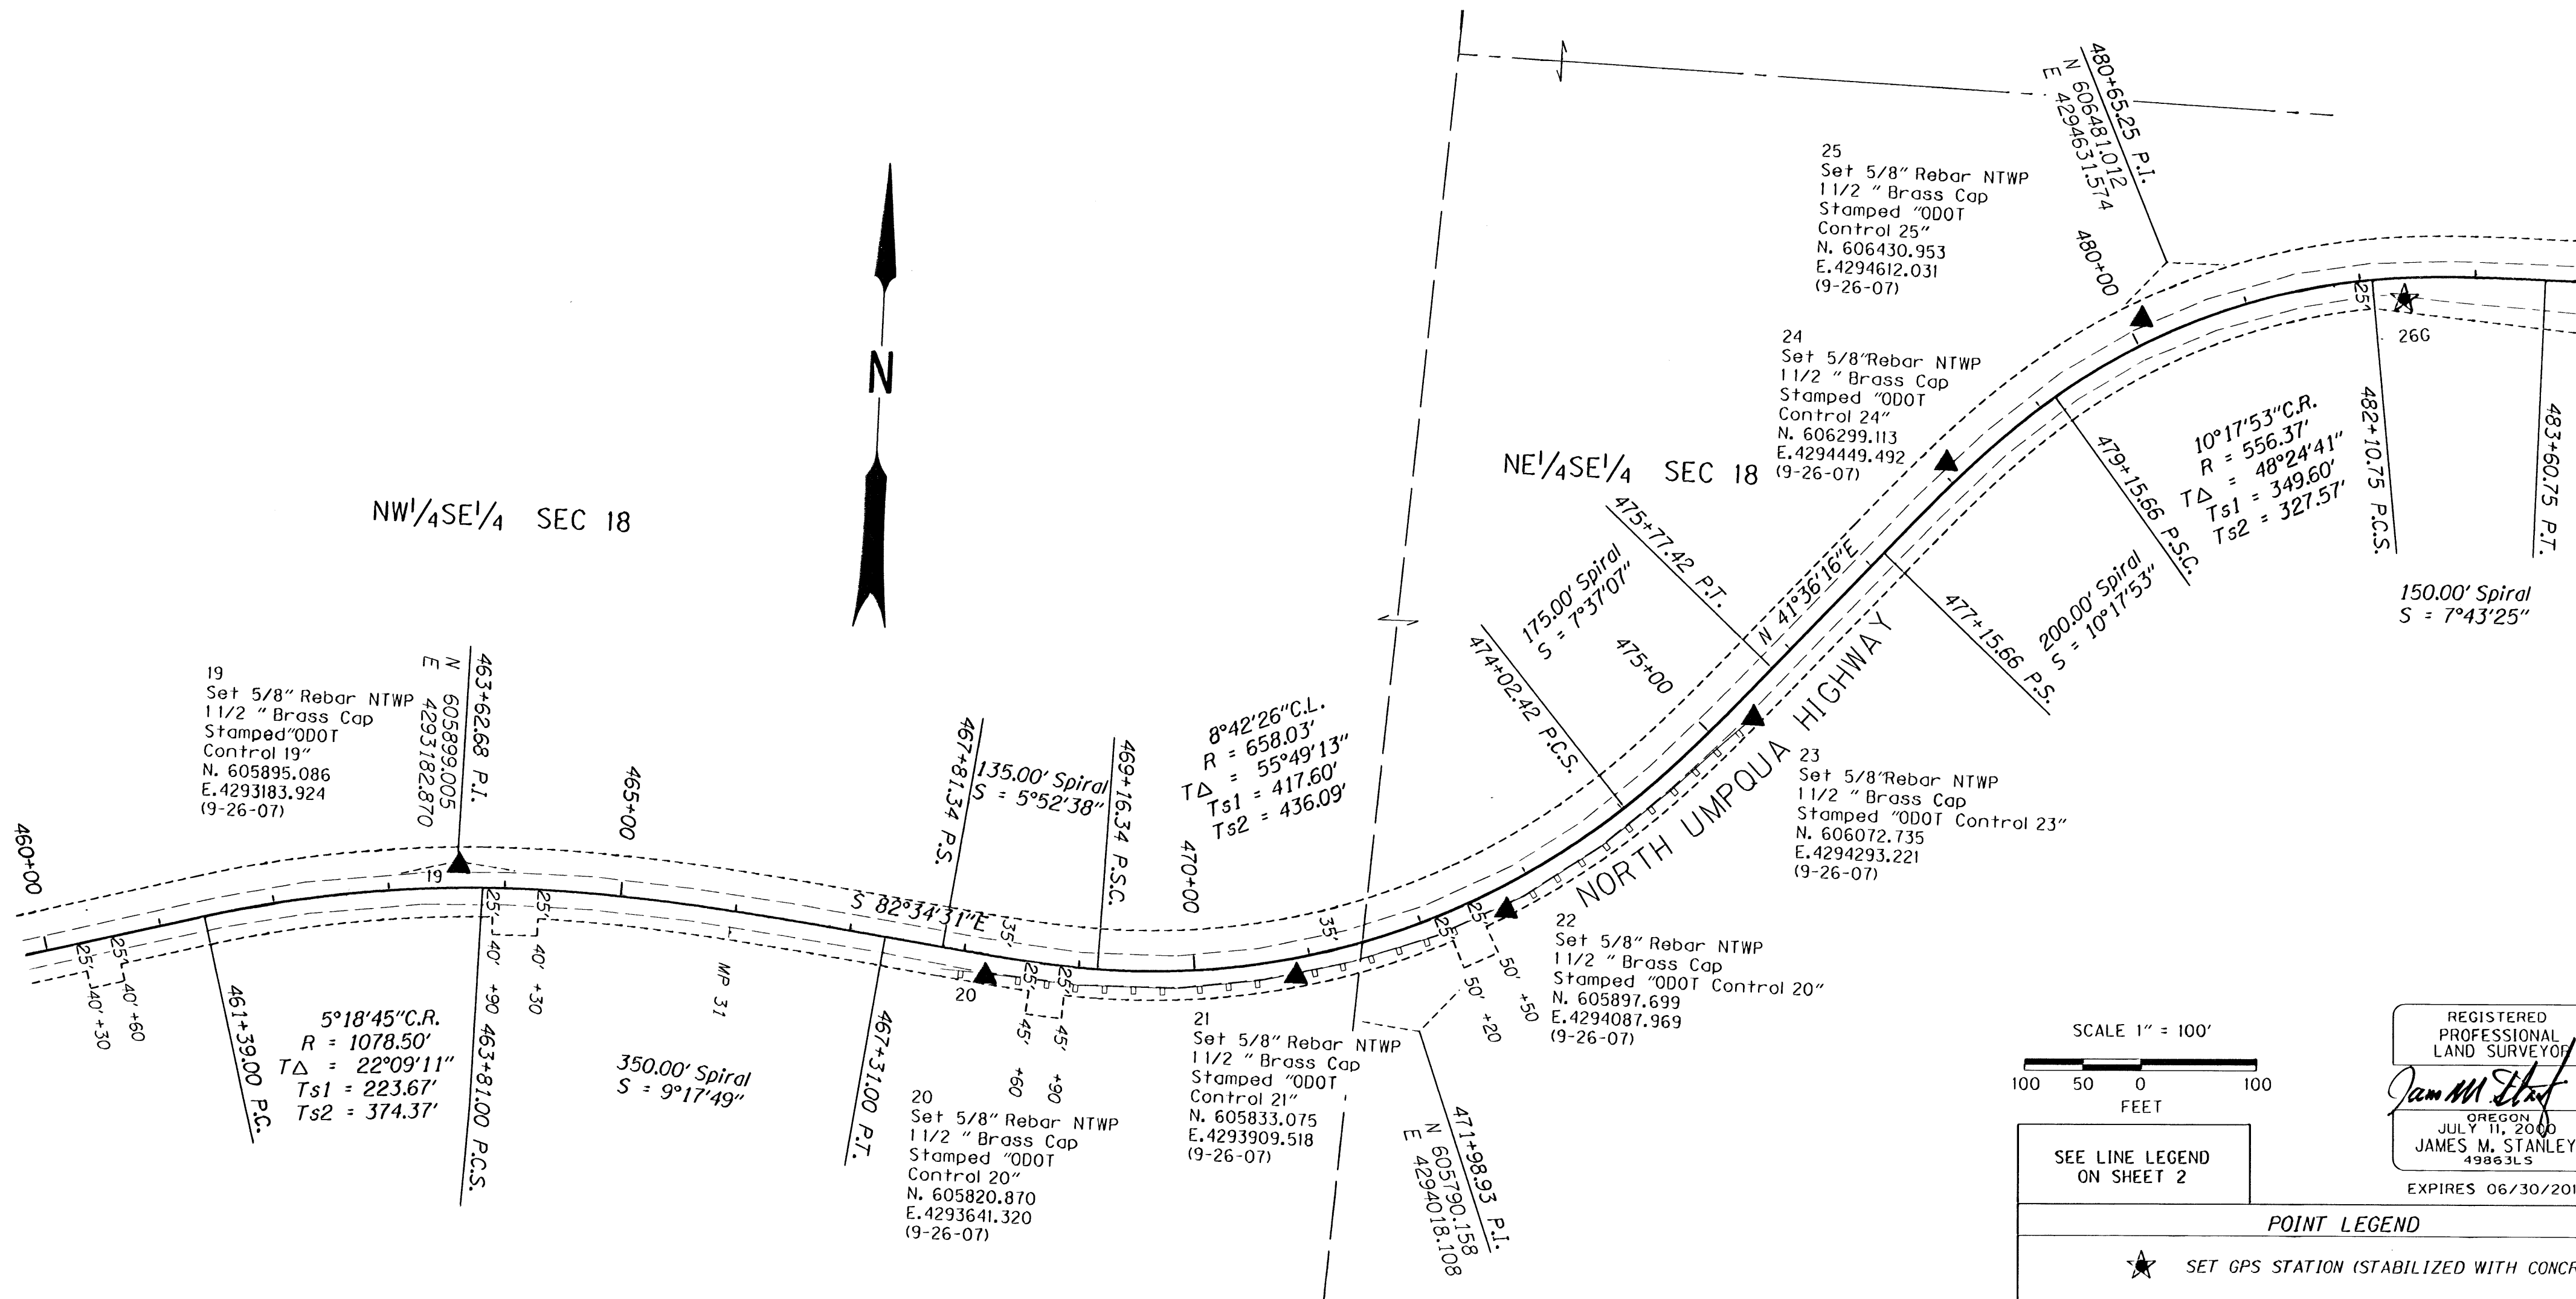

REGISTERED  
 PROFESSIONAL  
 LAND SURVEYOR  
*James M. Stanley*  
 OREGON  
 JULY 11, 2000  
 JAMES M. STANLEY  
 49863LS  
 EXPIRES 06/30/2010

SEE LINE LEGEND  
 ON SHEET 2

POINT LEGEND

★	SET GPS STATION (STABILIZED WITH CONCRETE)
▲	SET ODOT NETWORK POINT
○	FOUND MONUMENT

**SI FEET** OREGON DEPARTMENT OF TRANSPORTATION  
 HORIZONTAL CONTROL, RECOVERY AND RETRACEMENT MAP  
 FOREST BOUNDARY-STEAMBOAT CREEK  
 NORTH UMPQUA HWY, OR138E MP 30.65-39.50  
 DOUGLAS COUNTY  
 File : I5205rw.dgn

FOR ODOT REGION 3  
 3500 NW. STEWART PKWY.  
 ROSEBURG, OR. 97470

JUNE 30, 2009  
 SCALE: 1" = 100'  
 SHEET 5 OF 25