
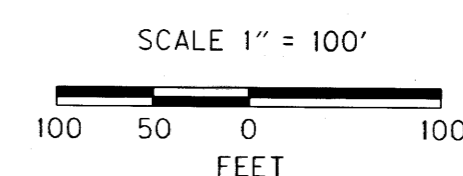


SEC. 17, T. 26 S., R. 1 W., W.M.

COUNTY SURVEYORS FILE DATA  
DO NOT REMOVE FROM OFFICE

FILED  
Date: 7-8-2009 By: JC  
This survey consists of:  
Map: ST HWY 138-011A-Y  
Narrative:  
Corner rpt:

DOUGLAS COUNTY  
SURVEYOR

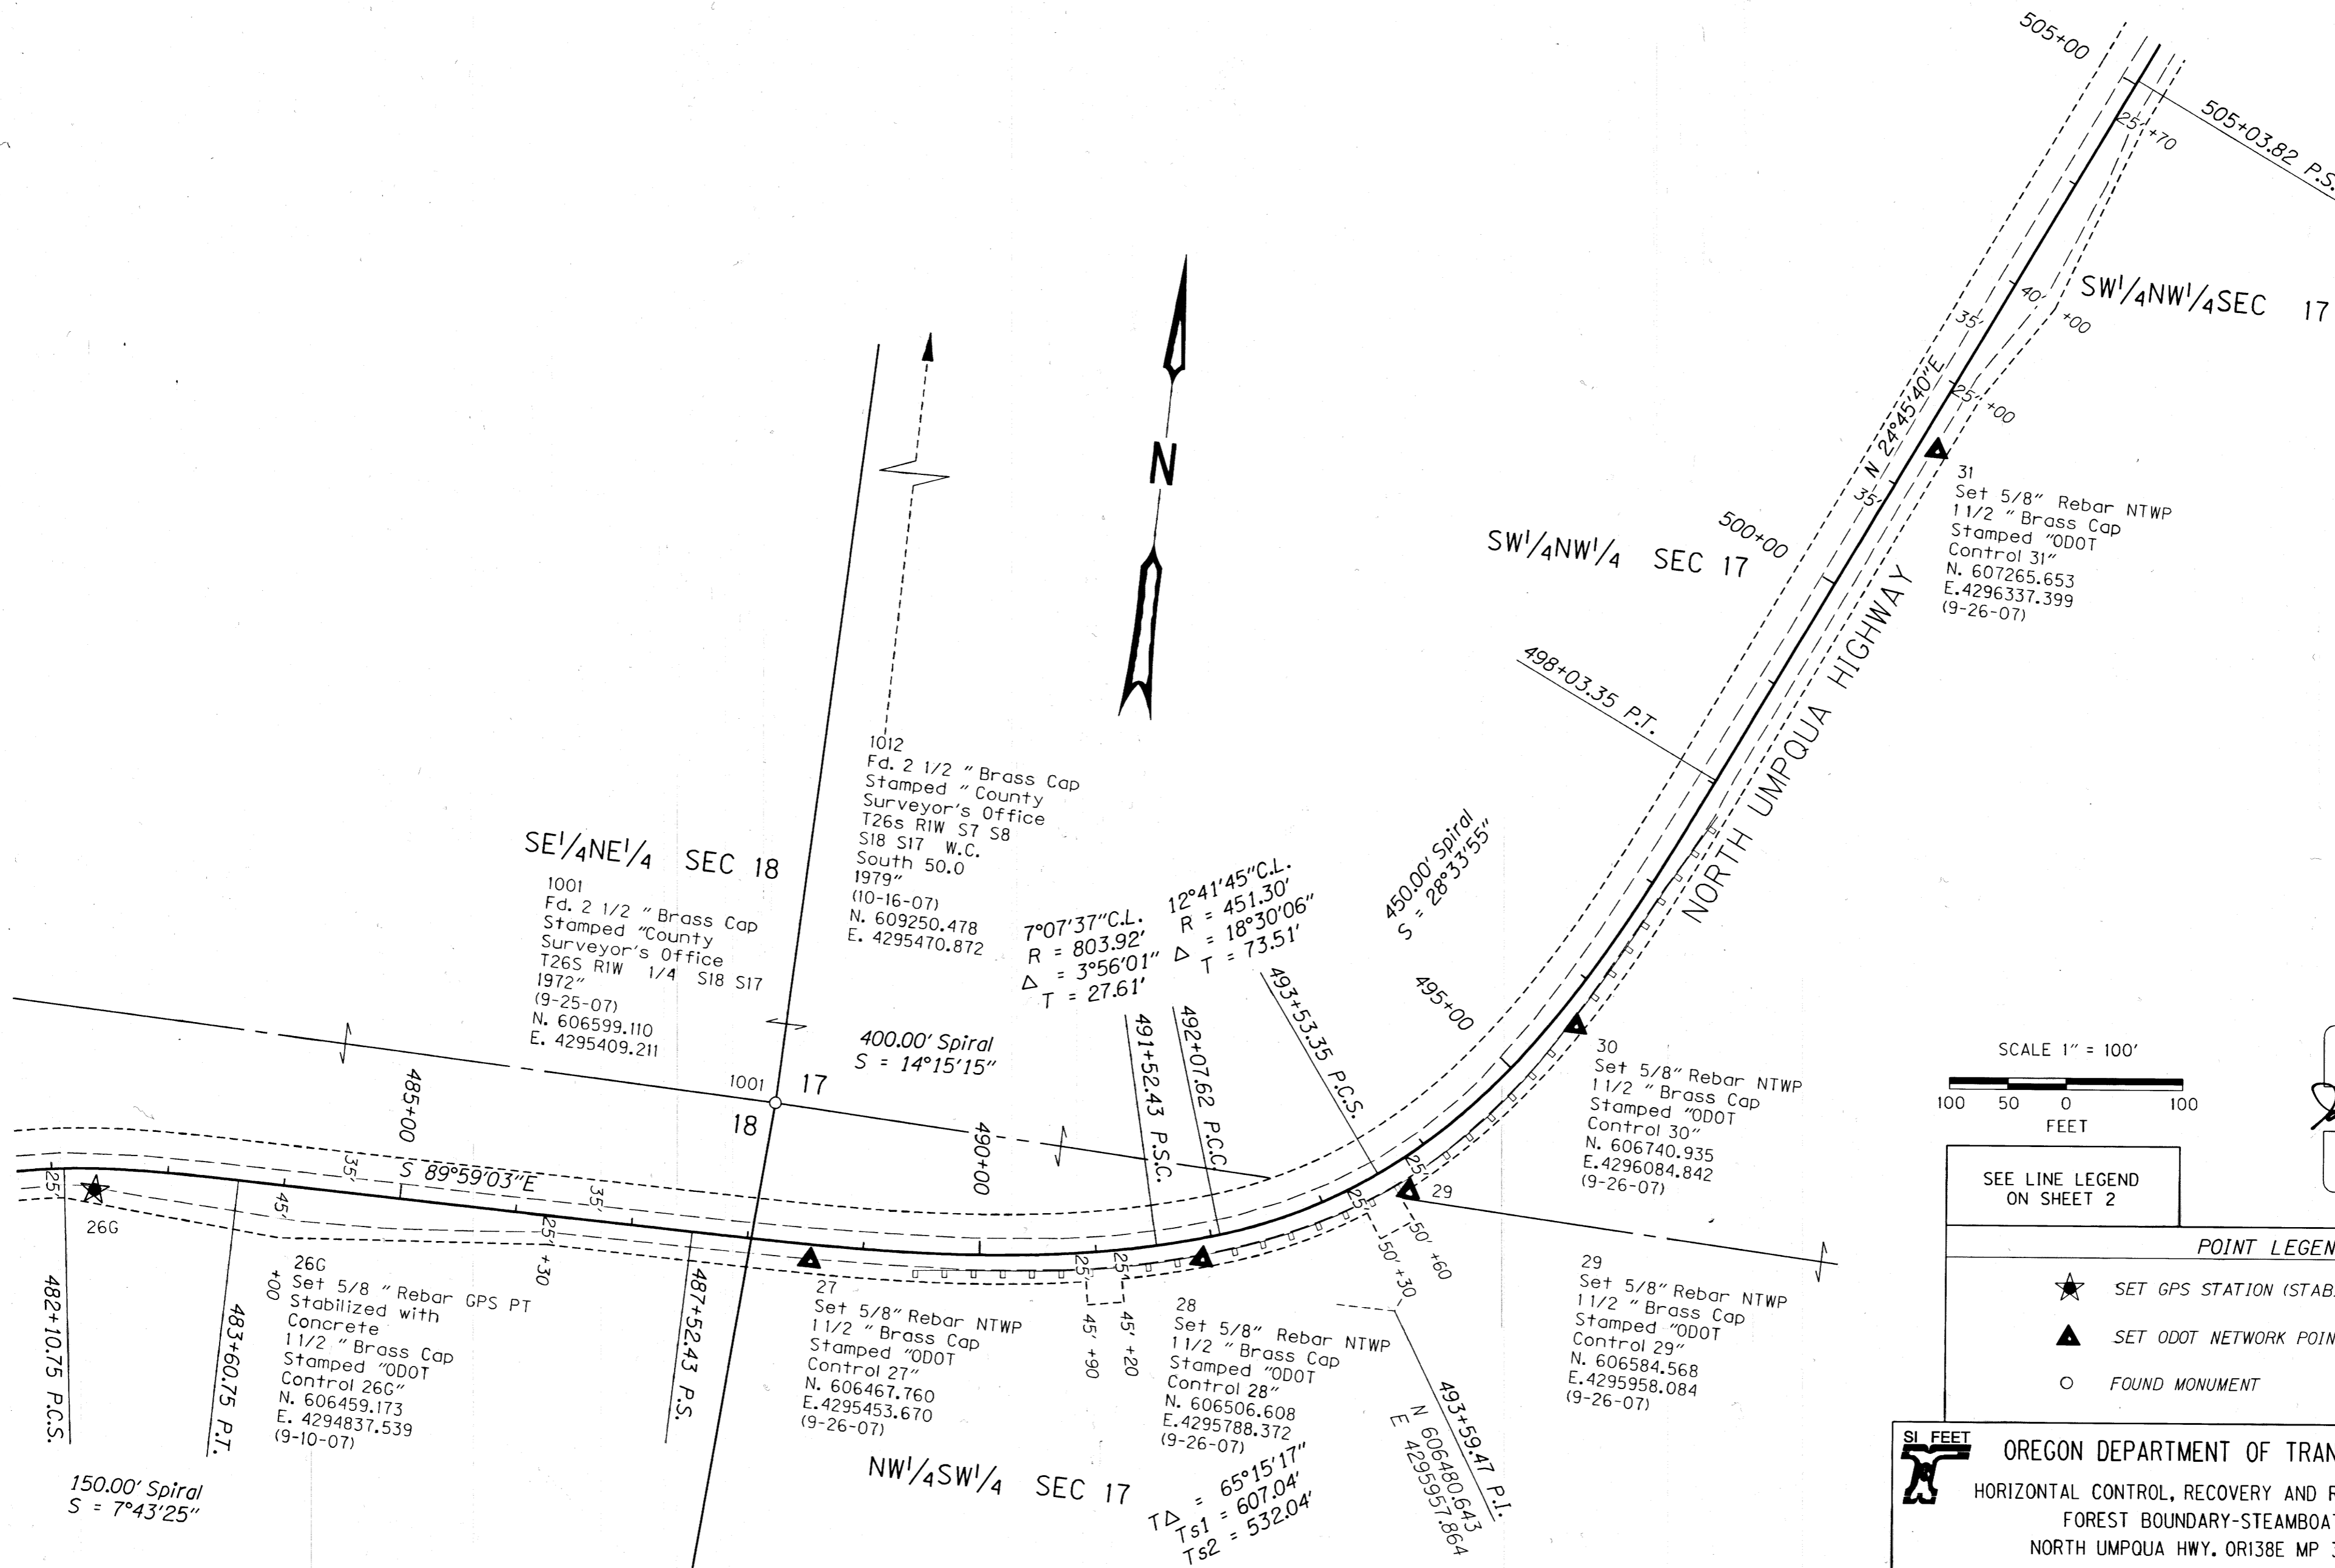

REGISTERED  
PROFESSIONAL  
LAND SURVEYOR

*James M. Stanley*

OREGON  
JULY 11, 2000  
JAMES M. STANLEY  
49863LS

EXPIRES 06/30/2010

SEE LINE LEGEND  
ON SHEET 2

POINT LEGEND

★	SET GPS STATION (STABILIZED WITH CONCRETE)
▲	SET ODOT NETWORK POINT
○	FOUND MONUMENT

SI FEET

**OREGON DEPARTMENT OF TRANSPORTATION**

HORIZONTAL CONTROL, RECOVERY AND RETRACEMENT MAP  
FOREST BOUNDARY-STEAMBOAT CREEK  
NORTH UMPQUA HWY. OR138E MP 30.65-39.50  
DOUGLAS COUNTY  
File : 15205rw.dgn

FOR ODOT REGION 3  
3500 NW. STEWART PKWY.  
ROSEBURG, OR. 97470

JUNE 30, 2009  
SCALE: 1" = 100'  
SHEET 6 OF 25

ST. HWY. 138-011 F