
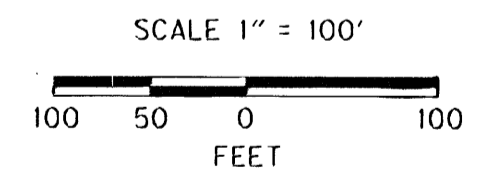
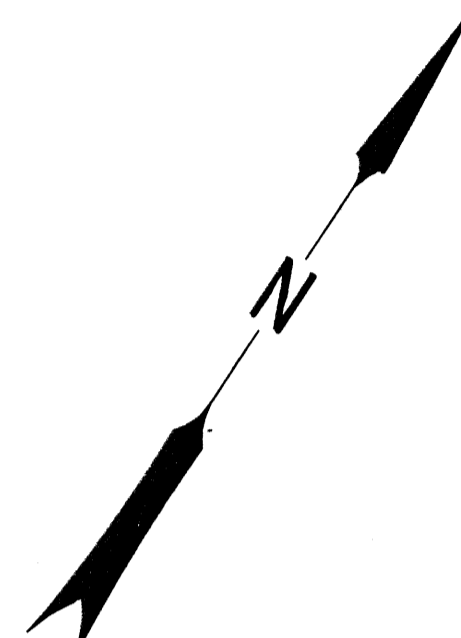


FILED
 Date: 1-8-2009 By: JC
 This survey consists of:
 Map: ST HWY 138-011 A-Y
 Narrative:
 Corner rpt:

DOUGLAS COUNTY
 SURVEYOR

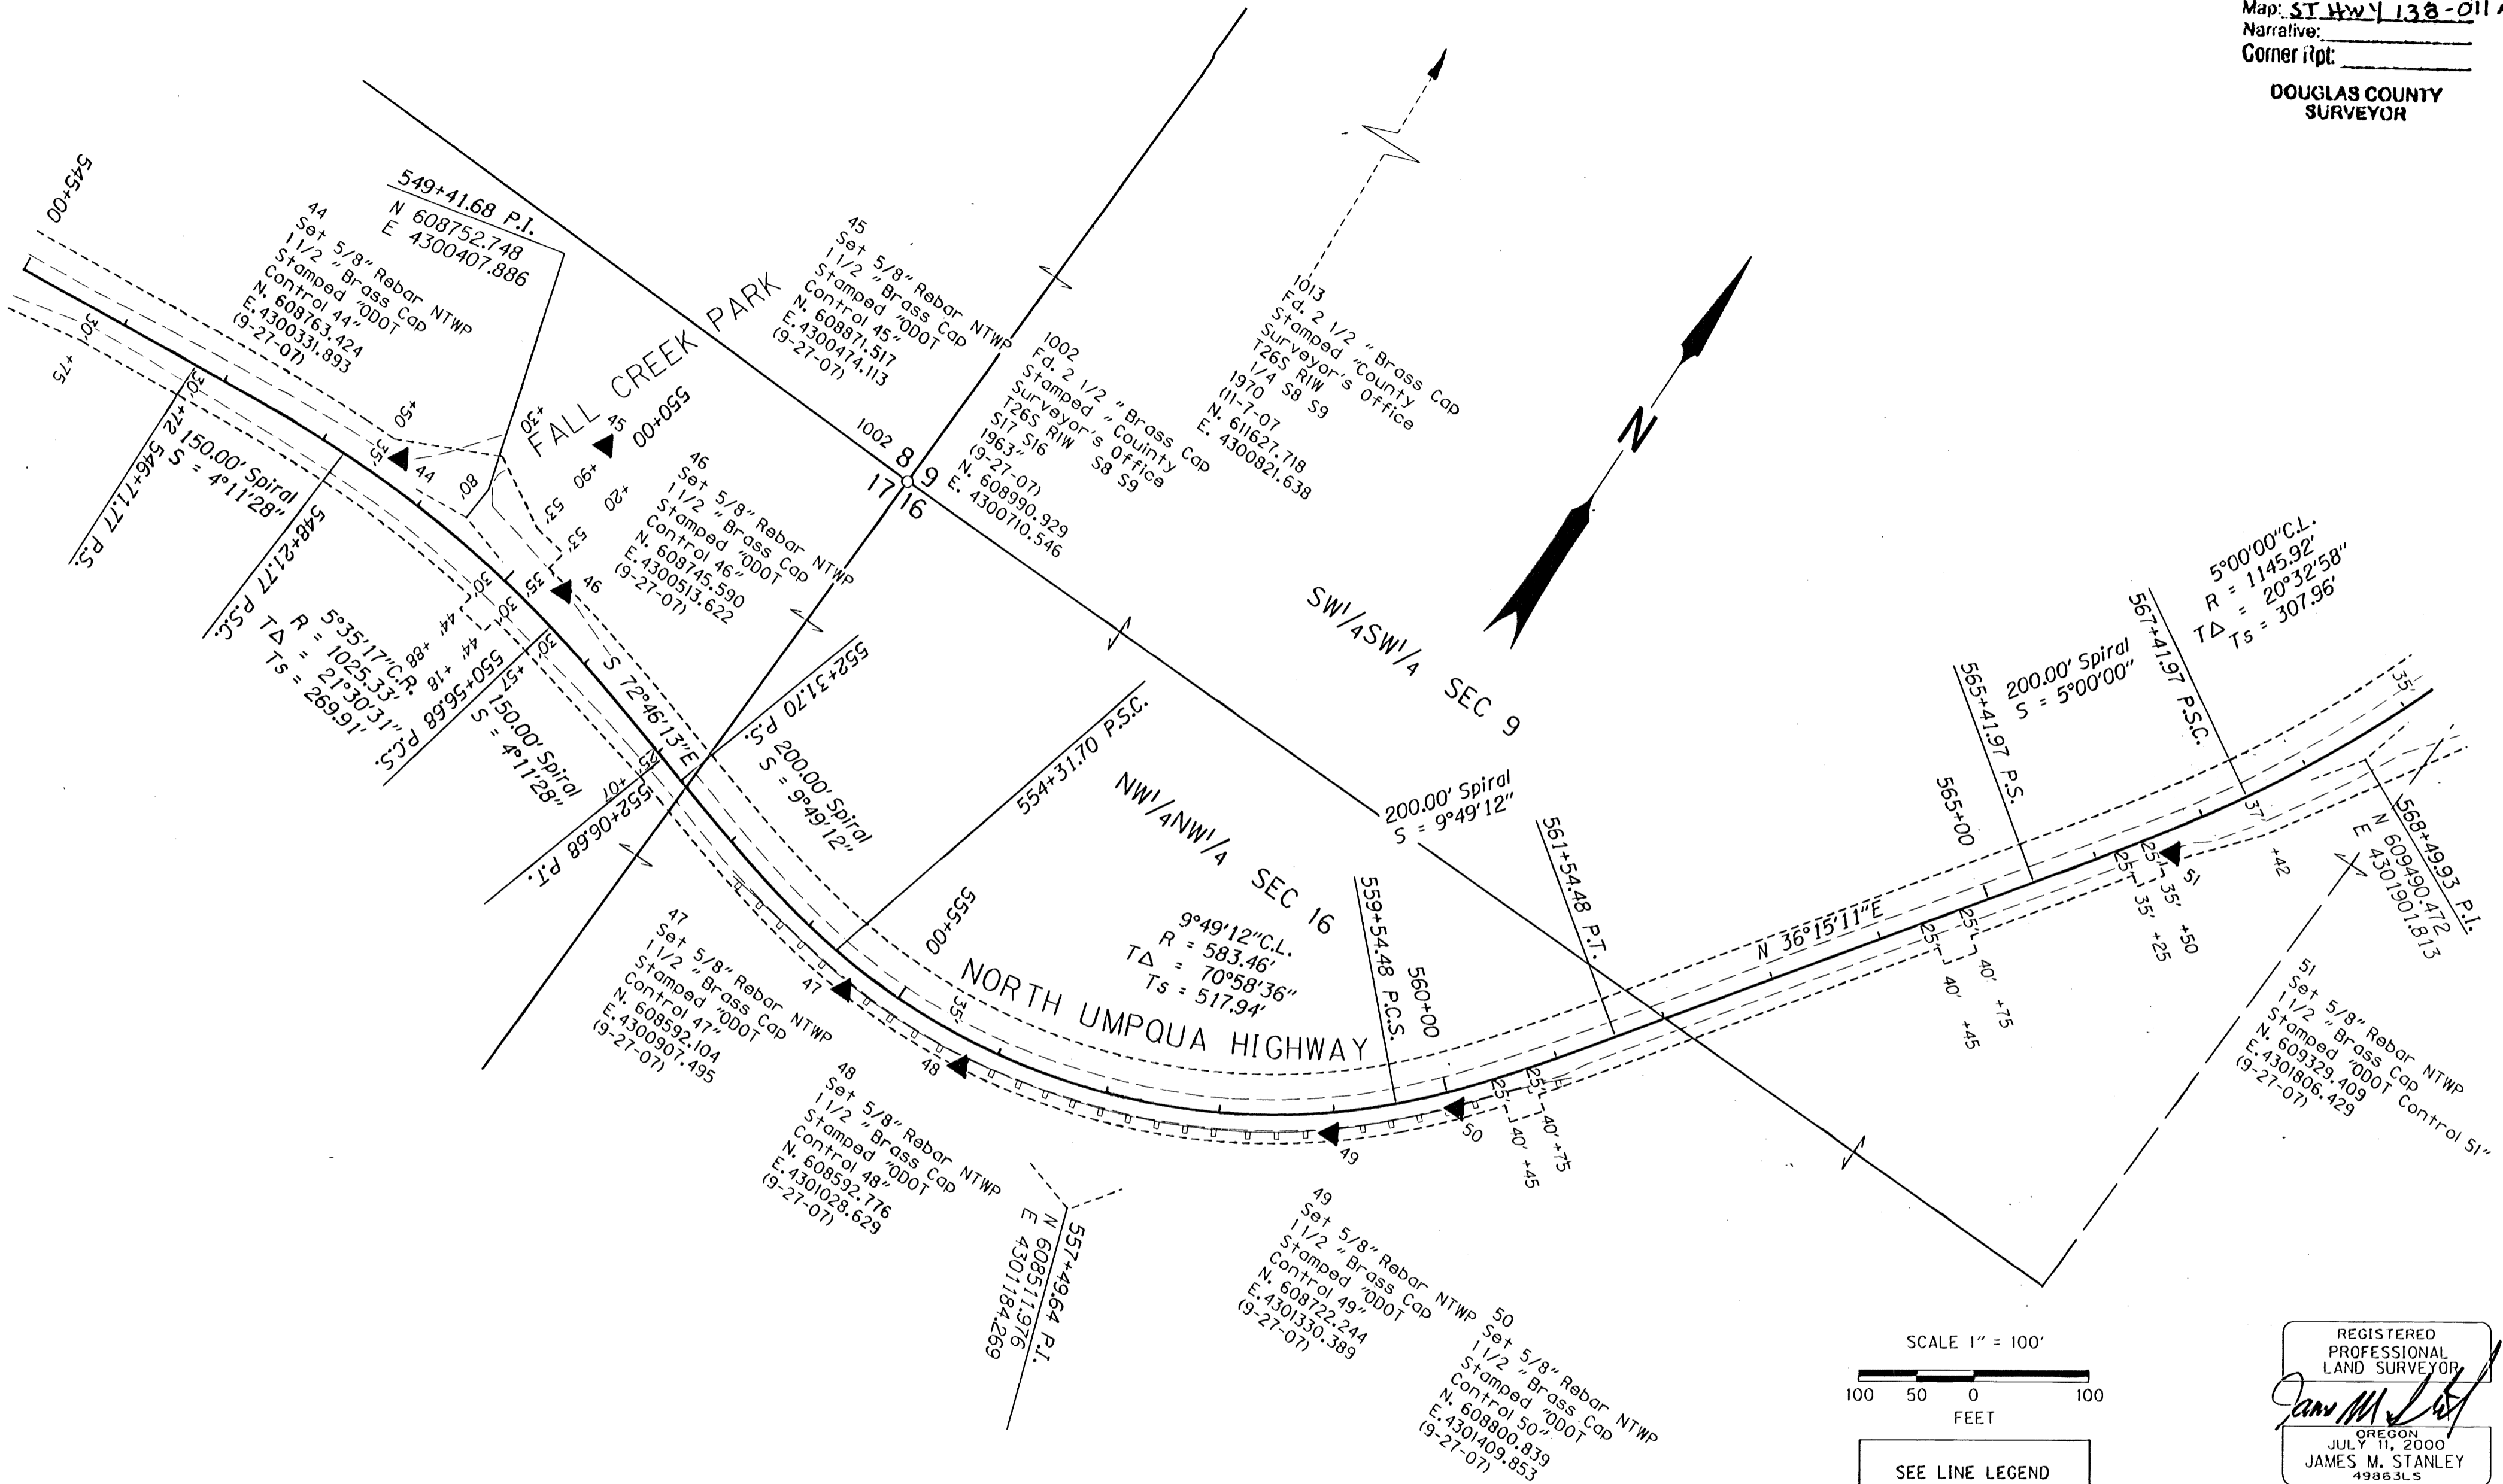

REGISTERED
 PROFESSIONAL
 LAND SURVEYOR

 OREGON
 JULY 11, 2000
 JAMES M. STANLEY
 49863LS
 EXPIRES 06/30/2010

POINT LEGEND	
★	SET GPS STATION (STABILIZED WITH CONCRETE)
▲	SET ODOT NETWORK POINT
○	FOUND MONUMENT

SEE LINE LEGEND
 ON SHEET 2

SI FEET OREGON DEPARTMENT OF TRANSPORTATION
 HORIZONTAL CONTROL, RECOVERY AND RETRACEMENT MAP
 FOREST BOUNDARY-STEAMBOAT CREEK
 NORTH UMPQUA HWY. OR138E MP 30.65-39.50
 DOUGLAS COUNTY
 File : I5205rw.dgn

FOR ODOT REGION 3
 3500 NW. STEWART PKWY.
 ROSEBURG, OR. 97470

JUNE 30, 2009
 SCALE: 1" = 100'
 SHEET 9 OF 25