
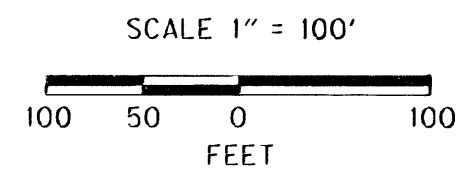
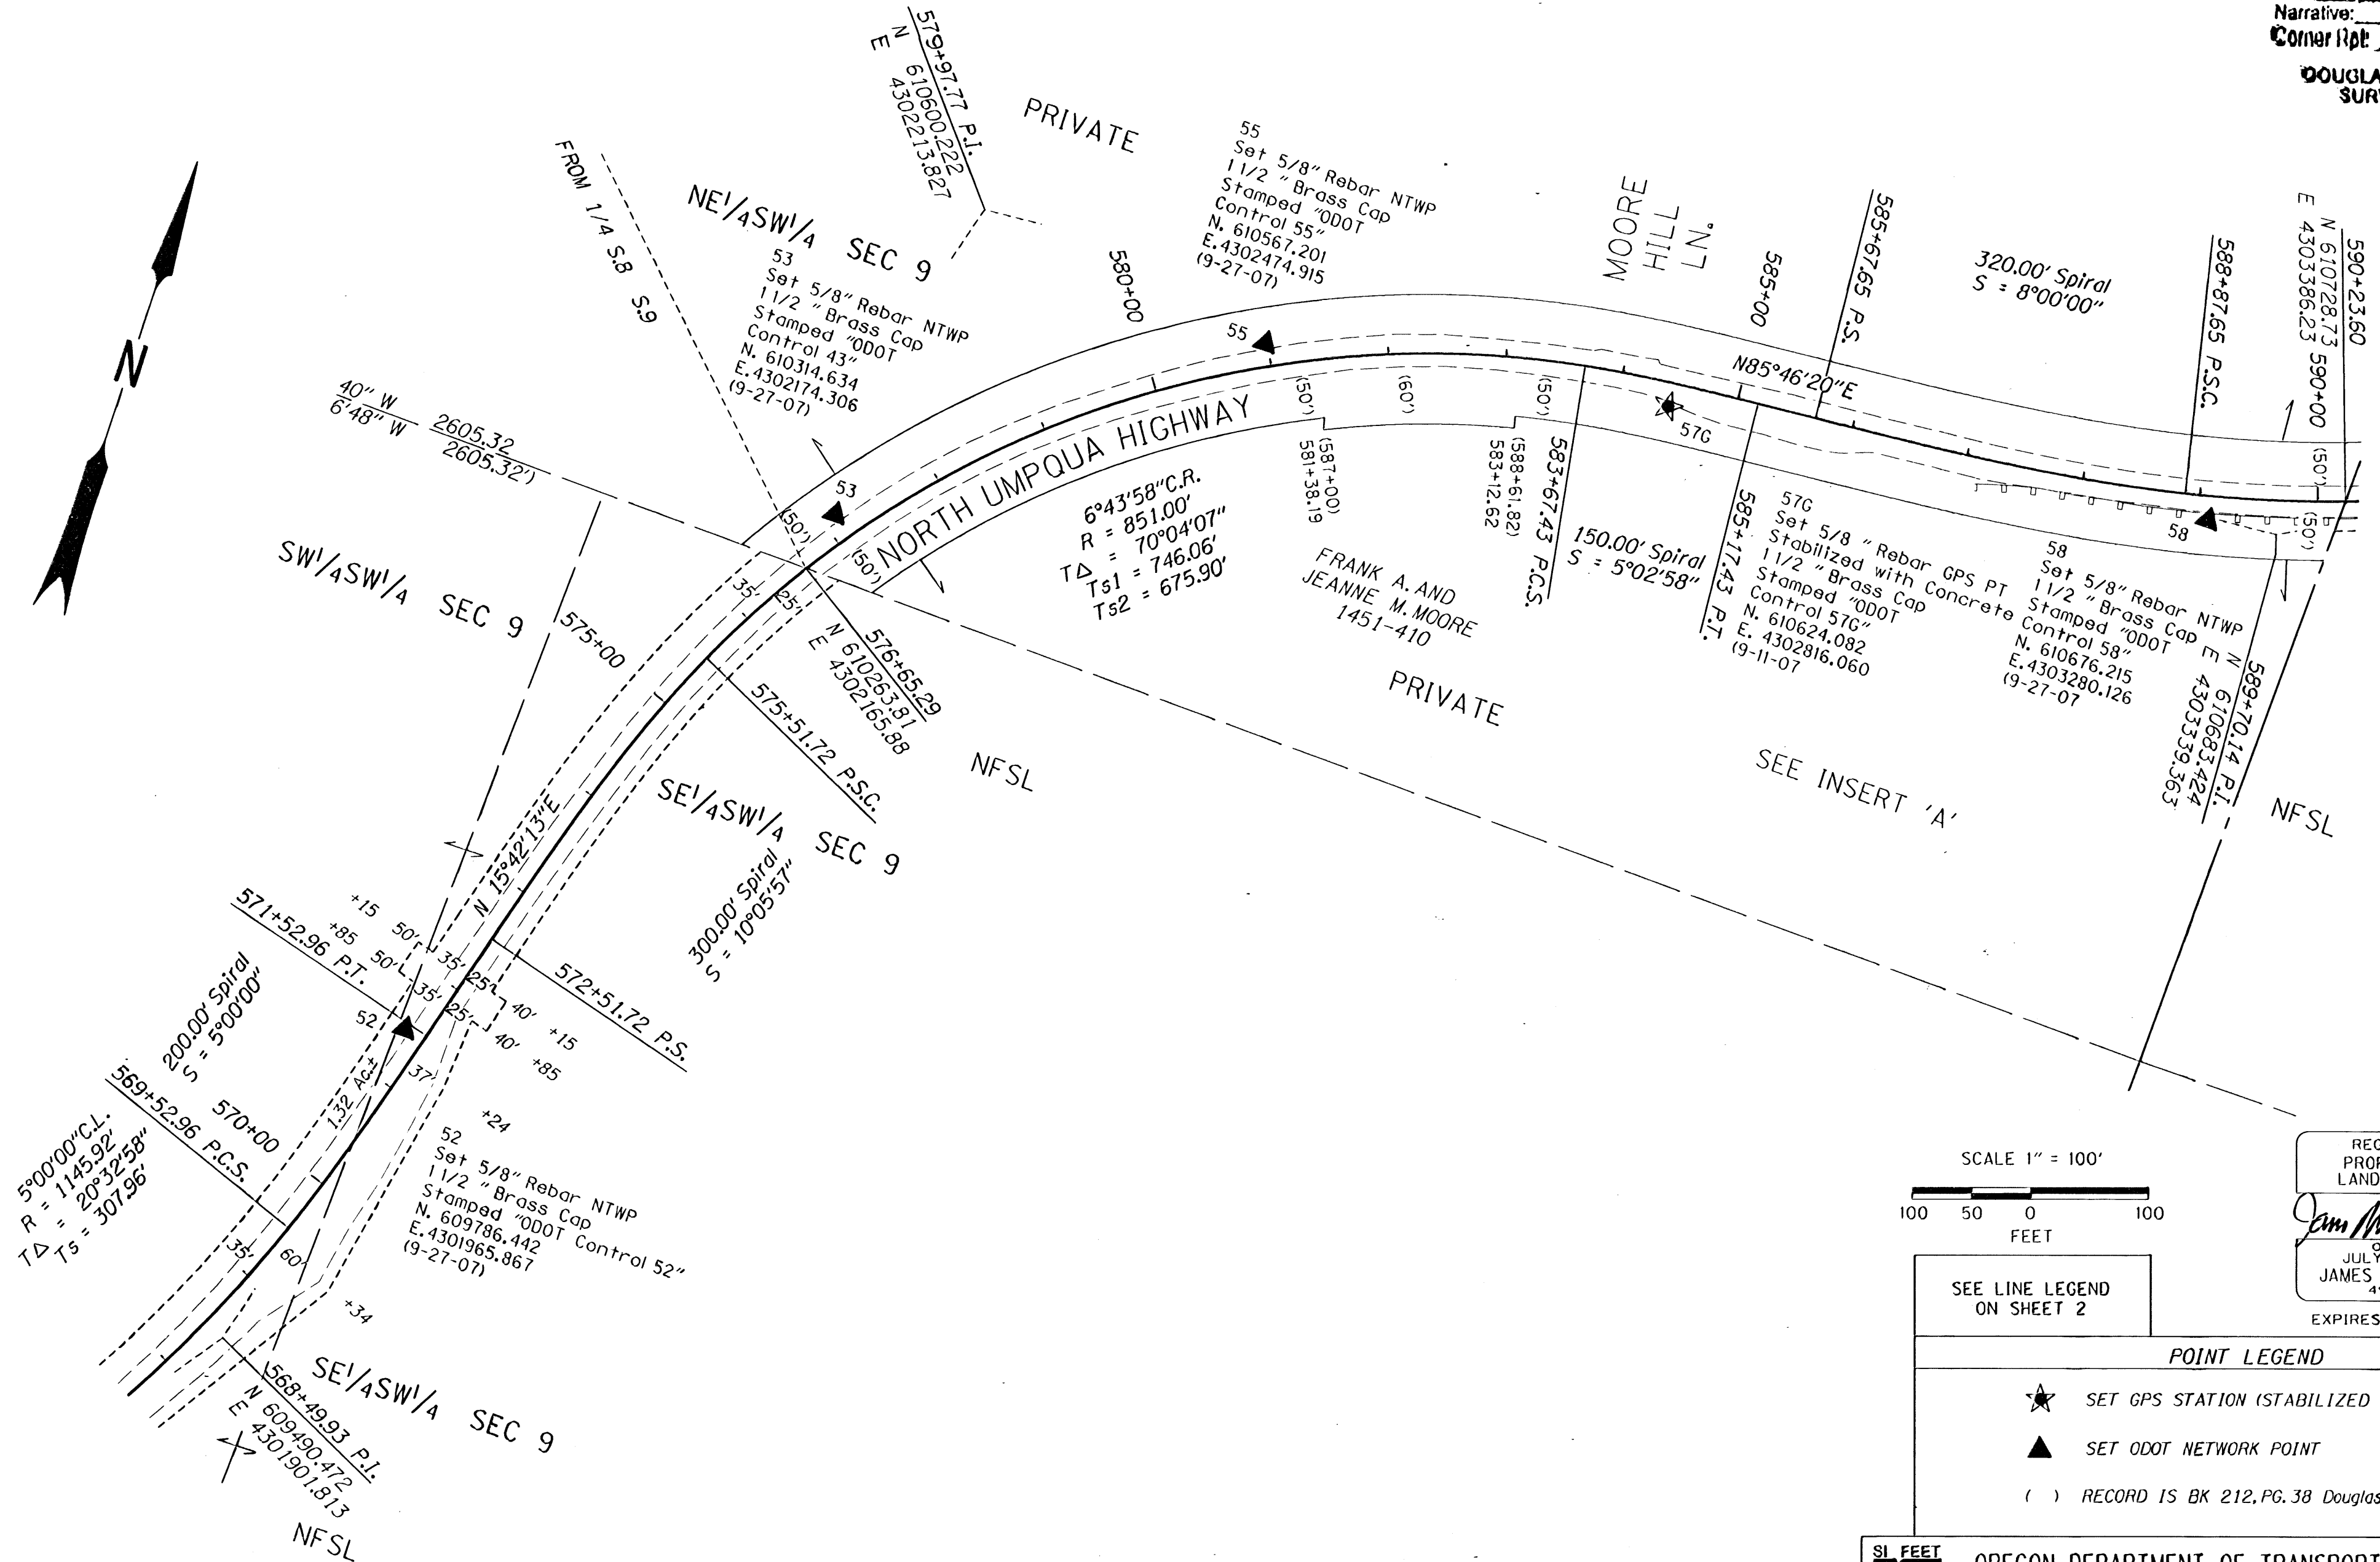


SEC. 9, T. 26 S., R. 1 W., W.M.

FILED  
Date: 7-2-2009 By: JC  
This survey consists of:  
Map: ST HWY 138-011A-Y  
Narrative:  
Corner Rpt:  
DOUGLAS COUNTY SURVEYOR

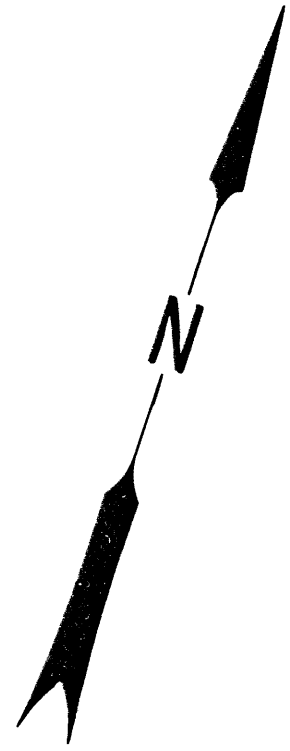

SEE LINE LEGEND ON SHEET 2

REGISTERED PROFESSIONAL LAND SURVEYOR  
*James M. Stanley*  
OREGON  
JULY 11, 2000  
JAMES M. STANLEY  
49863LS  
EXPIRES 06/30/2010

POINT LEGEND	
★	SET GPS STATION (STABILIZED WITH CONCRETE)
▲	SET ODOT NETWORK POINT
( )	RECORD IS BK 212, PG. 38 Douglas Co. Book of Records

**SI FEET** OREGON DEPARTMENT OF TRANSPORTATION  
HORIZONTAL CONTROL, RECOVERY AND RETRACEMENT MAP  
FOREST BOUNDARY-STEAMBOAT CREEK  
NORTH UMPQUA HWY. OR138E MP 30.65-39.50  
DOUGLAS COUNTY  
File : 15205r.w.dgn

FOR ODOT REGION 3  
3500 NW. STEWART PKWY.  
ROSEBURG, OR. 97470

JUNE 30, 2009  
SCALE: 1" = 100'  
SHEET 10 OF 25

ST. HWY. 138-011 J