
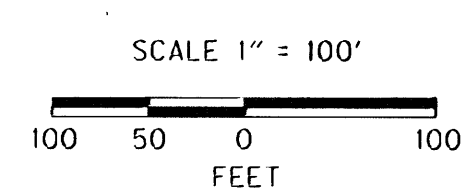
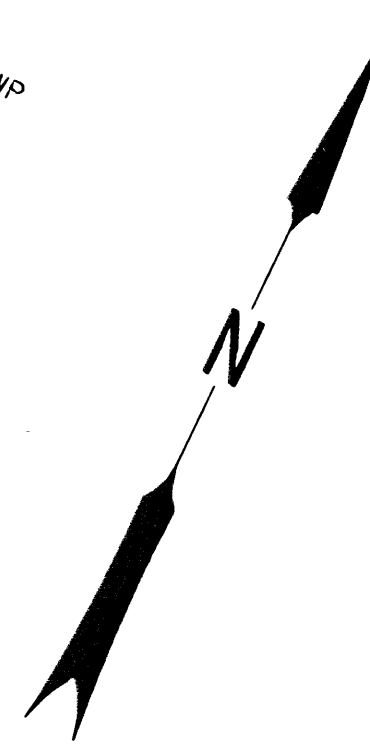


SEC. 9, T. 26 S., R. 1 W., W.M.

FILED
Date: 7/9/2009 By: JC
This survey consists of:
Map: ST HWY 138-011 A-V
Narrative:
Corner Rpt:

DOUGLAS COUNTY
SURVEYOR

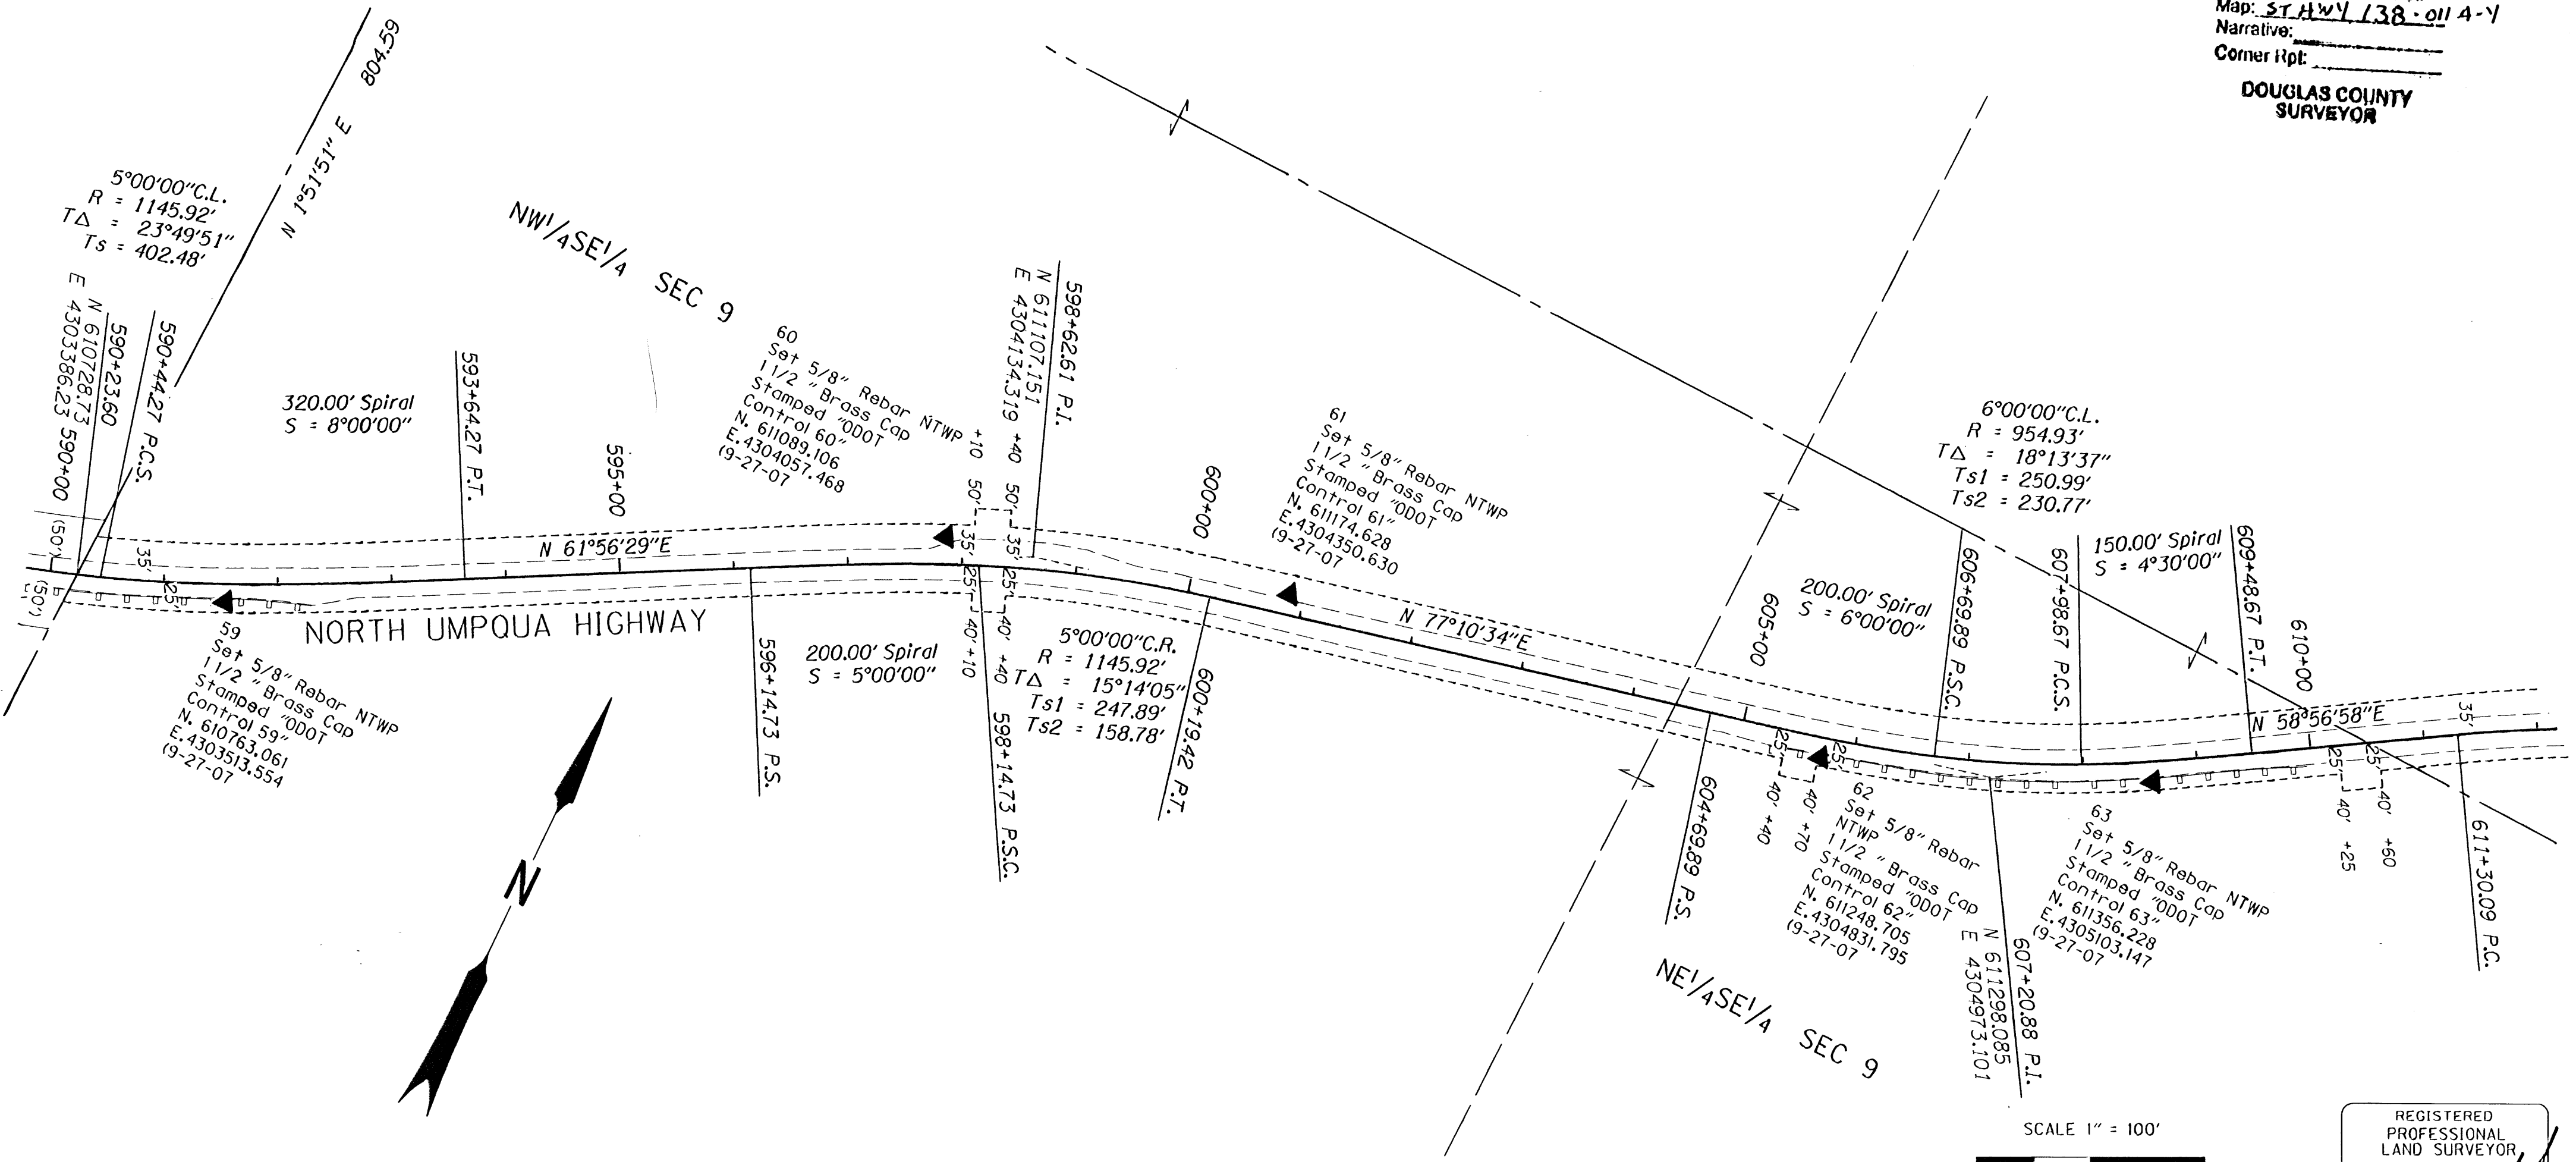

SEE LINE LEGEND
ON SHEET 2

REGISTERED
PROFESSIONAL
LAND SURVEYOR
James M. Stanley
OREGON
JULY 11, 2000
JAMES M. STANLEY
49863LS
EXPIRES 06/30/2010

POINT LEGEND	
★	SET GPS STATION (STABILIZED WITH CONCRETE)
▲	SET ODOT NETWORK POINT
○	FOUND MONUMENT

SI FEET OREGON DEPARTMENT OF TRANSPORTATION
 HORIZONTAL CONTROL, RECOVERY AND RETRACEMENT MAP
 FOREST BOUNDARY-STEAMBOAT CREEK
 NORTH UMPQUA HWY. OR138E MP 30.65-39.50
 DOUGLAS COUNTY
 File : I5205rw.dgn

FOR ODOT REGION 3
 3500 NW. STEWART PKWY.
 ROSEBURG, OR. 97470

JUNE 30, 2009
 SCALE: 1" = 100'
 SHEET 11 OF 25

ST. HWY. 138-011 K