

SEC. 10, T. 26 S., R. 1 W., W.M.

FILED
Date: 7/30/2009 By: JC
This survey consists of:
Map: ST HWY 138-011A-0
Narrative:
Corner Rpt:




DOUGLAS COUNTY
SURVEYOR

SW/4NE/4 SEC 10

NORTH UMPQUA HIGHWAY

NE/4NE/4 SEC 10


SE/4NE/4 SEC 10

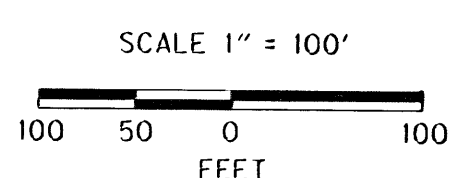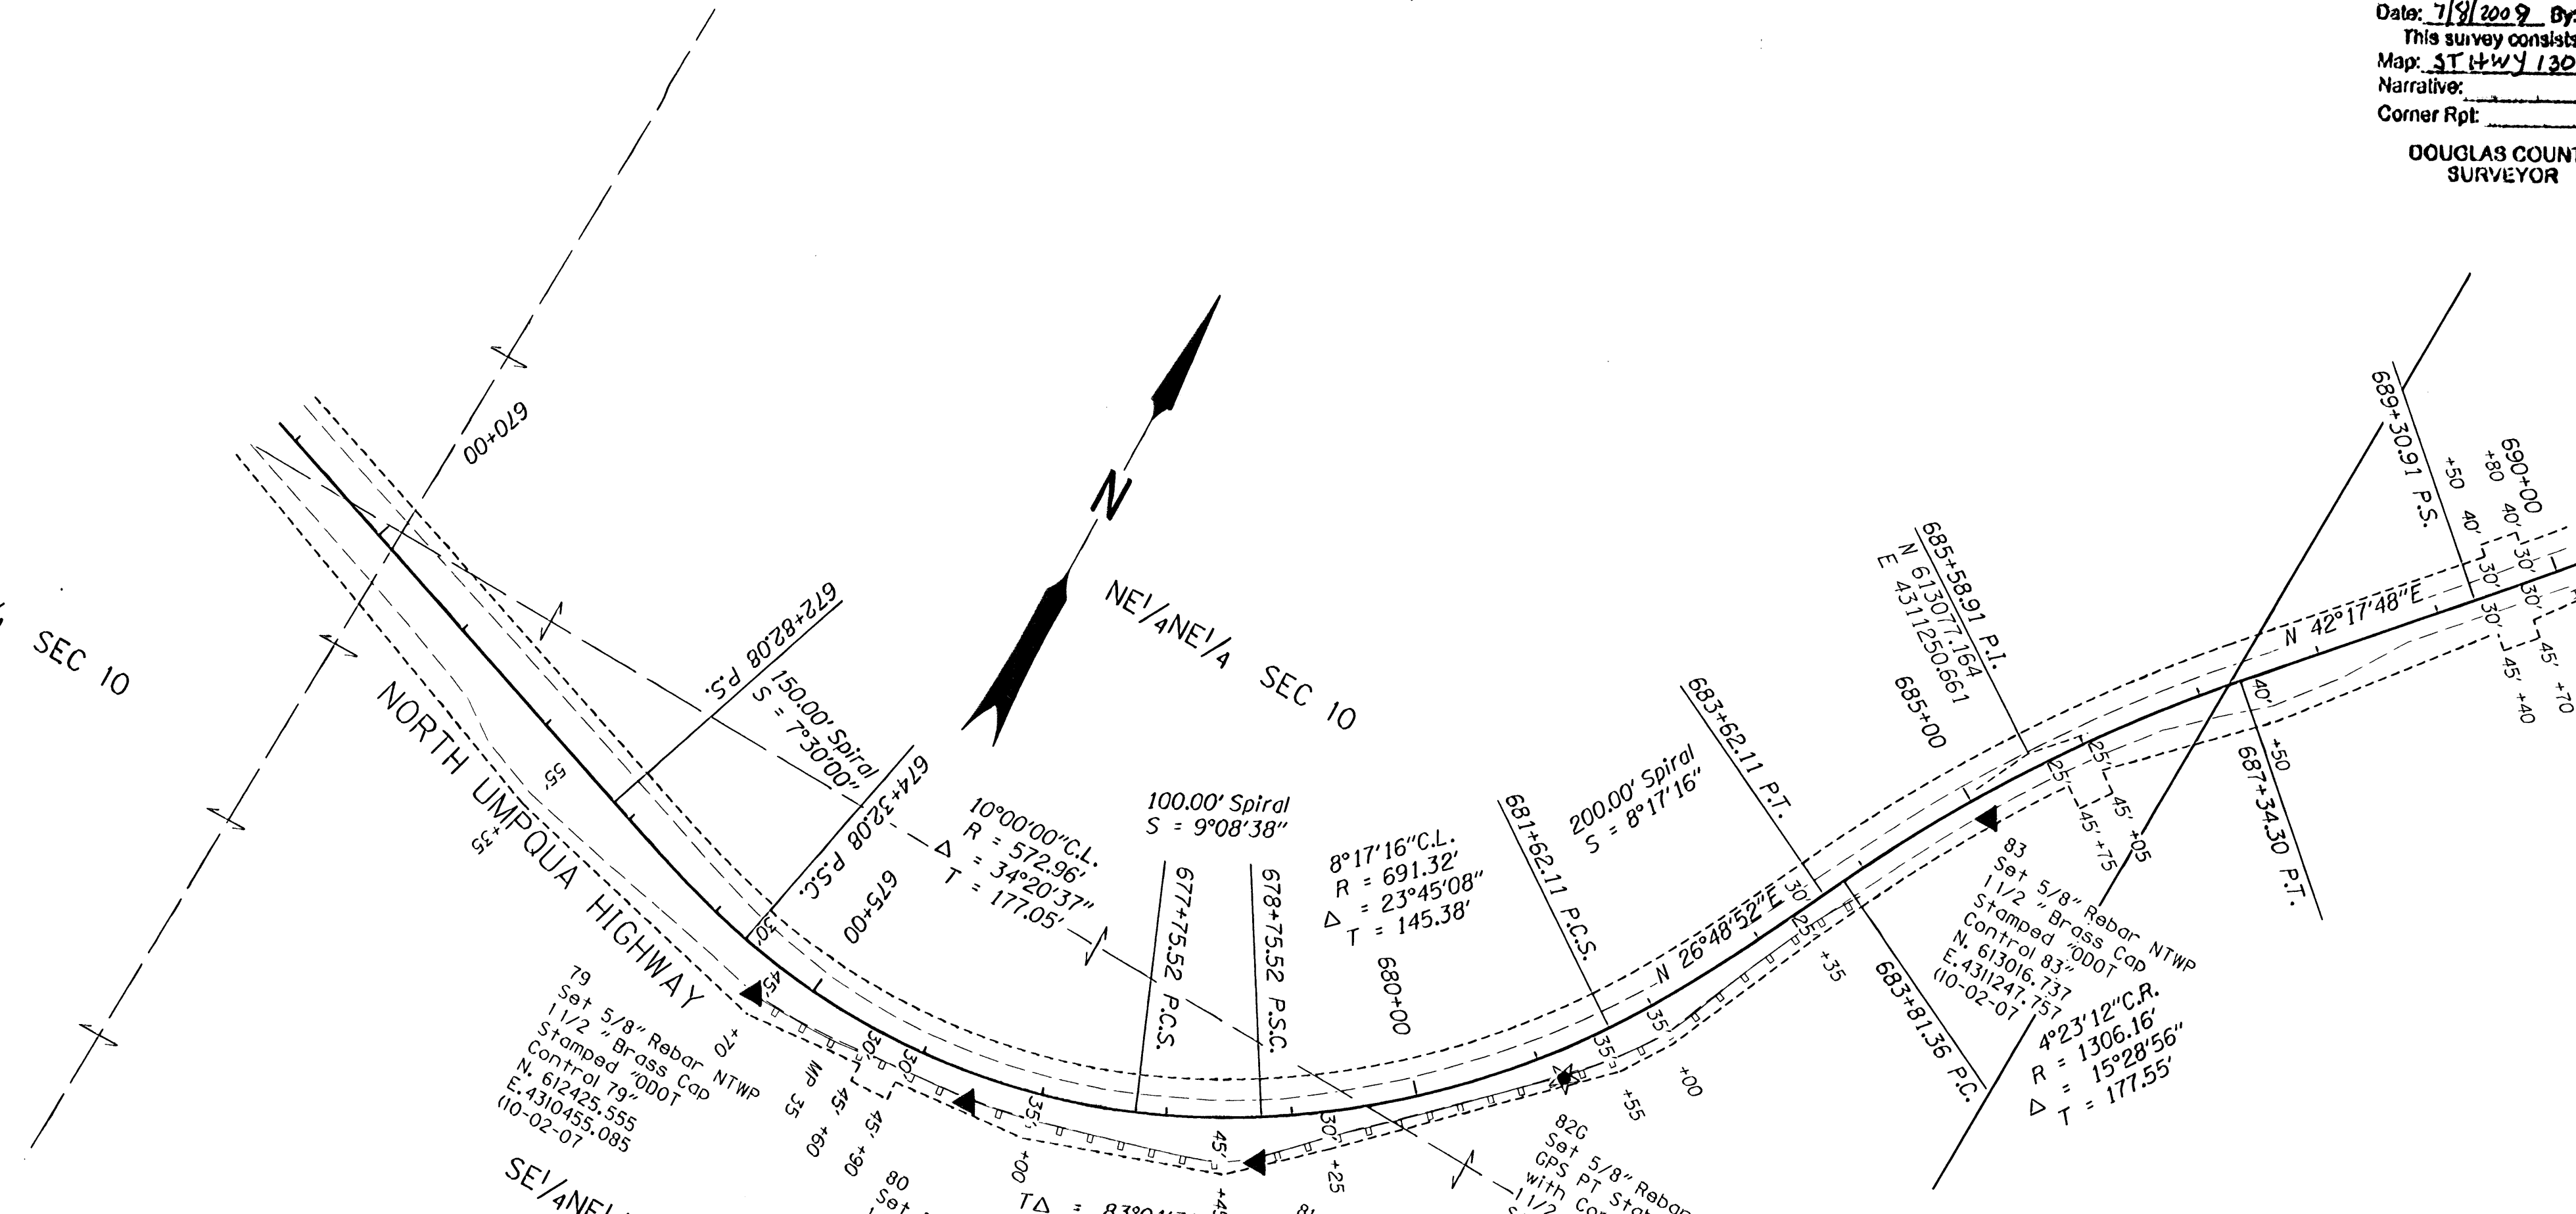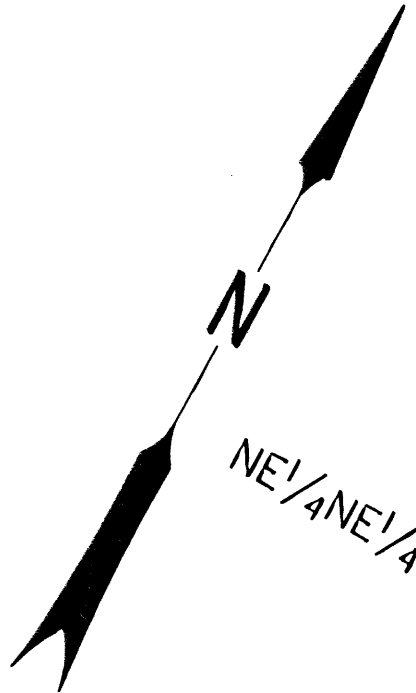

SEE LINE LEGEND
ON SHEET 2

REGISTERED
PROFESSIONAL
LAND SURVEYOR
James M. Stanley
OREGON
JULY 11, 2000
JAMES M. STANLEY
49863LS
EXPIRES 06/30/2010

POINT LEGEND	
★	SET GPS STATION (STABILIZED WITH CONCRETE)
▲	SET ODOT NETWORK POINT
○	FOUND MONUMENT

SI FEET
 OREGON DEPARTMENT OF TRANSPORTATION
HORIZONTAL CONTROL, RECOVERY AND RETRACEMENT MAP
FOREST BOUNDARY-STEAMBOAT CREEK
NORTH UMPQUA HWY. OR138E MP 30.65-39.50
DOUGLAS COUNTY
File : 15205rw.dgn

FOR ODOT REGION 3
3500 NW. STEWART PKWY.
ROSEBURG, OR. 97470

JUNE 30, 2009
SCALE: 1" = 100'
SHEET 15 OF 25

ST. HWY. 138-011 0