
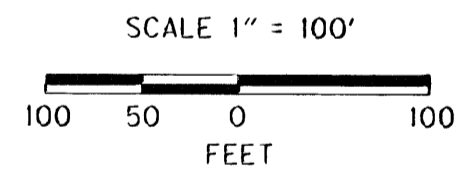
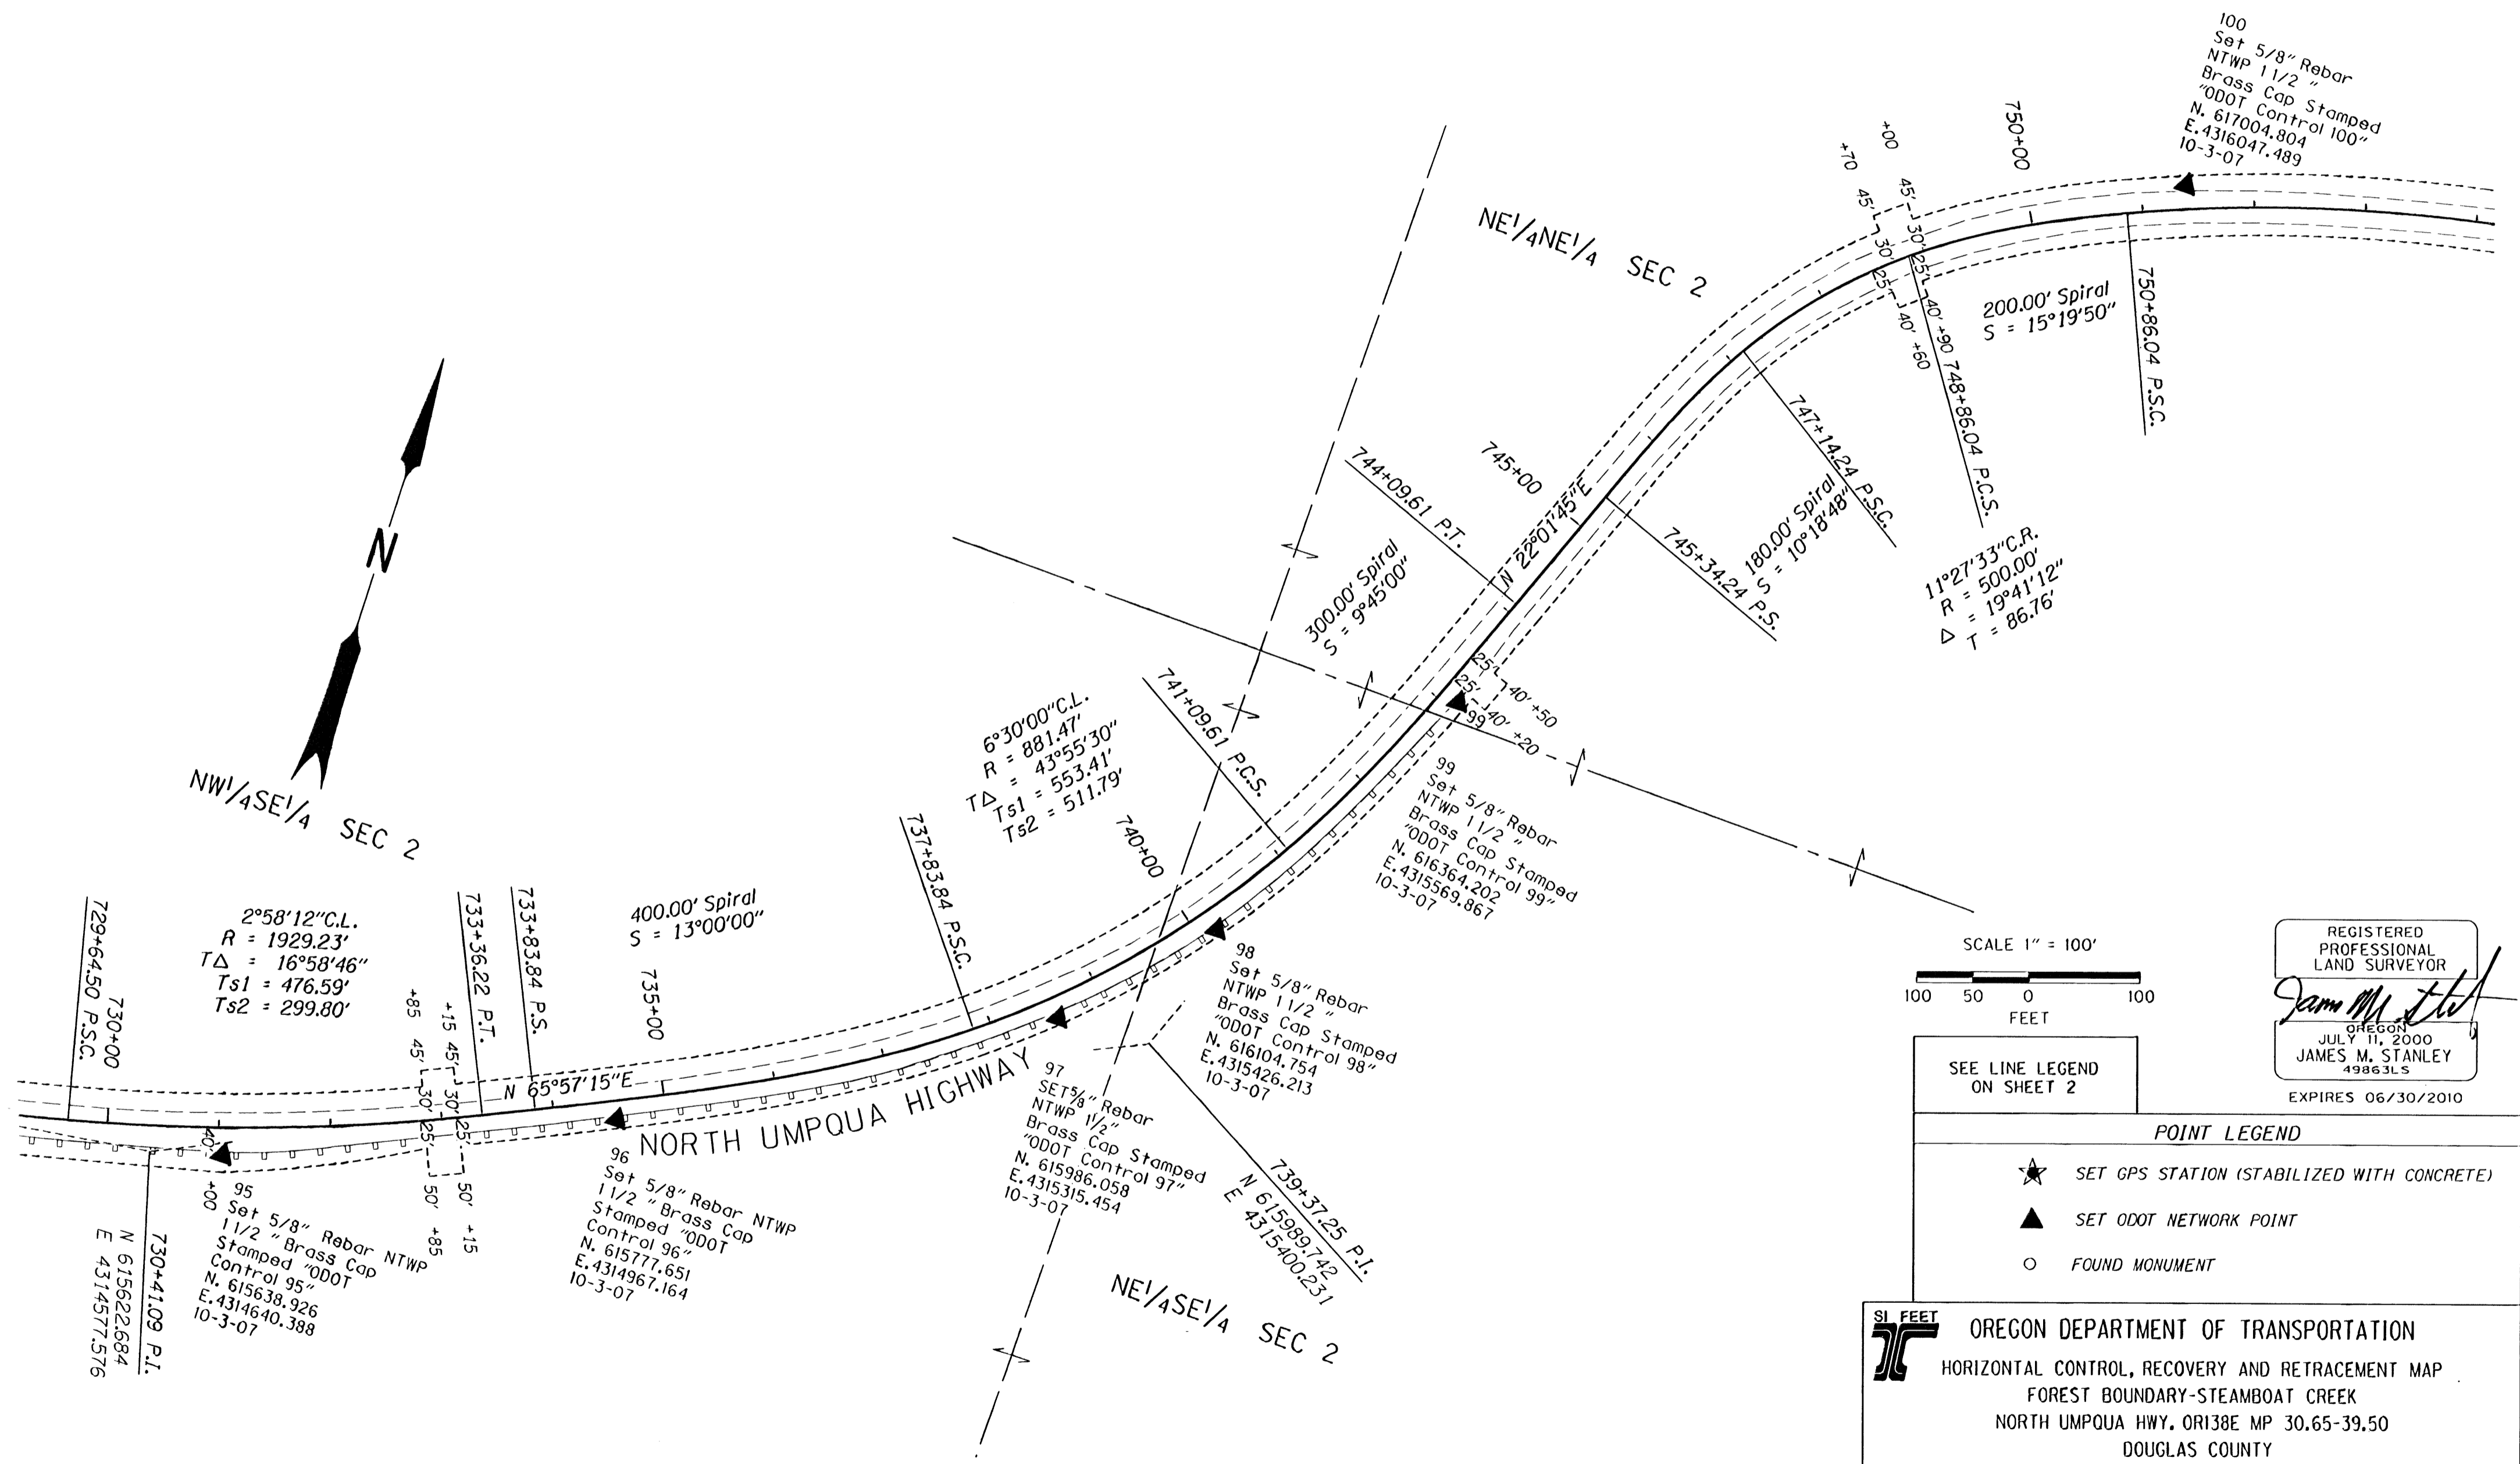


SEC. 2, T. 26 S., R. 1 W., W.M.

FILED  
Date: 7/3/2009 By: J.C.  
This survey consists of:  
Map: ST HWY 138-011A-4  
Narrative:  
Corner Rpt:

DOUGLAS COUNTY  
SURVEYOR

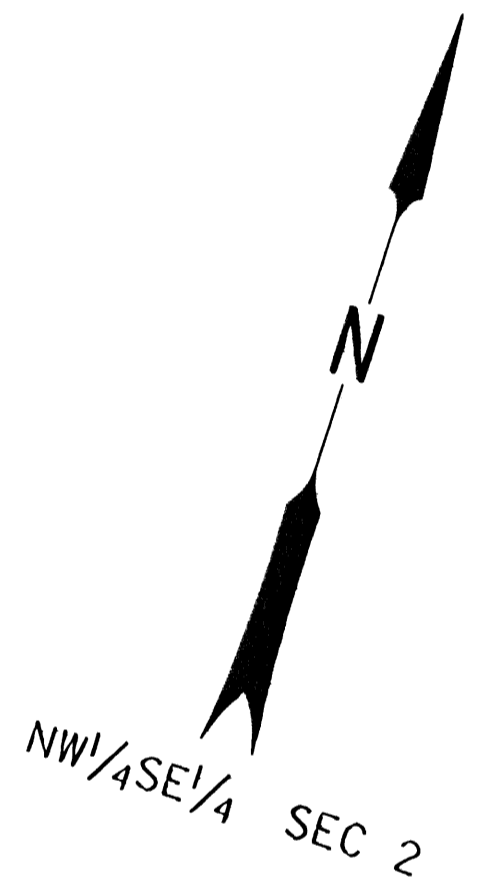

SEE LINE LEGEND  
ON SHEET 2

REGISTERED  
PROFESSIONAL  
LAND SURVEYOR

*James M. Stanley*

OREGON  
JULY 11, 2000  
JAMES M. STANLEY  
49863LS  
EXPIRES 06/30/2010

POINT LEGEND

★	SET GPS STATION (STABILIZED WITH CONCRETE)
▲	SET ODOT NETWORK POINT
○	FOUND MONUMENT

SI FEET OREGON DEPARTMENT OF TRANSPORTATION  
HORIZONTAL CONTROL, RECOVERY AND RETRACEMENT MAP  
FOREST BOUNDARY-STEAMBOAT CREEK  
NORTH UMPQUA HWY. OR138E MP 30.65-39.50  
DOUGLAS COUNTY  
File : 15205rw.dgn

FOR ODOT REGION 3  
3500 NW. STEWART PKWY.  
ROSEBURG, OR. 97470

JUNE 30, 2009  
SCALE: 1" = 100'  
SHEET 18 OF 25

ST. HWY. 138-011 R