
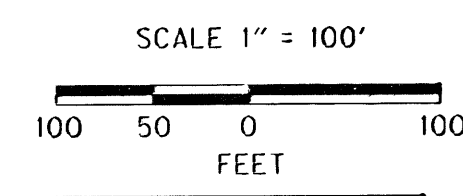


SEC. 1, T. 26 S., R. 1 W., W.M.

FILED
Date: 7/8/2009 By: J.C.
This survey consists of:
Map: ST HWY 138-011A-7
Narrative:
Corner Rpt:
DOUGLAS COUNTY
SURVEYOR

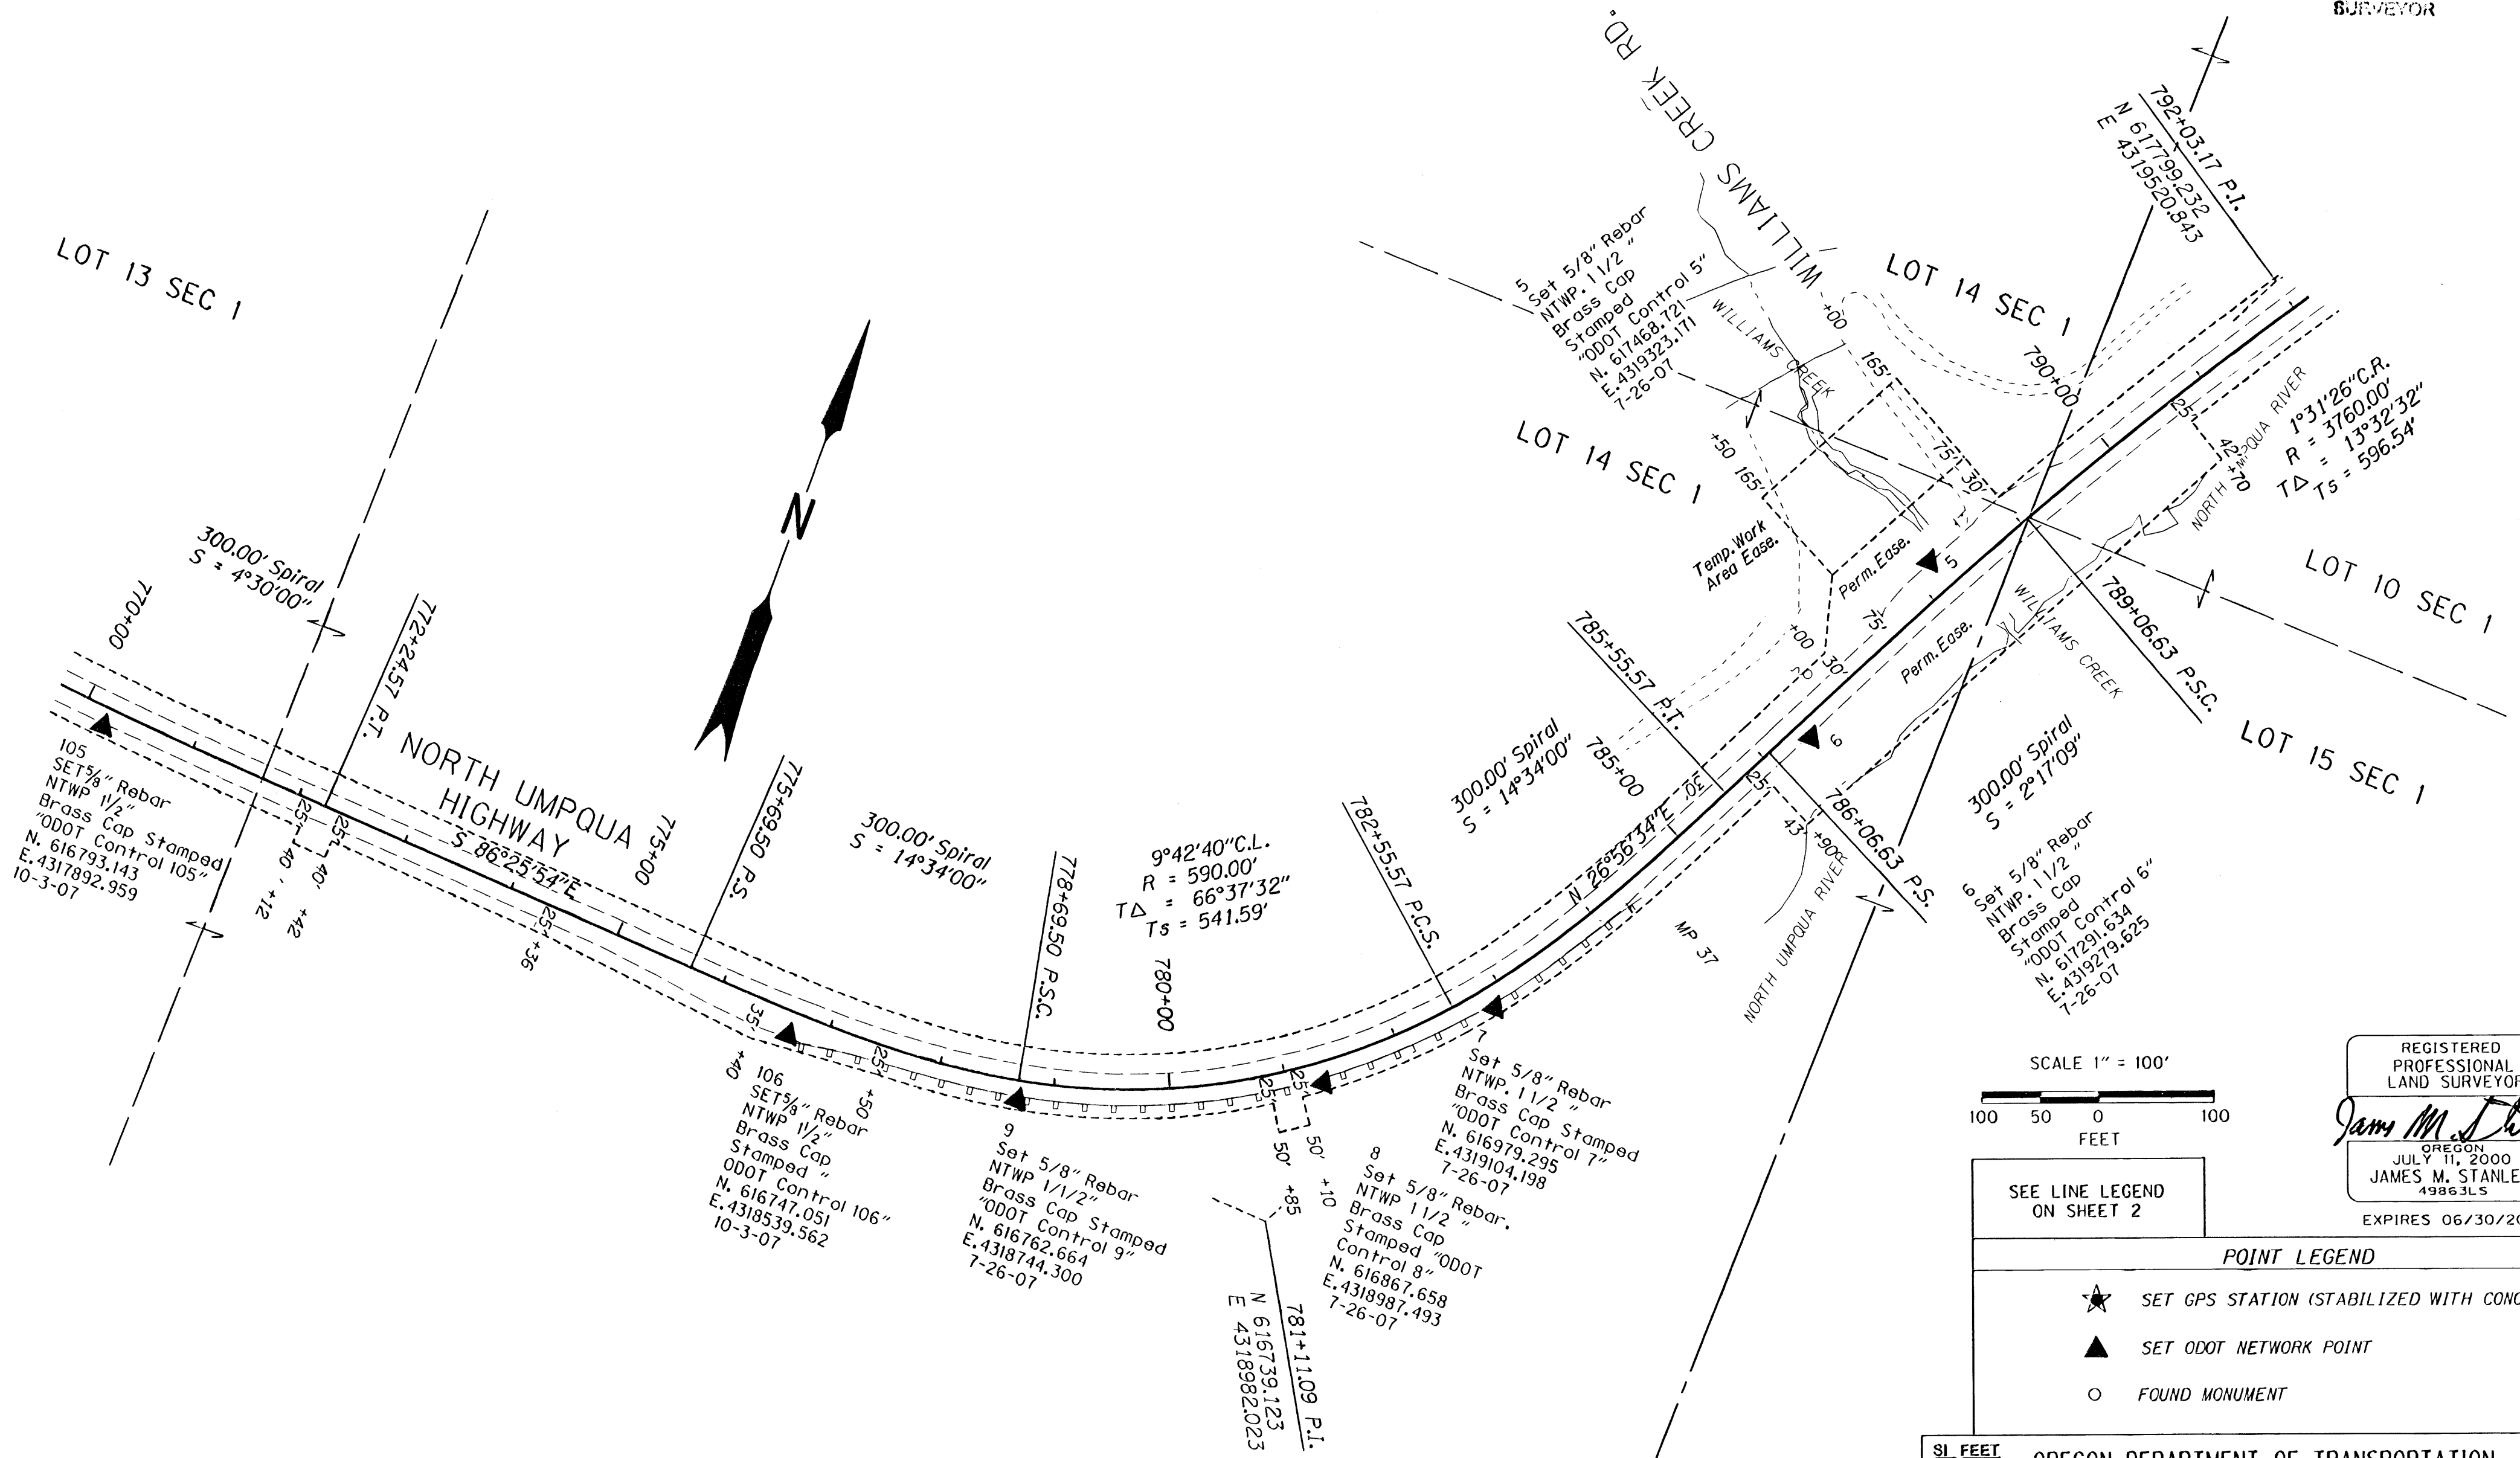

REGISTERED
PROFESSIONAL
LAND SURVEYOR
James M. Stanley
JULY 11, 2000
JAMES M. STANLEY
49863LS
EXPIRES 06/30/2010

SEE LINE LEGEND
ON SHEET 2

POINT LEGEND	
★	SET GPS STATION (STABILIZED WITH CONCRETE)
▲	SET ODOT NETWORK POINT
○	FOUND MONUMENT

SI FEET OREGON DEPARTMENT OF TRANSPORTATION
HORIZONTAL CONTROL, RECOVERY AND RETRACEMENT MAP
FOREST BOUNDARY-STEAMBOAT CREEK
NORTH UMPQUA HWY. OR138E MP 30.65-39.50
DOUGLAS COUNTY
File : 15205rw.dgn

FOR ODOT REGION 3
3500 NW. STEWART PKWY.
ROSEBURG, OR. 97470
JUNE 30, 2009
SCALE: 1" = 100'
SHEET 20 OF 25

ST. HWY. 138-011 T