
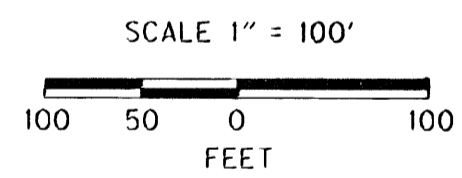


SEC. 1, T. 26 S., R. 1 W., W.M.

FILED
Date: 7/3/2009 By: JC
This survey consists of
Map: ST HWY 138-011 A-Y
Narrative:
Corner Rpt.:

DOUGLAS COUNTY
SURVEYOR

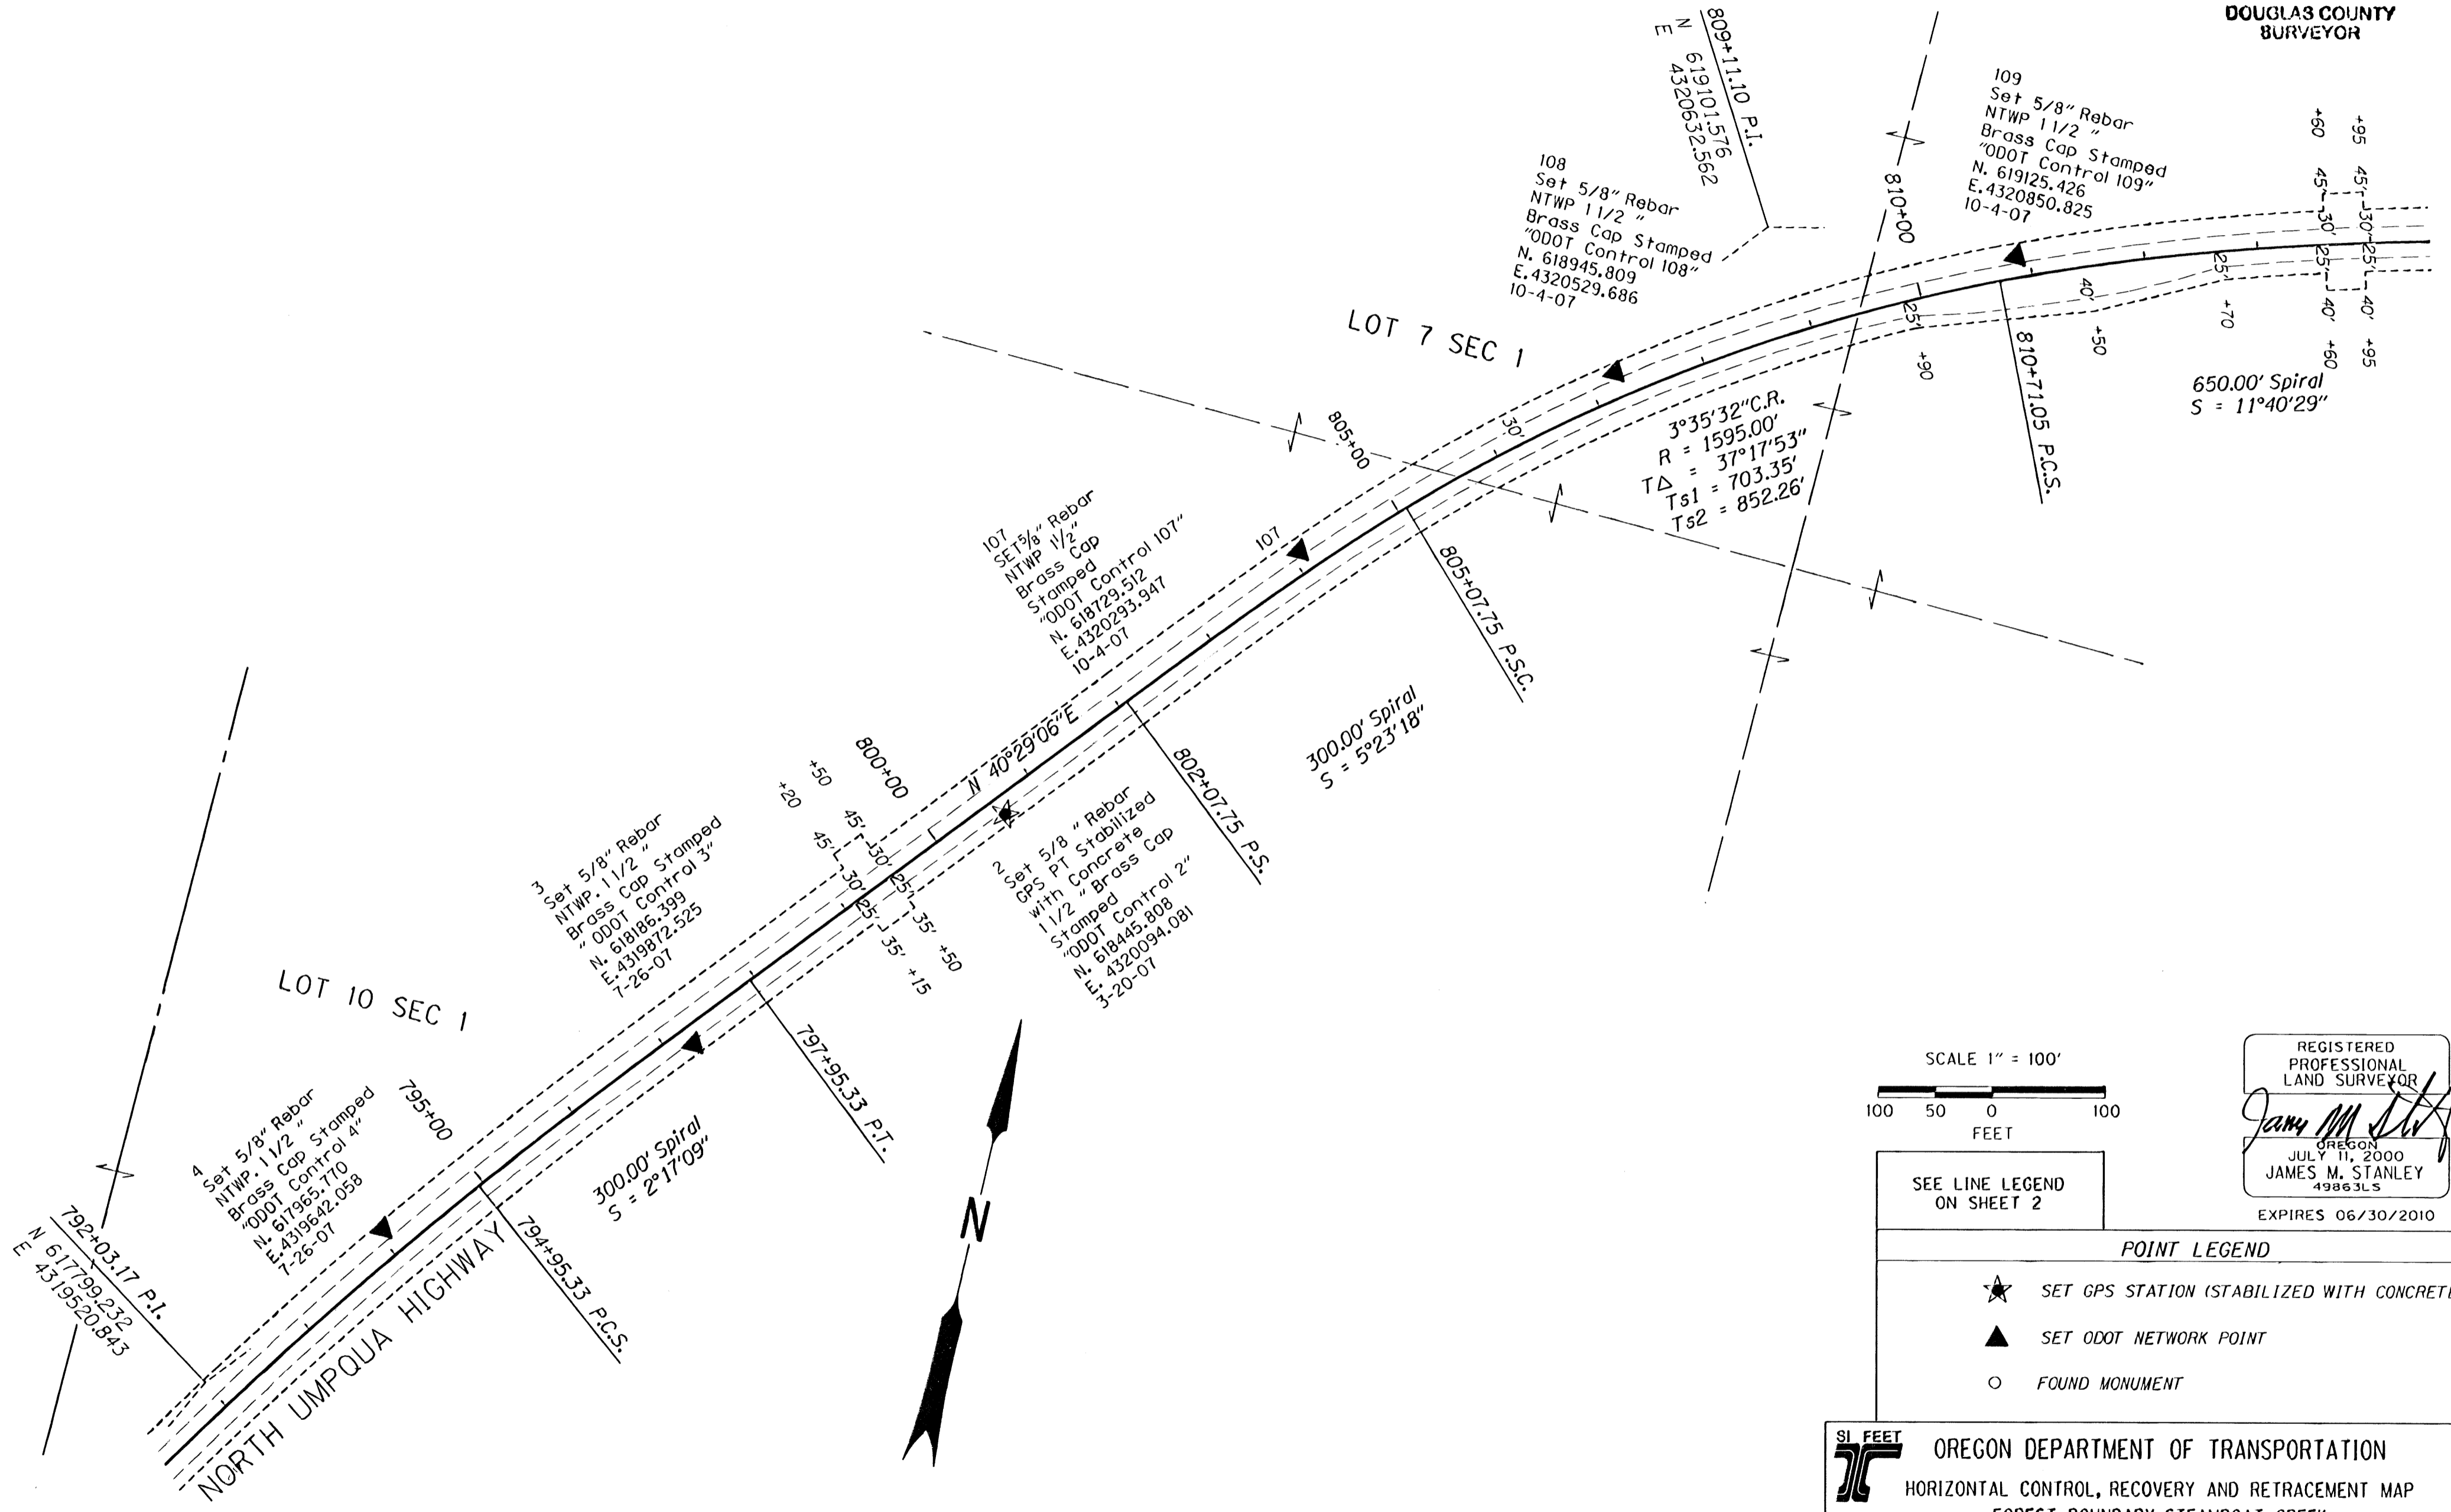

REGISTERED
PROFESSIONAL
LAND SURVEYOR
James M. Stanley
JAMES M. STANLEY
49863LS
EXPIRES 06/30/2010

SEE LINE LEGEND
ON SHEET 2

POINT LEGEND	
★	SET GPS STATION (STABILIZED WITH CONCRETE)
▲	SET ODOT NETWORK POINT
○	FOUND MONUMENT

SI FEET OREGON DEPARTMENT OF TRANSPORTATION
HORIZONTAL CONTROL, RECOVERY AND RETRACEMENT MAP
FOREST BOUNDARY-STEAMBOAT CREEK
NORTH UMPQUA HWY, ORI38E MP 30.65-39.50
DOUGLAS COUNTY
File : I5205rw.dgn

FOR ODOT REGION 3
3500 NW. STEWART PKWY.
ROSEBURG, OR. 97470

JUNE 30, 2009
SCALE: 1" = 100'
SHEET 21 OF 25

ST. HWY. 138-011 U