


SEC. 31, T. 25 1/2 S., R. 1 E., W.M.
 SEC. 6, T. 25 S., R. 1 E., W.M.

FILED
 Date: 7/31/2009 By: JC
 This survey consists of
 Map: ST HWY 138-011 A-Y
 Narrative:
 Corner Rpt:
 DOUGLAS COUNTY
 SURVEYOR

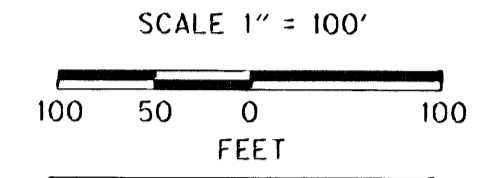

REGISTERED
 PROFESSIONAL
 LAND SURVEYOR
James M. Stanley
 OREGON
 JULY 11, 2000
 JAMES M. STANLEY
 49863LS

EXPIRES 06/30/2010

SEE LINE LEGEND
 ON SHEET 2

POINT LEGEND


- ★ SET GPS STATION (STABILIZED WITH CONCRETE)
- ▲ SET ODOT NETWORK POINT
- FOUND MONUMENT



OREGON DEPARTMENT OF TRANSPORTATION
 HORIZONTAL CONTROL, RECOVERY AND RETRACEMENT MAP
 FOREST BOUNDARY-STEAMBOAT CREEK
 NORTH UMPQUA HWY. OR138E MP 30.65-39.50
 DOUGLAS COUNTY
 File : I5205rw.dgn

FOR ODOT REGION 3
 3500 NW. STEWART PKWY.
 ROSEBURG, OR. 97470

JUNE 30, 2009
 SCALE: 1" = 100'
 SHEET 25 OF 25

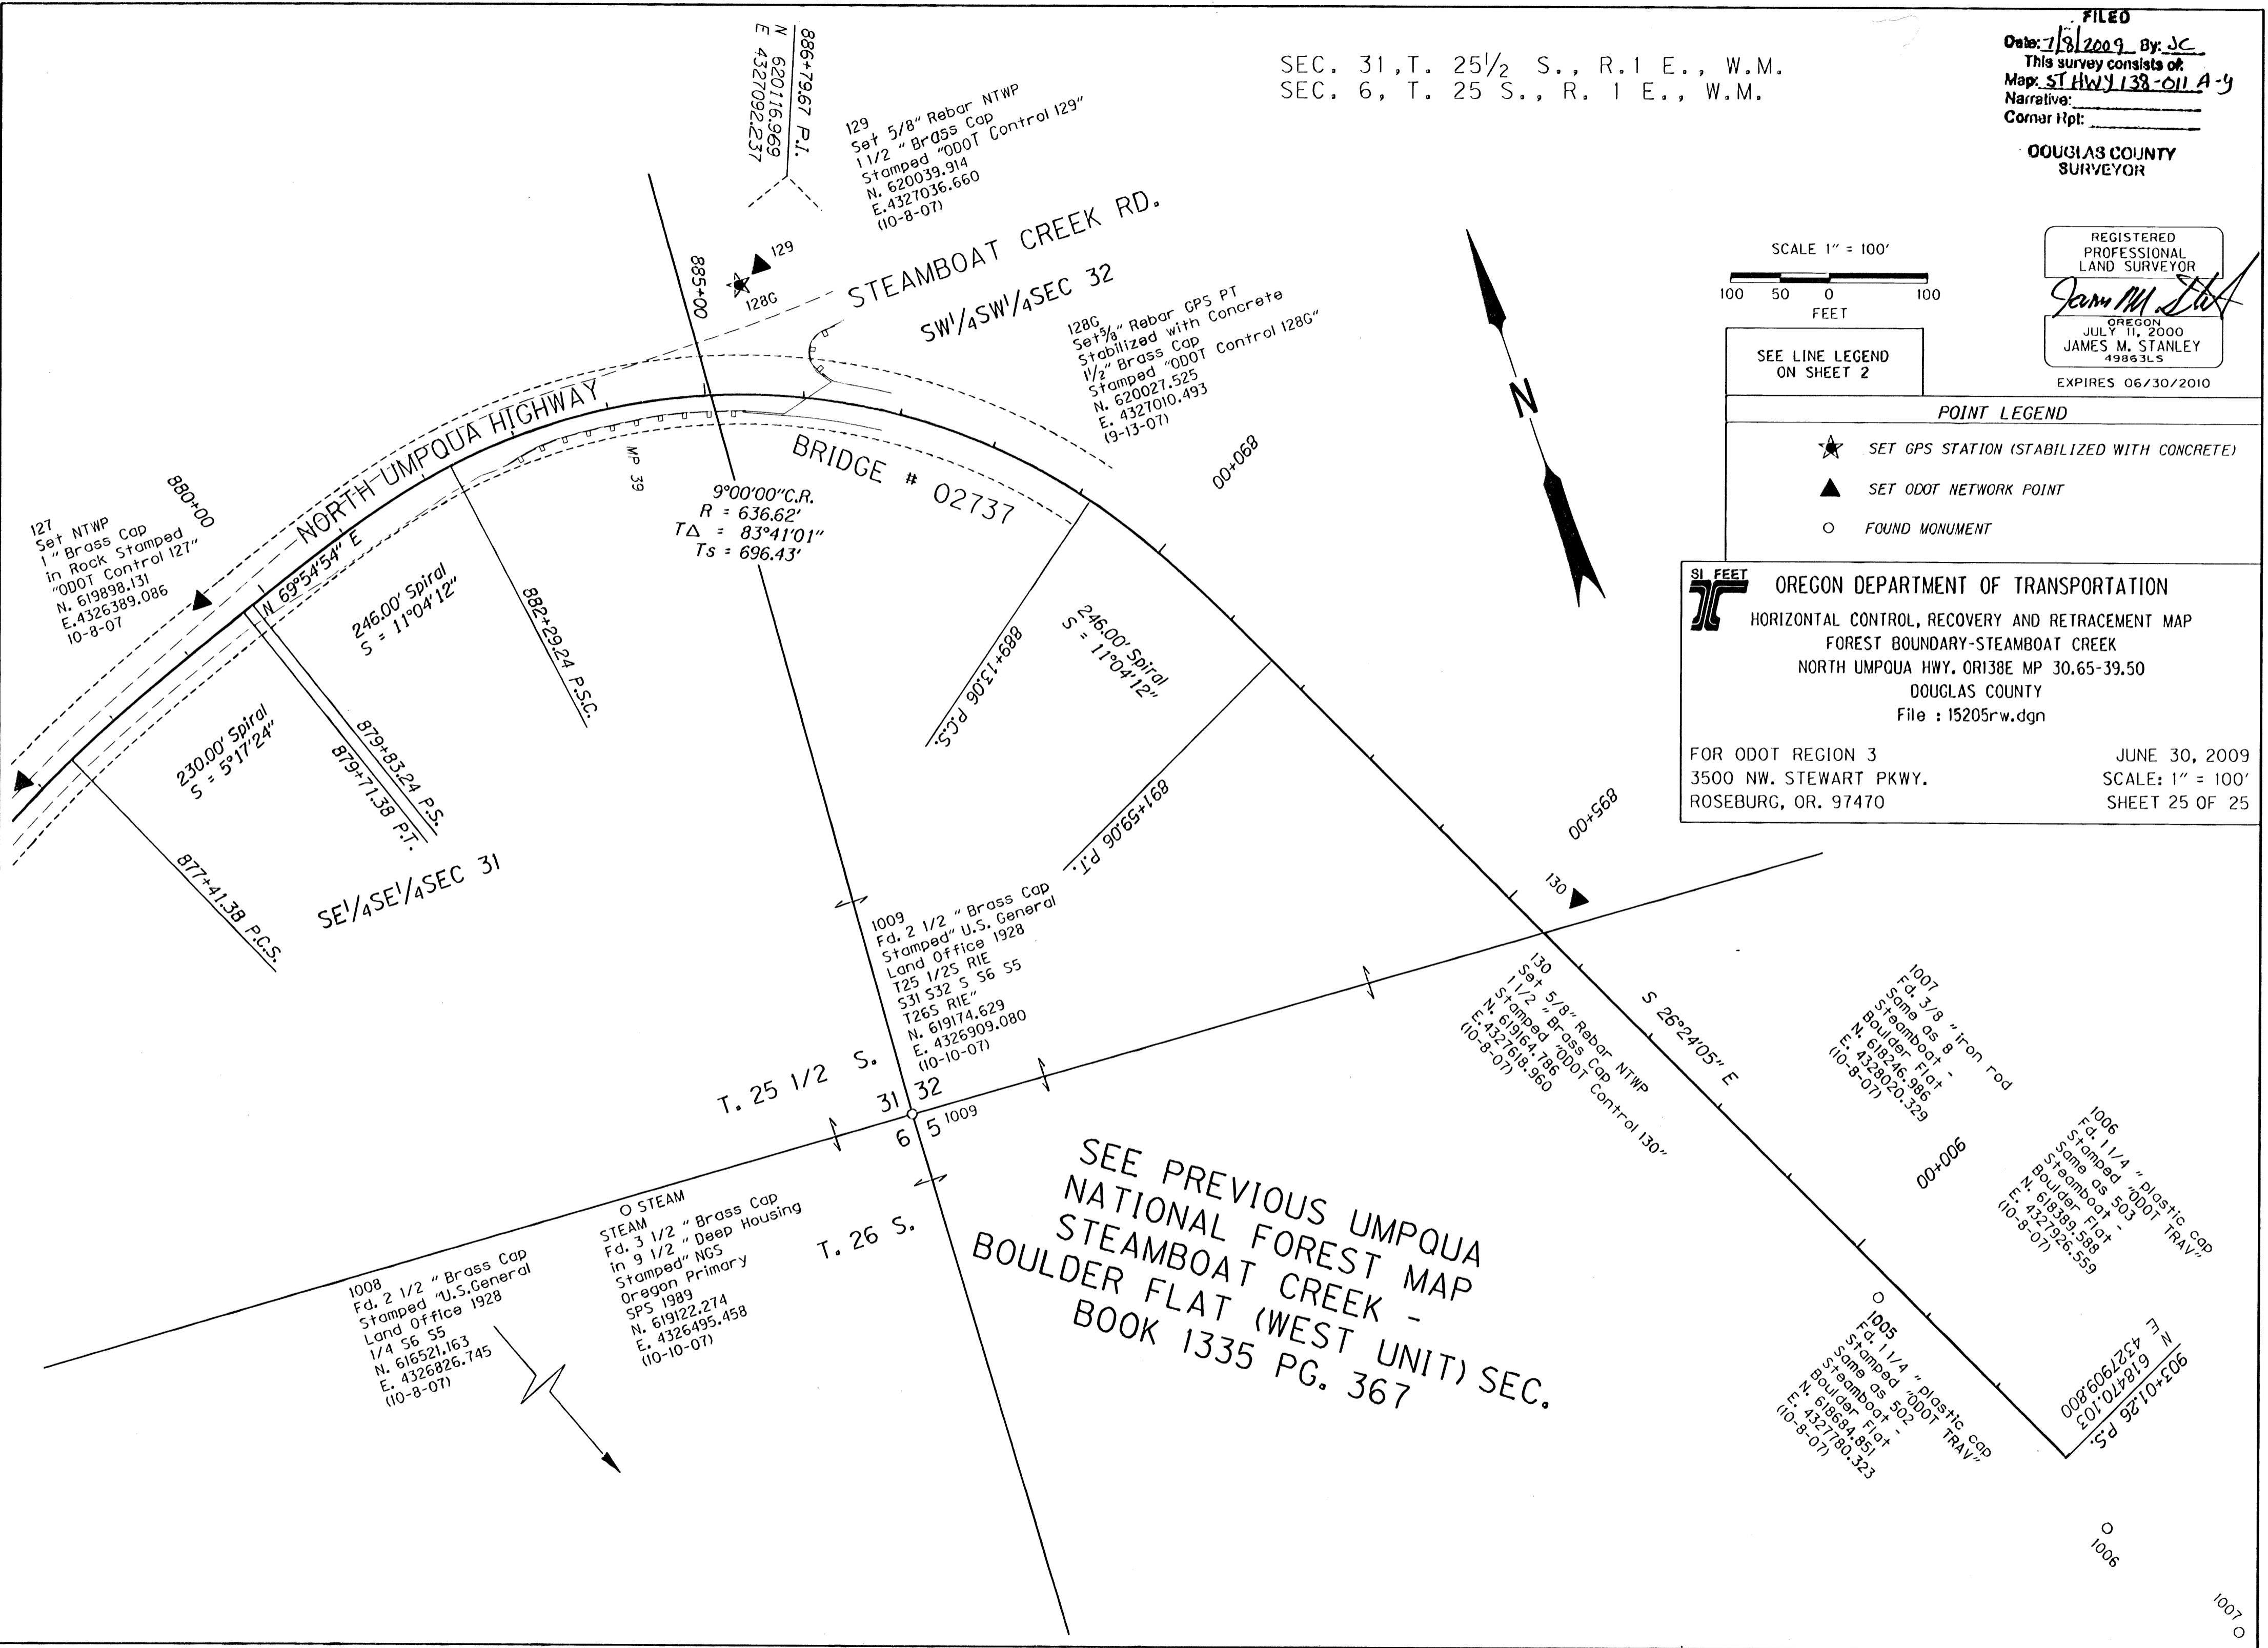

SEE PREVIOUS UMPQUA
 NATIONAL FOREST MAP
 STEAMBOAT CREEK -
 BOULDER FLAT (WEST UNIT) SEC.
 BOOK 1335 PG. 367