

FILED


Sec 18 & 19, T. 27 S., R. 5 W., W.M.  
Sec 13 & 24, T. 27 S., R. 6 W., W.M.

Date: 4-5-2018 By: JC  
This survey consist of:  
Map: ST HWY 138-016 A-H  
Narrative: \_\_\_\_\_  
Corner Rpt: \_\_\_\_\_  
DOUGLAS COUNTY  
SURVEYOR


BOUNDARY LINE LEGEND	
NEW HIGHWAY RIGHT OF WAY	ACCESS CONTROLLED
NEW HIGHWAY RIGHT OF WAY	NOT CONTROLLED
EXISTING HIGHWAY RIGHT OF WAY	ACCESS CONTROLLED
EXISTING HIGHWAY RIGHT OF WAY	NOT CONTROLLED
EXISTING STREET RIGHT OF WAY	
EXISTING RAILROAD RIGHT OF WAY	
EXISTING EASEMENT	
EXISTING PROPERTY	
DONATION LAND CLAIM (THIS SIDE)	
DONATION LAND CLAIM (BOTH SIDES)	
TOWNSHIP	
SECTION	
1/4 SECTION	
1/16 SECTION OR GOVERNMENT LOT	

POINT LEGEND	
●	SET MONUMENT
○	FOUND MONUMENT
☆	FOUND GPS STATION
⊗	DESTROYED GPS STATION
▲	SET NETWORK POINT
△	FOUND NETWORK POINT
⊠	FOUND MONUMENT USED AS NETWORK POINT
⊗	DESTROYED NETWORK POINT
◇	FOUND STRATEGIC POINT

FOR MONUMENTS NOT SHOWN ON INDIVIDUAL SHEETS SEE TABLE ON SHEET 2

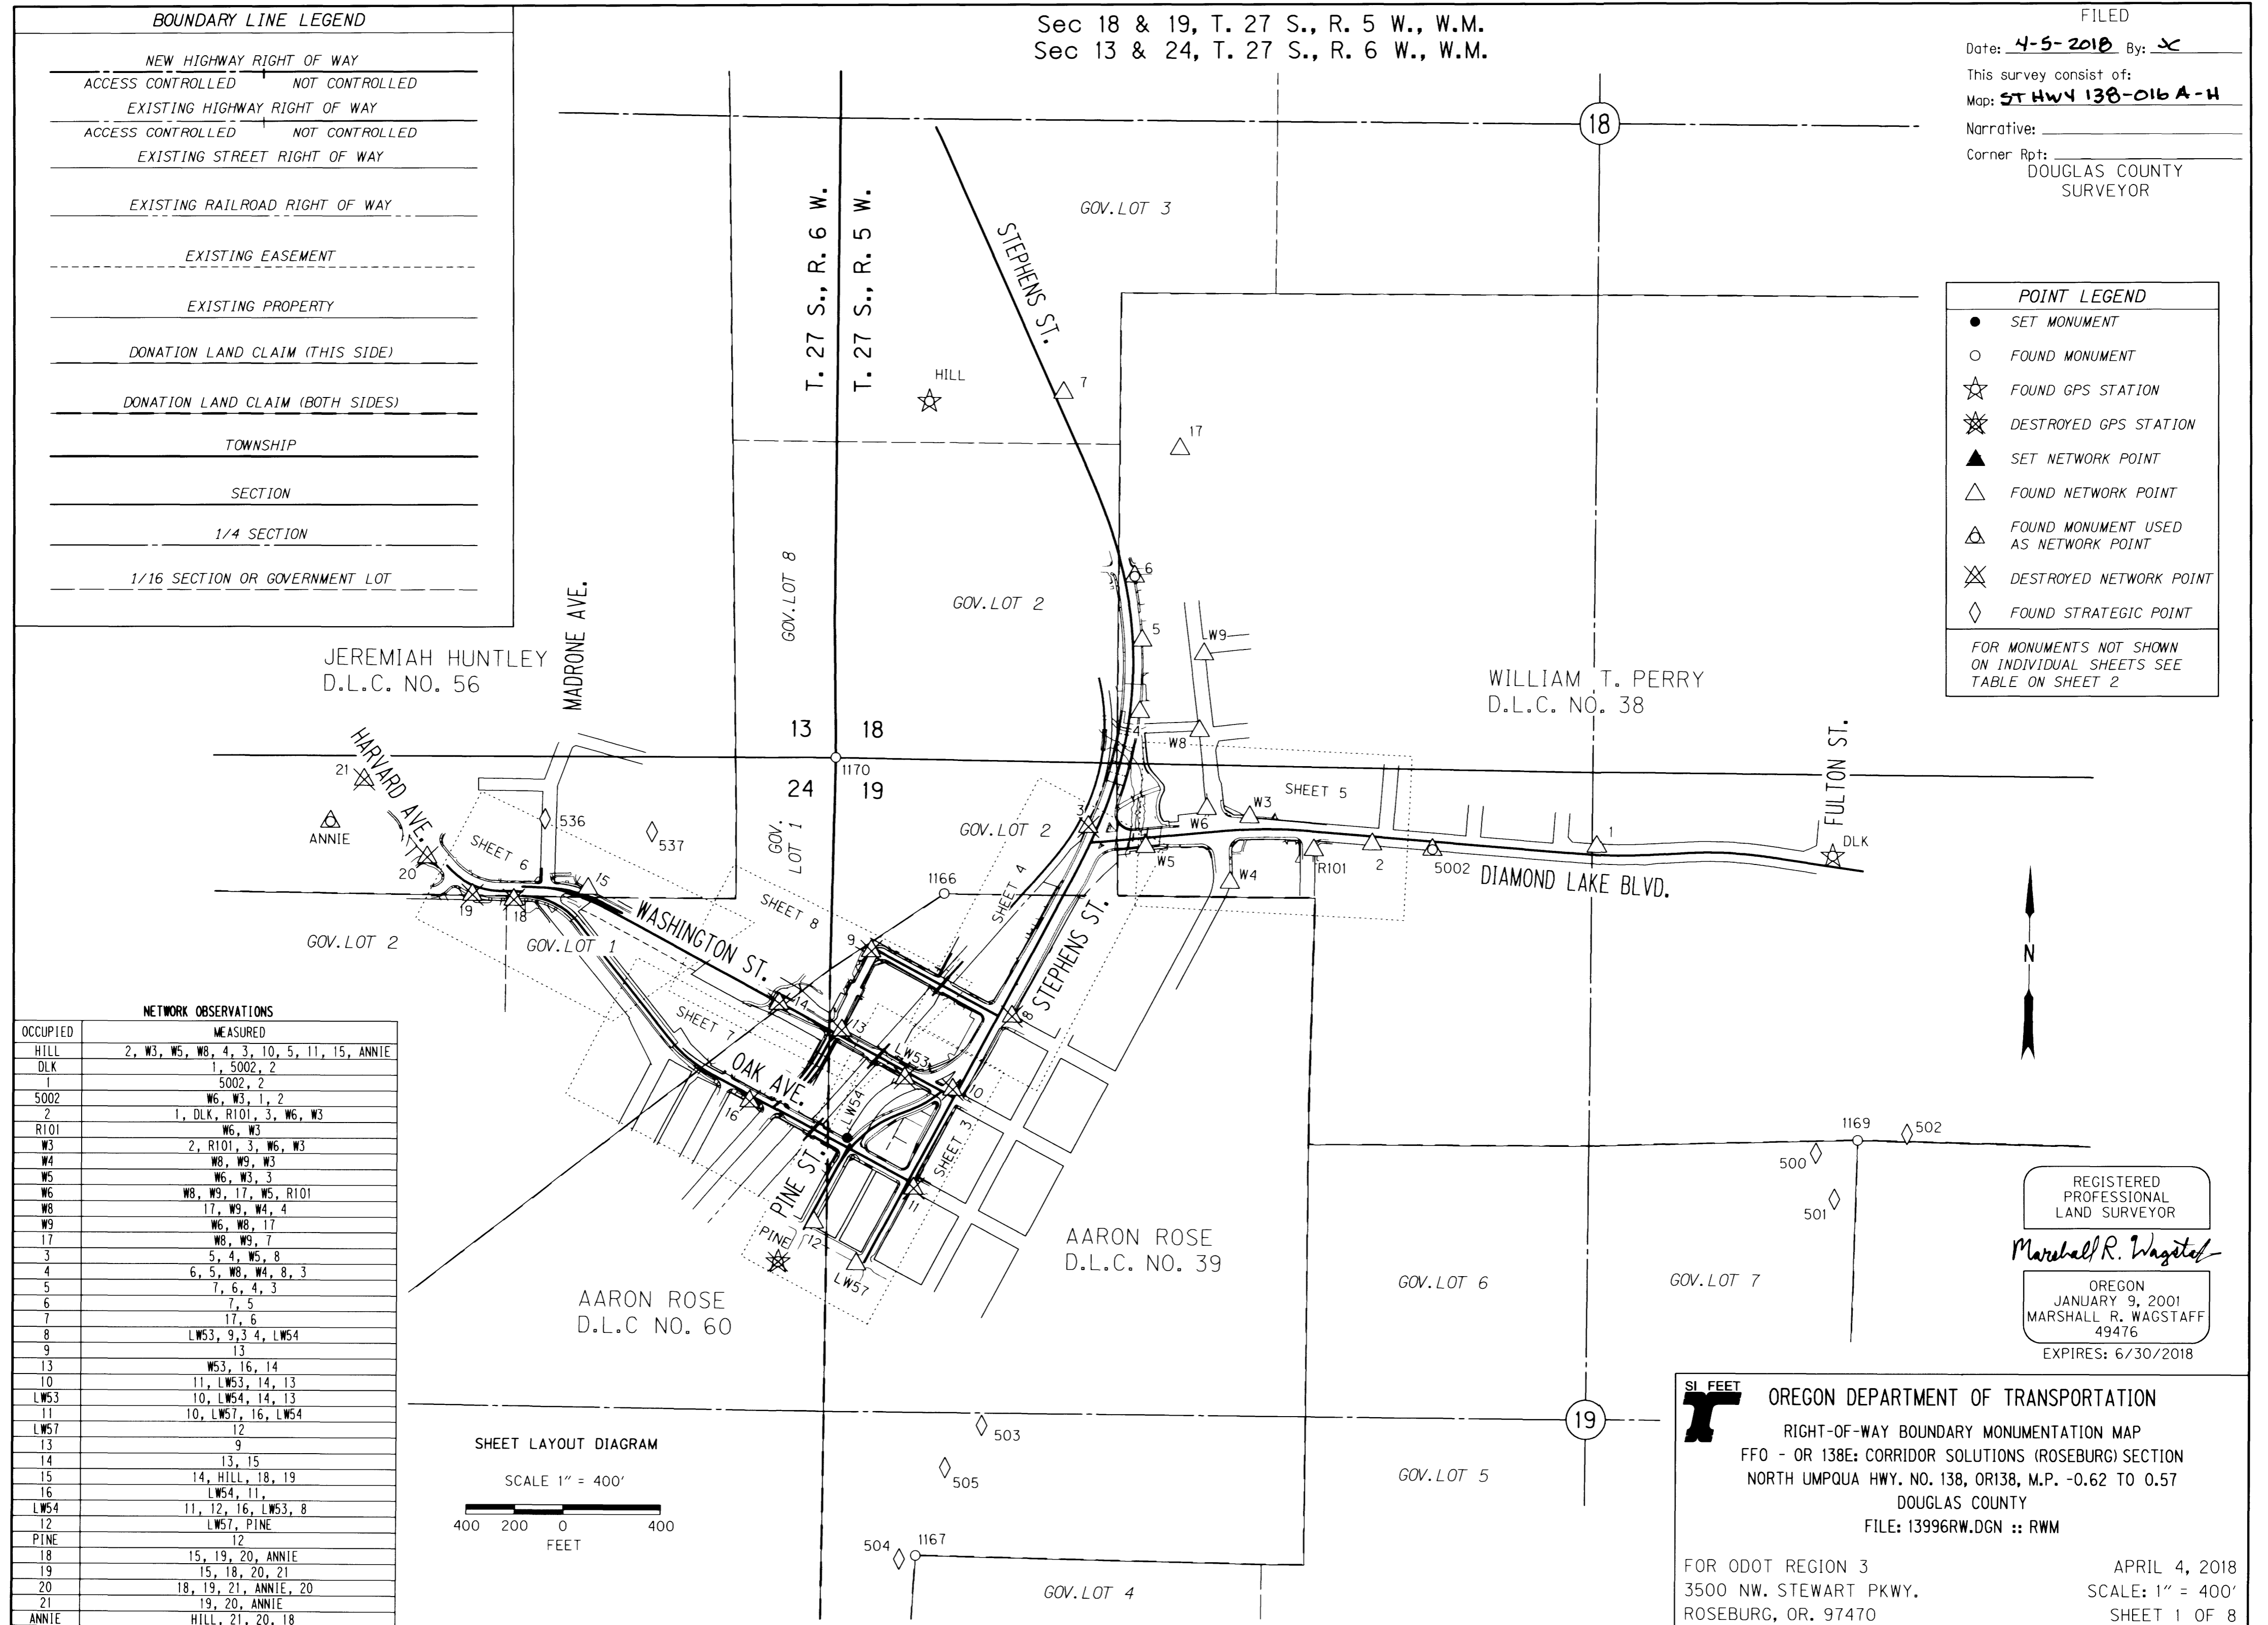

NETWORK OBSERVATIONS	
OCCUPIED	MEASURED
HILL	2, W3, W5, W8, 4, 3, 10, 5, 11, 15, ANNIE
DLK	1, 5002, 2
1	5002, 2
5002	W6, W3, 1, 2
2	1, DLK, R101, 3, W6, W3
R101	W6, W3
W3	2, R101, 3, W6, W3
W4	W8, W9, W3
W5	W6, W3, 3
W6	W8, W9, 17, W5, R101
W8	17, W9, W4, 4
W9	W6, W8, 17
17	W8, W9, 7
3	5, 4, W5, 8
4	6, 5, W8, W4, 8, 3
5	7, 6, 4, 3
6	7, 5
7	17, 6
8	LW53, 9, 3, 4, LW54
9	13
13	W53, 16, 14
10	11, LW53, 14, 13
LW53	10, LW54, 14, 13
11	10, LW57, 16, LW54
LW57	12
12	9
14	13, 15
15	14, HILL, 18, 19
16	LW54, 11,
LW54	11, 12, 16, LW53, 8
12	LW57, PINE
PINE	12
18	15, 19, 20, ANNIE
19	15, 18, 20, 21
20	18, 19, 21, ANNIE, 20
21	19, 20, ANNIE
ANNIE	HILL, 21, 20, 18

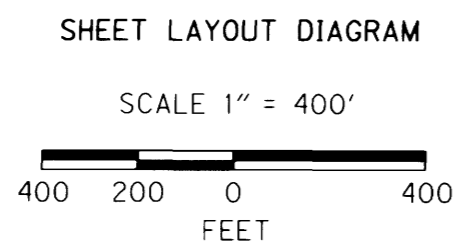

REGISTERED PROFESSIONAL LAND SURVEYOR  
*Marshall R. Wagstaff*  
OREGON  
JANUARY 9, 2001  
MARSHALL R. WAGSTAFF  
49476  
EXPIRES: 6/30/2018

SI FEET  
**OREGON DEPARTMENT OF TRANSPORTATION**  
RIGHT-OF-WAY BOUNDARY MONUMENTATION MAP  
FFO - OR 138E: CORRIDOR SOLUTIONS (ROSEBURG) SECTION  
NORTH UMPQUA HWY. NO. 138, OR138, M.P. -.062 TO 0.57  
DOUGLAS COUNTY  
FILE: 13996RW.DGN :: RWM  
FOR ODOT REGION 3  
3500 NW. STEWART PKWY.  
ROSEBURG, OR. 97470  
APRIL 4, 2018  
SCALE: 1" = 400'  
SHEET 1 OF 8

ST HWY 138-016 A