

# HORIZONTAL CONTROL, RECOVERY AND RETRACEMENT MAP


FOR THE OREGON DEPARTMENT OF TRANSPORTATION

LOCATED IN THE SW 1/4 OF SECTION 32, T. 29 S., R. 5 W. AND  
THE NW 1/4 OF SECTION 5 & THE NE 1/4 & SE 1/4 OF SECTION 6, T. 30 S., R. 5 W., W.M.  
DOUGLAS COUNTY

FILED  
Date: 4-29-1999 By: JP  
This survey consists of 11 Pgs.  
Map: M129-39E  
Narrative: \_\_\_\_\_  
Corner Rpt: (CS 65/12)  
(previously filed control reposs)  
DOUGLAS COUNTY  
SURVEYOR JP

### CONTROL NETWORK AND FOUND MONUMENTS

POINT	DESCRIPTION	NORTHING	EASTING	ELEV.
X565	FOUND 2 3/4" (70 MM) BRASS DISK SET IN CONC. 0.10 M BELOW SURFACE STAMPED "STATE HIGHWAY DEPARTMENT BM NO. X565 1958 ELEVATION FEET" (GOOD CONDITION)	151579.316	1270081.512	190.355
Y565	FOUND 2 3/4" (70 MM) BRASS DISK SET IN CONC. 0.15 M BELOW SURFACE STAMPED "STATE HIGHWAY DEPARTMENT BM NO. Y565 1958 ELEVATION FEET" (GOOD CONDITION)	151495.860	1269992.619	191.047
1004	FOUND 5/8" (16 MM) I.R. WITH A 1 1/2" (38 MM) DIA. ALUM. CAP STAMPED "OREG. STATE HWY DIV. 1/2" FLUSH W/SURFACE STA. 110+00.00 P.O.T. (FAIR CONDITION)	152115.237	1270679.890	187.995
1005	FOUND 5/8" (16 MM) I.R. WITH A 1 1/2" (38 MM) DIA. ALUM. CAP STAMPED "OREG. STATE HWY DIV. 1/2" STA. 120+00.00 P.O.T.	151911.829	1270452.777	188.390
1006	FOUND 5/8" (16 MM) I.R. WITH A 1 1/2" (38 MM) DIA. ALUM. CAP STAMPED "OREG. STATE HWY DIV. 1/2" STA. 130+00.00 P.O.T.	151708.483	1270225.747	189.353
1007	FOUND 5/8" (16 MM) I.R. WITH A 1 1/2" (38 MM) DIA. ALUM. CAP STAMPED "OREG. STATE HWY DIV. 1/2" 0.10 M BELOW SURFACE STA. 160+00.00 P.O.T. (GOOD CONDITION)	150993.403	1269669.789	193.317
1008	FOUND 5/8" (16 MM) I.R. WITH A 1 1/2" (38 MM) DIA. ALUM. CAP STAMPED "OREG. STATE HWY DIV. 1/2" FLUSH W/SURFACE STA. 170+00.00 P.O.T. (GOOD CONDITION)	150729.828	1269516.641	193.401
1012	FOUND 5/8" (16 MM) I.R. 20 MM ABOVE SURFACE, R/W STA. 175+29.92 P.S., 38.10 M (125 FT.) LT. (FAIR CONDITION)	150567.273	1269475.072	
1015	FOUND 5/8" (16 MM) I.R. WITH A 1 1/2" (38 MM) DIA. ALUM. CAP STAMPED "OREG. STATE HWY DIV. 1/2" FLUSH W/SURFACE, STA. 175+29.92 P.C. (GOOD CONDITION)	150590.233	1269435.535	193.442
1017	FOUND 3/4" (19 MM) I.R. FLUSH W/SURFACE, R/W STA. 175+29.92 P.S., 38.10 M (125 FT.) RT. (GOOD CONDITION)	150609.377	1269402.594	
30	SET 13 MM SQ. I.R. 0.76 M LONG WITH 38 MM DIA. ALUM. CAP STAMPED "ODOT HORIZ. CONTROL 30"	152006.743	1270565.624	188.978
31	SET 13 MM SQ. I.R. 0.76 M LONG WITH 38 MM DIA. ALUM. CAP STAMPED "ODOT HORIZ. CONTROL 31"	151821.326	1270345.970	189.269
32	SET 13 MM SQ. I.R. 0.76 M LONG WITH 38 MM DIA. ALUM. CAP STAMPED "ODOT HORIZ. CONTROL 32"	151318.515	1269869.401	193.911
33	SET 13 MM SQ. I.R. 0.76 M LONG WITH 38 MM DIA. ALUM. CAP STAMPED "ODOT HORIZ. CONTROL 33"	151319.281	1269834.806	194.040
34	SET 13 MM SQ. I.R. 0.76 M LONG WITH 38 MM DIA. ALUM. CAP STAMPED "ODOT HORIZ. CONTROL 34"	151157.509	1269740.892	194.286
35	SET 13 MM SQ. I.R. 0.76 M LONG WITH 38 MM DIA. ALUM. CAP STAMPED "ODOT HORIZ. CONTROL 35"	151141.208	1269781.063	194.162
36	SET 13 MM SQ. I.R. 0.76 M LONG WITH 38 MM DIA. ALUM. CAP STAMPED "ODOT HORIZ. CONTROL 36"	150868.817	1269593.274	193.862
37	SET 13 MM SQ. I.R. 0.76 M LONG WITH 38 MM DIA. ALUM. CAP STAMPED "ODOT HORIZ. CONTROL 37"	150602.368	1269447.130	194.230

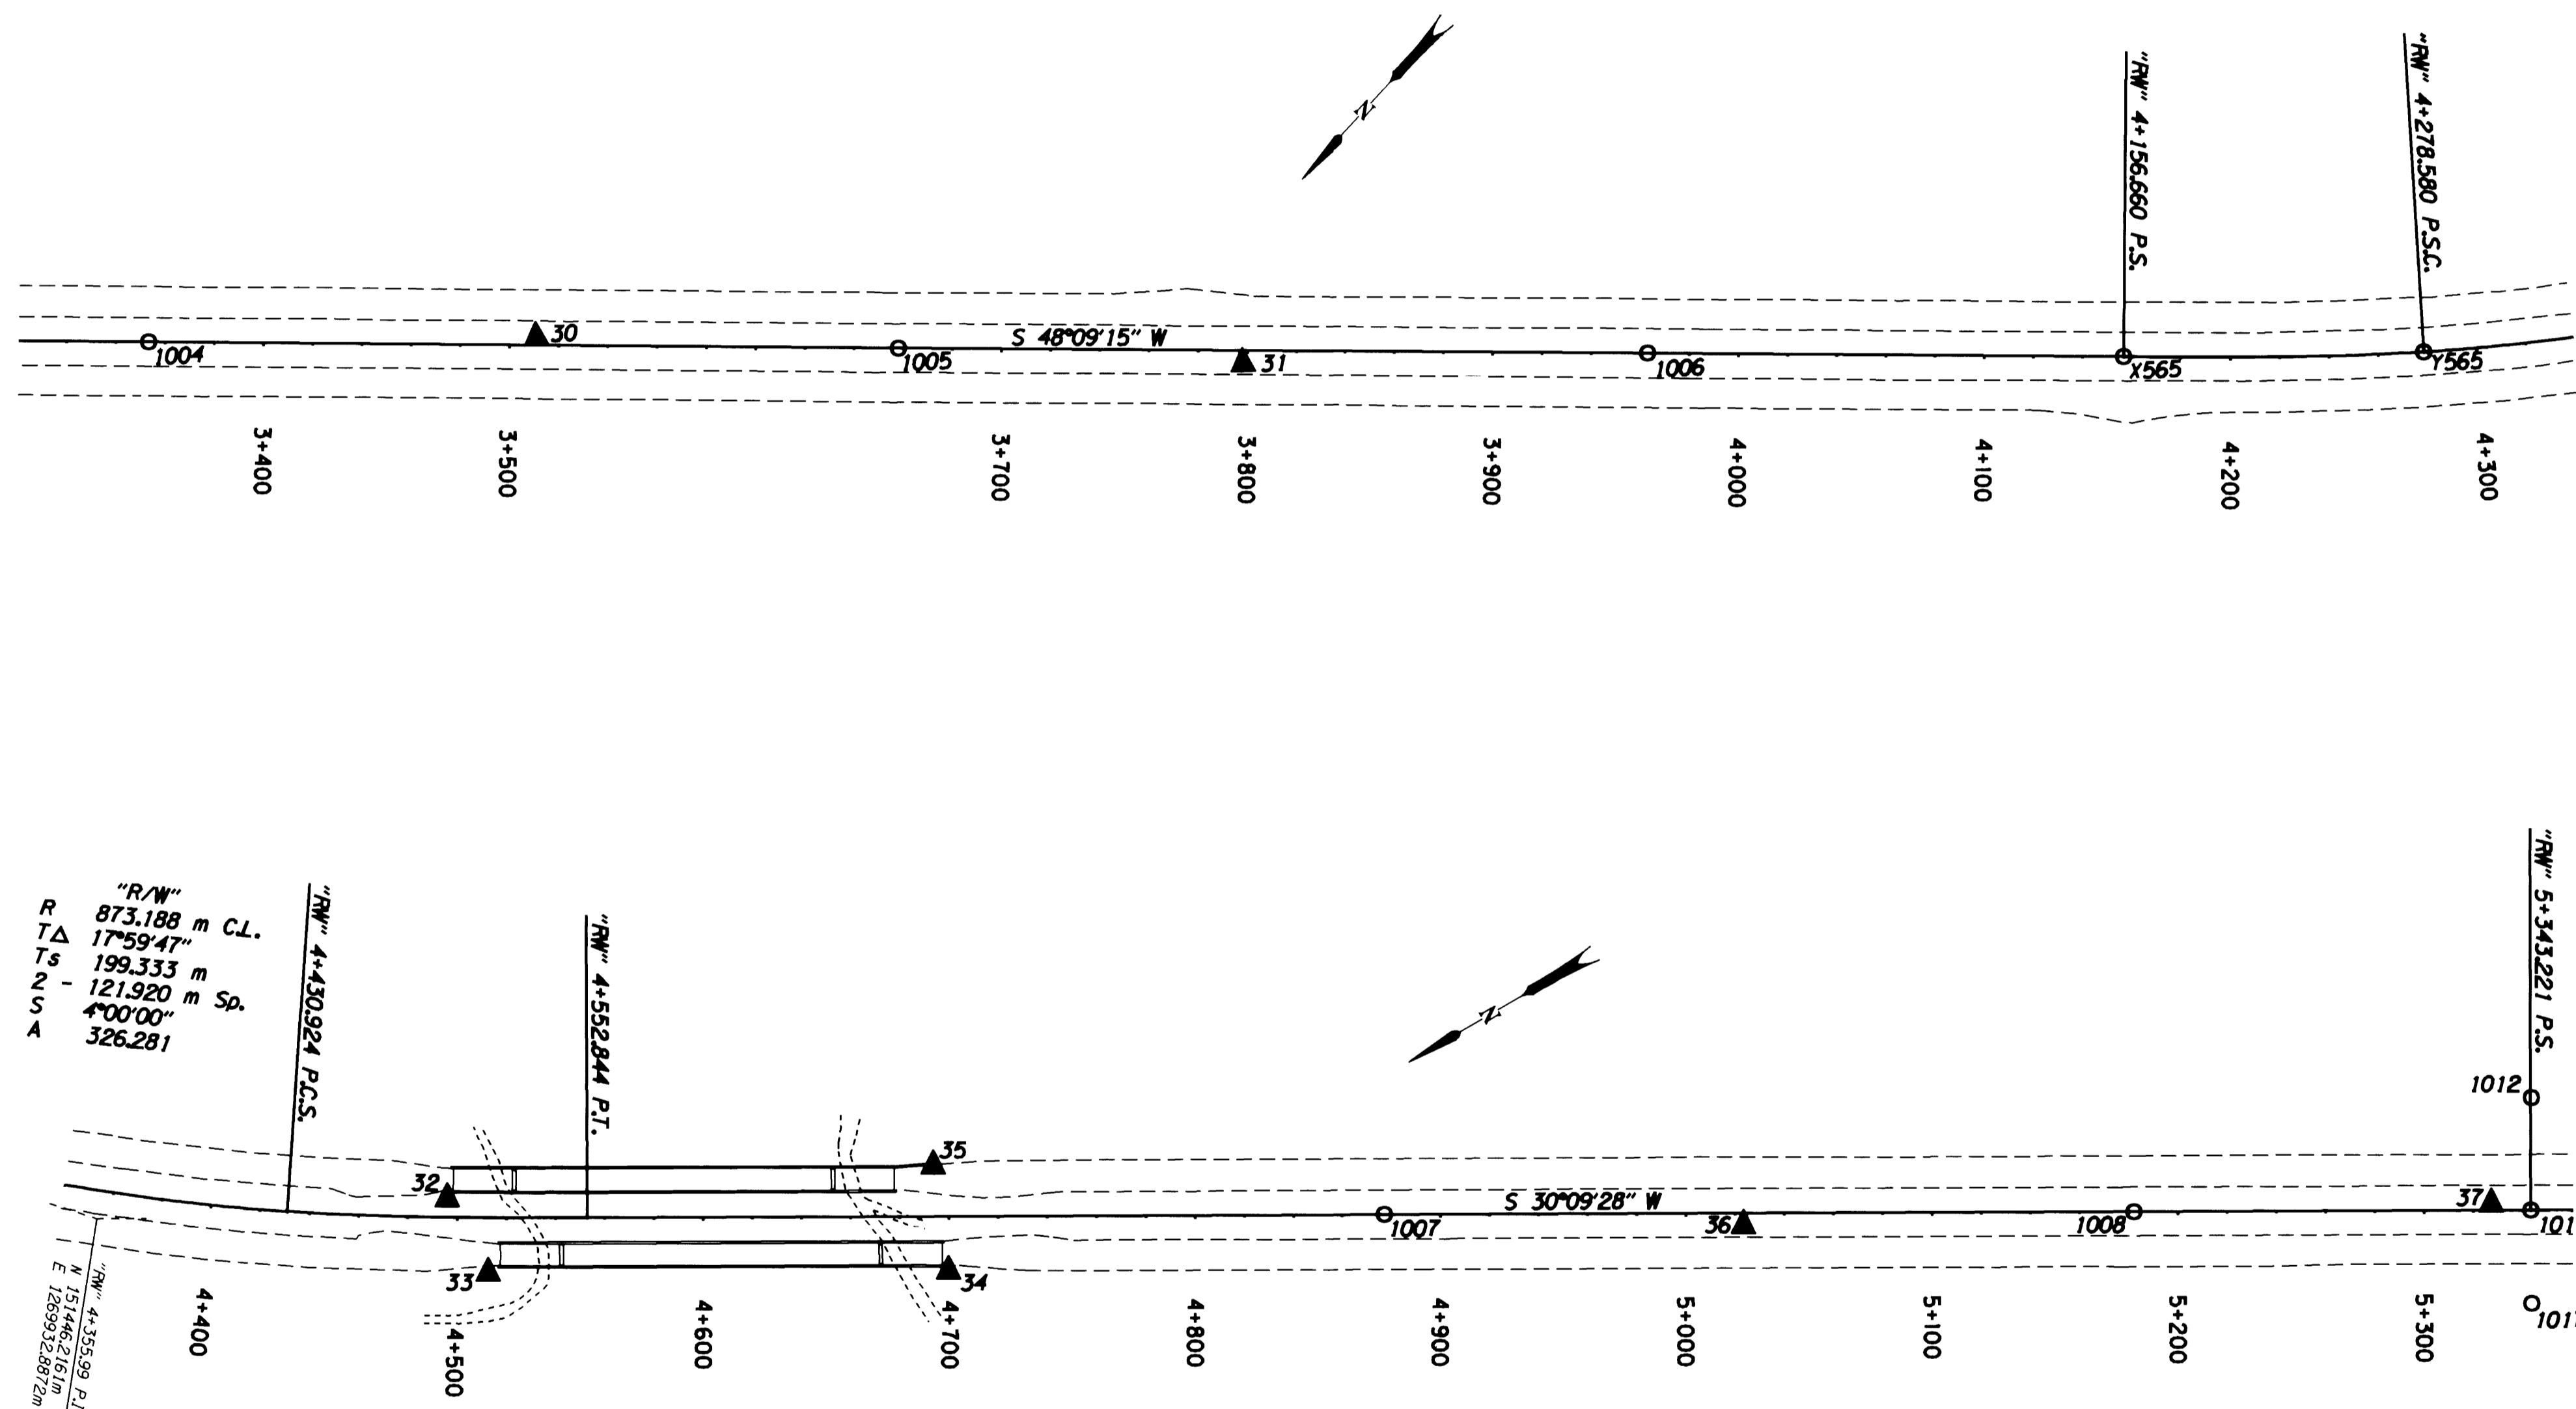

REGISTERED PROFESSIONAL LAND SURVEYOR

Christine V. Blewins  
OREGON  
JULY 19, 1994  
CHRISTINE V. BLEWINS  
2669

RENEWAL DATE 12-31-99

CHRISTINE V. BLEWINS P.L.S.  
Oregon Department of Transportation  
3500 N.W. Stewart Parkway  
Roseburg, Oregon 97470

**LEGEND**

- ▲ SET MONUMENT
- FOUND MONUMENT
- ★ FOUND GPS MONUMENT

SCALE

0 20 40 60 80 100 METERS

SCALE: 1:2000

**COUNTY SURVEYORS FILE DATA  
DO NOT REMOVE FROM OFFICE**

OREGON DEPARTMENT OF TRANSPORTATION  
**HORIZONTAL CONTROL, RECOVERY,  
AND RETRACEMENT MAP**  
MYRTLE CREEK - CANYONVILLE SEC. (1-5)  
DOUGLAS COUNTY

ODOT  
3500 Stewart Parkway, Suite 140  
Roseburg, Oregon 97470

NOTE: ALL COORDINATES ON THIS MAP ARE METRIC, ON A LOCAL DATUM PLANE, WHICH REPRESENTS TRUE GROUND DISTANCES. TO CONVERT COORDINATES TO ENGLISH, DIVIDE THE METRIC COORDINATES BY 0.3048