

COUNTY SURVEYORS FILE DATA  
DO NOT REMOVE FROM OFFICE

SW 1/4 SEC. 12 AND NW 1/4 & SW 1/4 SEC. 13, T. 31 S., R. 5 W., W.M.

FILED


Date: 10/30/2000 By: JP  
This survey consists of: 16 Pgs.  
Map: M135-71G  
Narrative:  
Corner Ppt:

DOUGLAS COUNTY  
SURVEYOR

POINT ID	LDP NORTHING	LDP EASTING	DESCRIPTION
61	138269.549	385683.600	SET 16 mm X 762 mm IRON REBAR W/A 38 mm BRASS CAP STAMPED "ODOT CONTROL 61" 25 mm ABOVE SURFACE.
62	138479.742	385735.853	SET 16 mm X 762 mm IRON REBAR W/A 38 mm BRASS CAP STAMPED "ODOT CONTROL 62" FLUSH W/ SURFACE.
63	138828.462	385825.987	FOUND 2 3/4" BRASS DISK SET IN CONC. STAMPED "STATE HIGHWAY DEPARTMENT BM NO. ELEVATION FEET" 30 mm BELOW SURFACE IN GOOD CONDITION. PADDLE BOARD NEARBY MARKED "SHRW LC P.O.T. 256+00.00" REFERENCE RIGHT. (DRG. *8B-31-12)
1063	138820.937	385855.497	FOUND 5/8" IRON ROD W/A 1 1/2" ALUM. CAP STAMPED "OREG. STATE HWY. DIV." FLUSH W/ SURFACE IN GOOD CONDITION. PADDLE BOARD NEARBY MARKED "SHRW P.O.T. LC 256+00.00" LEFT. (DRG. *8B-31-12)

MILE POST 94

MILE POST 94

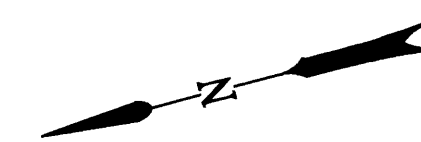

POINT ID	LDP NORTHING	LDP EASTING	DESCRIPTION
57	137327.334	385359.380	SET 16 mm X 762 mm IRON REBAR W/A 38 mm BRASS CAP STAMPED "ODOT CONTROL 57" FLUSH W/ SURFACE.
58	137578.695	385478.653	FOUND 5/8" IRON ROD W/ 1 1/2" ALUM. CAP STAMPED "OREG. STATE HWY. DIV." 50 mm BELOW SURFACE SET IN CONC. IN GOOD CONDITION. PADDLE BOARD NEARBY MARKED "SHRP P.T. LS 298+63.36" 25.0 FT. LT. (DRG. *8B-31-12)
59	137786.477	385574.175	FOUND 5/8" IRON ROD W/A 1 1/2" ALUM. CAP STAMPED " OREGON STATE HWY. DEPT." 35 mm ABOVE PAVEMENT IN GOOD CONDITION. PADDLE BOARD NEARBY MARKED "SHRP P.S.C. LS 291+15.86" 20.0 FT. LT. (DRG. *8B-31-12)
60	137953.135	385636.149	SET 16 mm X 762 mm IRON REBAR W/A 38 mm BRASS CAP STAMPED "ODOT CONTROL 60" FLUSH W/ SURFACE.
1049	137430.996	385404.102	FOUND 5/8" IRON ROD W/A 1 1/2" ALUM. CAP STAMPED "OREG. STATE HWY. DIV." SET IN CONC. FLUSH W/ SURFACE IN GOOD CONDITION. PADDLE BOARD NEARBY MARKED "SHRP P.S.C. LN 304+18.04" 40.0 FT. RT. (DRG. *8B-31-12)
1050	137422.548	385422.032	FOUND 5/8" IRON ROD W/A 1 1/2" ALUM. CAP STAMPED "OREG. STATE HWY. DEPT." 70 mm BELOW SURFACE IN GOOD CONDITION. PADDLE BOARD NEARBY MARKED "SHRW P.S.C. LN 304+18.04" 25.0 FT. LT. (DRG. *8B-31-12)
1051	137526.321	385453.340	FOUND 5/8" IRON ROD W/A 1 1/2" ALUM. CAP STAMPED "OREG. STATE HWY. DEPT." SET IN CONC. FLUSH W/ SURFACE. PADDLE BOARD NEARBY MARKED "SHRW P.S. LN 300+68.04" 40.0 FT. RT. (DRG. *8B-31-12)
1052	137457.269	385412.699	FOUND 5/8" IRON ROD W/A 1 1/2" ALUM. CAP STAMPED "OREG. STATE HWY. DEPT." SET IN CONC. 120 mm BELOW SURFACE. PADDLE BOARD NEARBY MARKED "SHRP P.S.C. LS 303+17.73" 25.0 FT. LT. (DRG. *8B-31-12)
1053	137566.529	385450.857	FOUND 2 3/4" BRASS DISK STAMPED "STATE HIGHWAY DEPARTMENT ELEVATION FEET" SET IN CONC. 100 mm BELOW SURFACE IN GOOD CONDITION. PADDLE BOARD NEARBY MARKED "SHRP P.S. LS 299+42.73" 35.0 FT. RT. (DRG. *8B-31-12)

LEGEND


- ▲ SET MONUMENT
- FOUND MONUMENT
- CONCRETE BARRIER
- - - EDGE OF PAVEMENT

REGISTERED  
PROFESSIONAL  
LAND SURVEYOR

Christine V. Blawie

OREGON  
JULY 19, 1994  
CHRISTINE V. BLAWIE  
2000

EXPIRES: DEC. 31, 2001

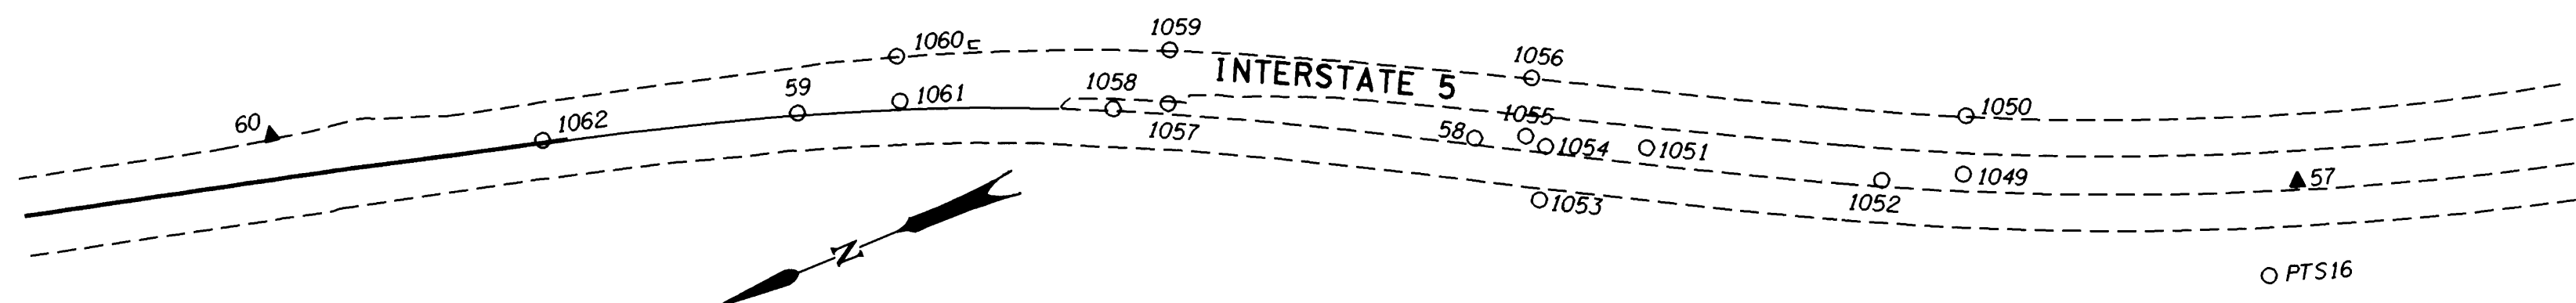

1054	137557.607	385466.826	FOUND 5/8" IRON ROD W/A 1 1/2" ALUM. CAP STAMPED "OREG. STATE HWY. DEPT." SET IN CONC. 100 mm BELOW SURFACE IN GOOD CONDITION. PADDLE BOARD NEARBY MARKED "SHRP P.S. LS 299+42.73" 25.0 FT. LT. (DRG. *8B-31-12)
1055	137562.446	385472.667	FOUND 5/8" IRON ROD W/A 1 1/2" ALUM. CAP STAMPED "OREG. STATE HWY. DEPT." SET IN CONC. FLUSH W/ SURFACE. PADDLE BOARD NEARBY MARKED "SHRP P.T. LN 299+33.63" 40.0 FT. RT. (DRG. *8B-31-12)
1056	137553.051	385490.099	FOUND 5/8" IRON ROD W/A 1 1/2" ALUM. CAP STAMPED "OREG. STATE HWY. DEPT." 120 mm BELOW SURFACE IN GOOD CONDITION. PADDLE BOARD NEARBY MARKED "SHRW P.T. LN 299+33.63" 25.0 FT. LT. (DRG. *8B-31-12)
1057	137669.650	385529.067	FOUND 5/8" IRON ROD W/A 1 1/2" ALUM. CAP STAMPED "OREG. STATE HWY. DIV." SET IN CONC. 130 mm BELOW SURFACE IN GOOD CONDITION. PADDLE BOARD NEARBY MARKED "SHRW P.C.S. LN 295+33.63" 25.0 FT. RT. (DRG. *8B-31-12)
1058	137687.475	385534.603	FOUND 5/8" IRON ROD W/A 1 1/2" ALUM. CAP STAMPED "OREG. STATE HWY. DIV." SET IN CONC. FLUSH W/ SURFACE. PADDLE BOARD NEARBY MARKED "SHRP LS 294+63.36" 20.0 FT. LT. (DRG. *8B-31-12)
1059	137662.152	385545.726	FOUND 5/8" IRON ROD W/A 1 1/2" ALUM. CAP STAMPED "OREG. STATE HWY. DEPT." 130 mm BELOW SURFACE IN GOOD CONDITION. PADDLE BOARD NEARBY MARKED "SHRP P.C.S. LN 295+33.63" 25.0 FT. LT. (DRG. *8B-31-12)
1060	137748.109	385579.093	FOUND 5/8" IRON ROD W/A 1 1/2" ALUM. CAP STAMPED "OREG. STATE HWY. DEPT." 60 mm BELOW SURFACE IN GOOD CONDITION. PADDLE BOARD NEARBY MARKED "SHRW P.S.C. LN 292+33.63" 25.0 FT. LT. (DRG. *8B-31-12)
1061	137752.906	385564.609	FOUND 5/8" IRON ROD W/A 1 1/2" ALUM. CAP STAMPED "OREG. STATE HWY. DEPT." 30 mm ABOVE PAVEMENT IN GOOD CONDITION. PADDLE BOARD ON GUARDRAIL POST MARKED "SHRW P.S.C. LN 292+33.63" 25.0 FT. RT. (DRG. *8B-31-12)
1062	137869.434	385598.651	FOUND 5/8" IRON ROD W/A 1 1/2" ALUM. CAP STAMPED "OREG. STATE HWY. DEPT." 40 mm ABOVE SURFACE IN GOOD CONDITION. PADDLE MOUNTED ON GUARDRAIL POST MARKED "SHRW P.S. LN 288+33.63" 20.0 FT. RT. (DRG. *8B-31-12)
PTS16	137348.682	385332.884	FOUND 2 1/8" BRASS DISK SET IN ROCK STAMPED "DOUGLAS CO. SURVEYORS OFFICE 1975 PTS-16" FLUSH W/ ROCK IN GOOD CONDITION.

SCALE 1:2000 METERS



1 METER = 3937 U.S. FEET / 1200  
TO CONVERT A METRIC DISTANCE DIVIDE BY 0.30480061

OREGON DEPARTMENT OF TRANSPORTATION

HORIZONTAL CONTROL  
AND RECOVERY MAP

CANYONVILLE - AZALEA SECTION

INTERSTATE 5  
DOUGLAS COUNTY

3500 STEWART PARKWAY, SUITE 140  
ROSEBURG, OREGON 97470

OCTOBER 26, 2000  
PROJECT KEY \*10832

SHEET 7 OF 16

ST. HWY. 15-010G

MAP FILE M135-71G

MAP FILE M135-71G