


COUNTY SURVEYORS FILE DATA
DO NOT REMOVE FROM OFFICE

SE 1/4 & SW 1/4 SEC. 35, T. 31 S., R. 5 W., AND
NW 1/4 SEC. 2, T. 32 S., R. 5 W., W.M.

FILED
Date: 10/30/2000 By: JP
This survey consists of: 16 Pgs.
Map: M135-71L
Narrative: _____
Corner Rpt: _____
DOUGLAS COUNTY
SURVEYOR


MAP FILE M135-71L

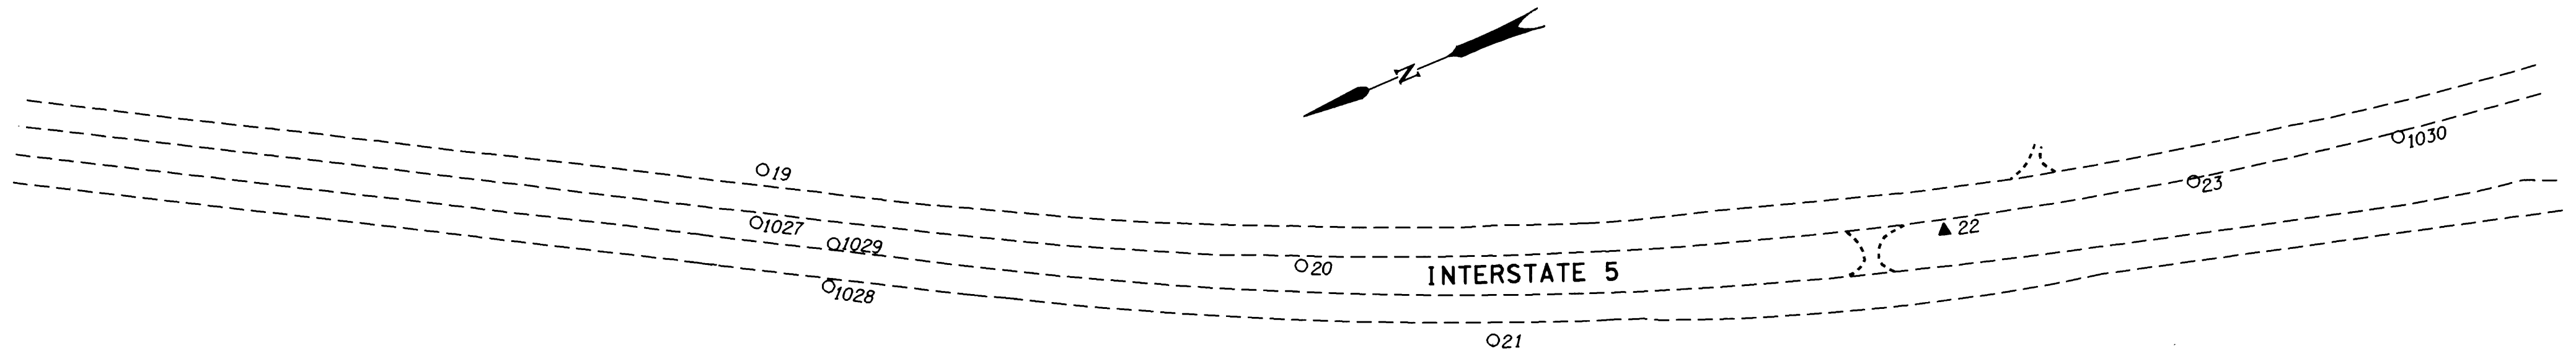

LEGEND	
▲	SET MONUMENT
○	FOUND MONUMENT
---	EDGE OF PAVEMENT

REGISTERED
PROFESSIONAL
LAND SURVEYOR
Christine V. Blavin
OREGON
JULY 19, 1994
CHRISTINE V. BLAVIN
2000
EXPIRES: DEC. 31, 2001

POINT ID	LDP NORTHING	LDP EASTING	DESCRIPTION
19	133066.554	384282.282	FOUND 2 3/4" BRASS DISK SET IN CONC. STAMPED "STATE HIGHWAY DEPARTMENT REFERENCE 464+46.44 P.S. 45.00" SET IN CONC. 270 mm BELOW SURFACE IN GOOD CONDITION. STATION NB 464+46.44 P.S. 45.0 FT. LT. (DRG. *8B-30-23)
20	132870.802	384154.984	FOUND 2 7/8" BRASS DISK SET IN CONC. STAMPED "STATE HIGHWAY DEPARTMENT REFERENCE LN 472+11.40 POST" 100 mm BELOW SURFACE IN GOOD CONDITION. STATION P.O.S.T. LN 472+11.40 (DRG. *8B-30-23)
21	132807.775	384093.830	FOUND 2 3/4" BRASS DISK SET IN CONC. PEDESTAL STAMPED "STATE HIGHWAY DEPARTMENT REFERENCE P.I." 200 mm ABOVE SURFACE IN GOOD CONDITION. PADDLE BOARD NEARBY MARKED "SHRP P.I." STA. SB 474+73.56 P1 (DRG. *8B-30-23)
22	132611.645	384062.975	SET 16 mm X 762 mm IRON REBAR W/A 38 mm BRASS CAP STAMPED " ODOT CONTROL 22" FLUSH W/ SURFACE.
23	132505.763	384040.134	FOUND 2 3/4" BRASS DISK SET IN CONC. STAMPED "STATE HIGHWAY DEPARTMENT REFERENCE LN 434+60.17 P.O.S.T." 50 mm BELOW SURFACE IN GOOD CONDITION. PADDLE BOARD LAYING DOWN NEARBY MARKED "SHRW P.O.S.T. LN 484+60.17" (DRG. *8B-30-23)
1027	133077.864	384262.437	FOUND 2 3/4" BRASS DISK STAMPED "STATE HIGHWAY DEPARTMENT REFERENCE 464+46.44 P.S. 30.00" SET IN CONC. 120 mm BELOW SURFACE IN GOOD CONDITION. 30.0 FT. RT. (DRG. *8B-30-23)
1028	133060.046	384225.285	FOUND 2 3/4" BRASS DISK STAMPED "STATE HIGHWAY DEPARTMENT REFERENCE 465+43.26 P.S. 35.00" SET IN CONC. 250 mm BELOW SURFACE IN GOOD CONDITION. PADDLE BOARD NEARBY MARKED "SHRP 465+43.26 P.S. 35" RIGHT. (DRG. *8B-30-23)
1029	133051.016	384241.144	FOUND 2 3/4" BRASS DISK STAMPED "STATE HIGHWAY DEPARTMENT REFERENCE 465+43.26 P.S. 25.00" LEFT. SET IN CONC. 300 mm BELOW SURFACE IN GOOD CONDITION. (DRG. *8B-30-23)
1030	132417.837	384023.631	FOUND 2 3/4" BRASS DISK STAMPED "STATE HIGHWAY DEPARTMENT REFERENCE" SET IN CONC. 100 mm BELOW SURFACE IN GOOD CONDITION. PADDLE BOARD NEARBY MARKED "SHRW" STATION NB 487+53.52 P.C.S. RIGHT. (DRG. *8B-30-23)

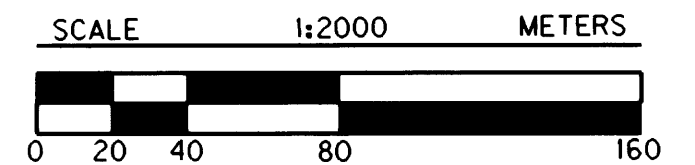

1 METER = 3937 U.S. FEET / 1200
TO CONVERT A METRIC DISTANCE DIVIDE BY 0.30480061

OREGON DEPARTMENT OF TRANSPORTATION
HORIZONTAL CONTROL
AND RECOVERY MAP
CANYONVILLE - AZALEA SECTION
INTERSTATE 5
DOUGLAS COUNTY
3500 STEWART PARKWAY, SUITE 140
ROSEBURG, OREGON 97470

OCTOBER 26, 2000
PROJECT KEY *10832

SHEET 12 OF 16

MAP FILE M135-71L

ST. HWY. 15-010L