


N.E. 1/4 & S.E. 1/4 SECTION 2, T. 28 S., R. 6 W., W.M.

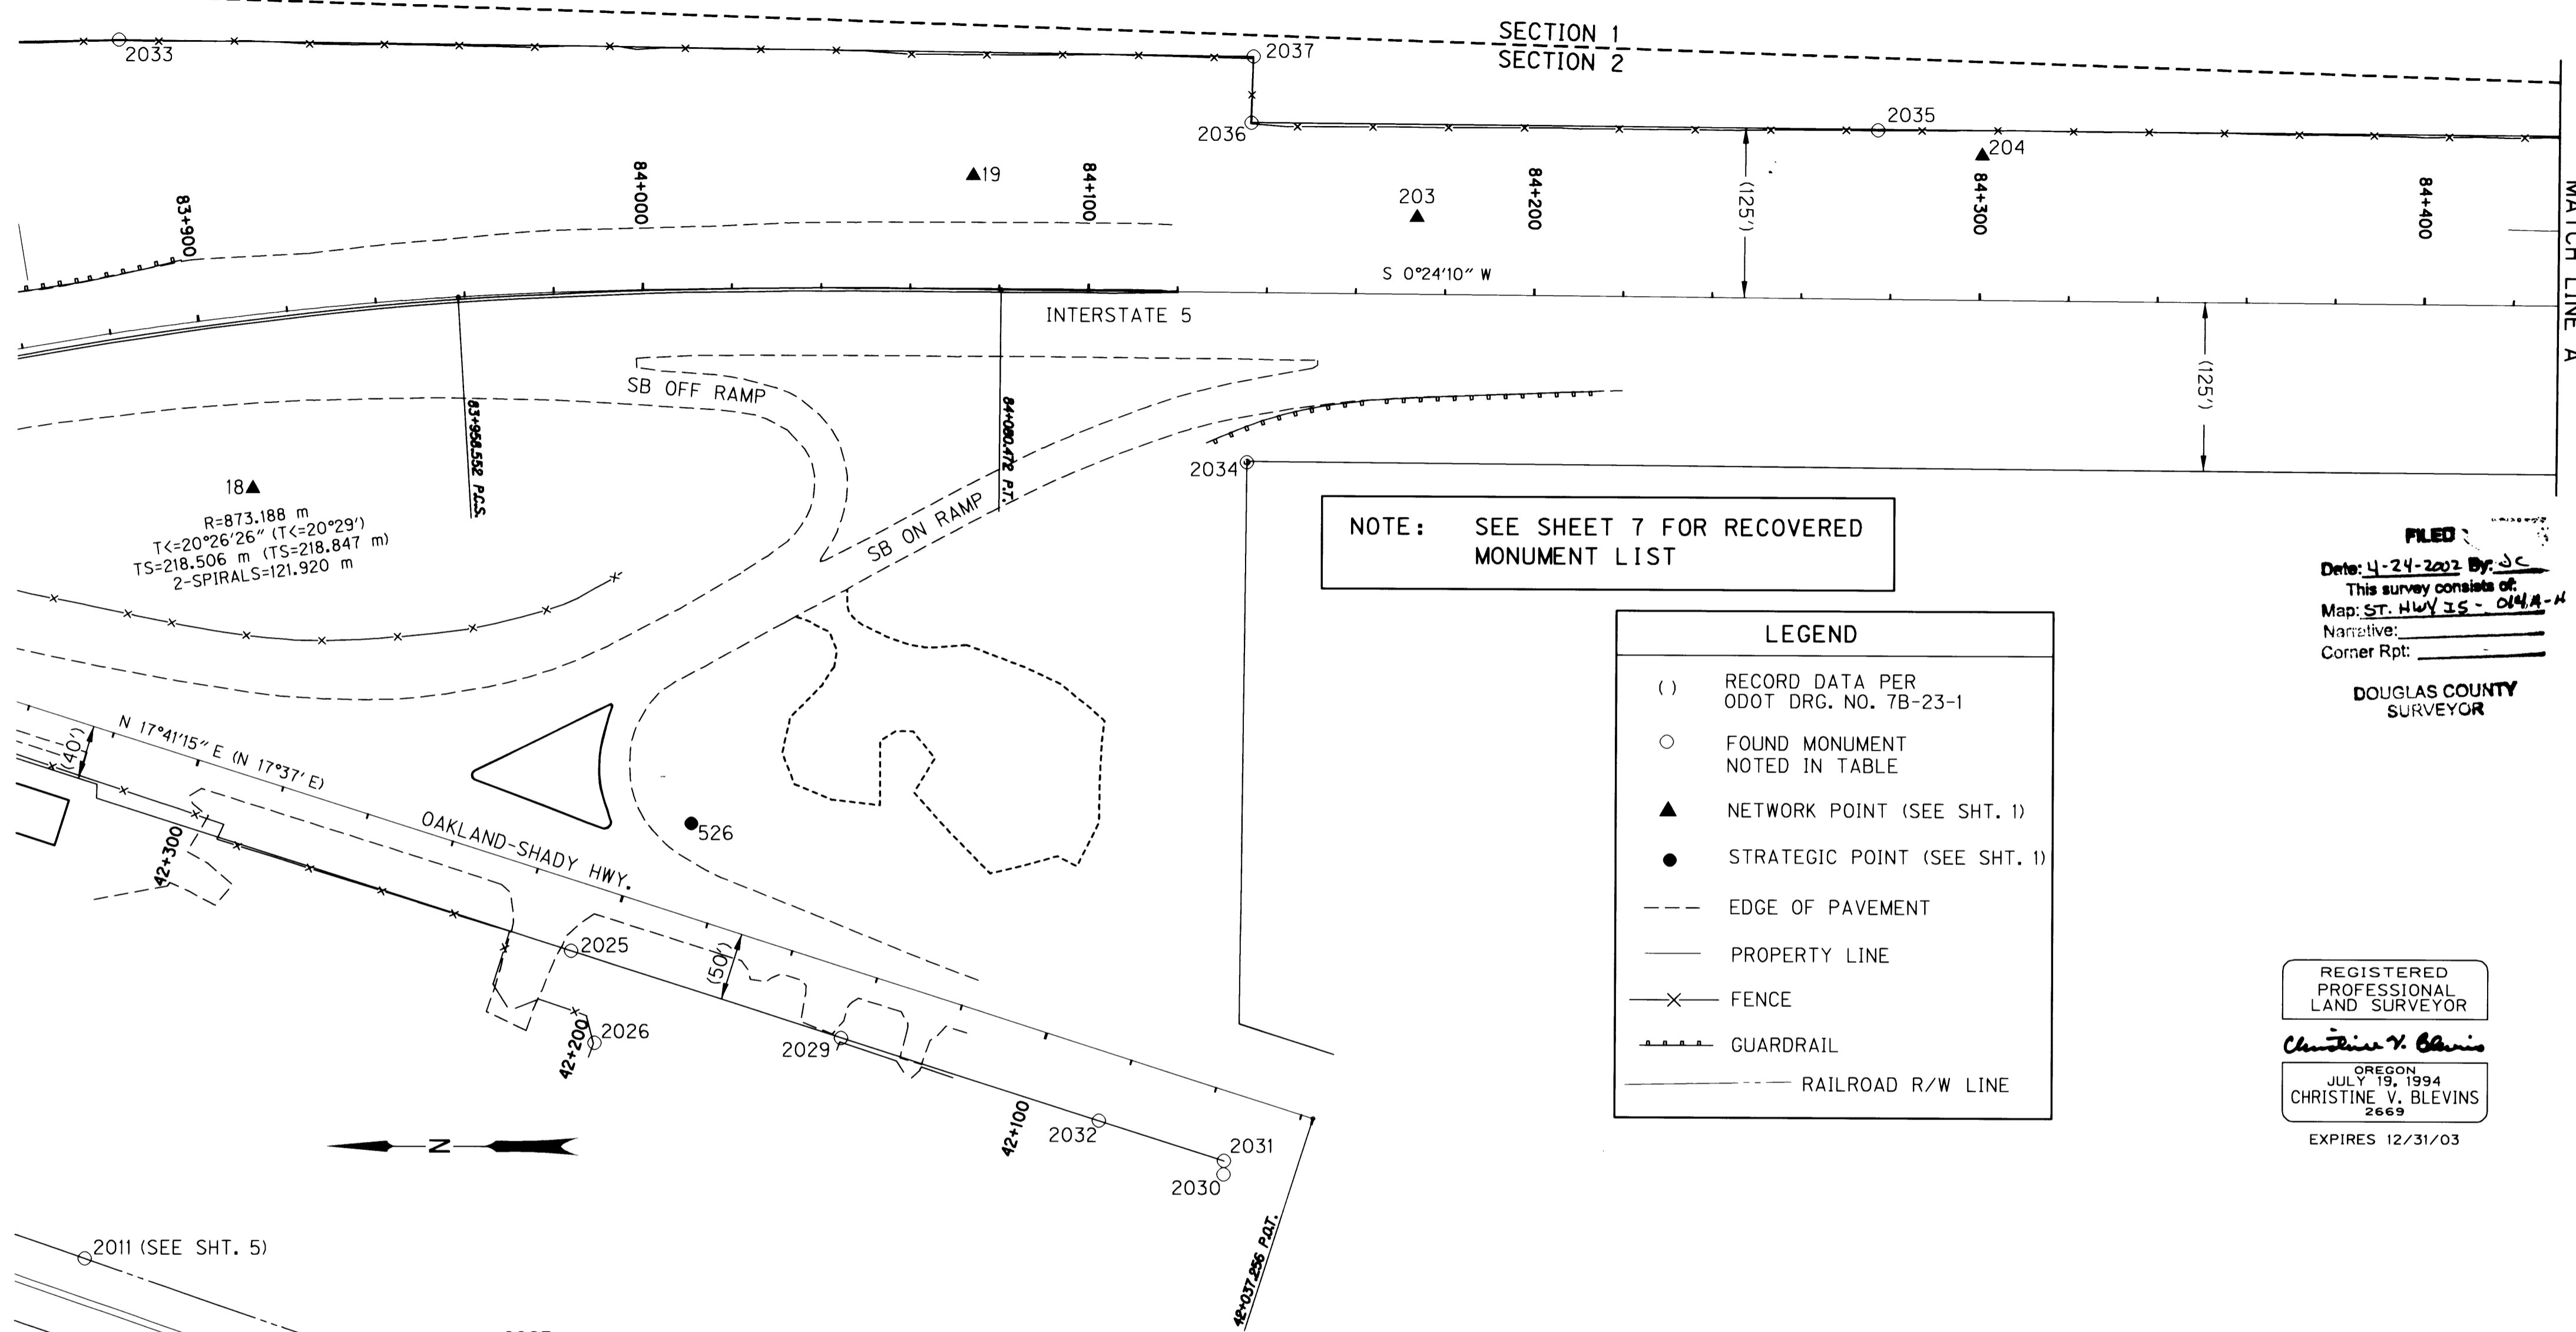



NOTE: SEE SHEET 7 FOR RECOVERED MONUMENT LIST

LEGEND	
()	RECORD DATA PER ODOT DRG. NO. 7B-23-1
○	FOUND MONUMENT NOTED IN TABLE
▲	NETWORK POINT (SEE SHT. 1)
●	STRATEGIC POINT (SEE SHT. 1)
---	EDGE OF PAVEMENT
—	PROPERTY LINE
×	FENCE
+	GUARDRAIL
---	RAILROAD R/W LINE

FILED
 Date: 4-24-2002 By: JC
 This survey consists of:
 Map: ST. HWY 15 - 014A-H
 Narrative: _____
 Corner Rpt: _____
DOUGLAS COUNTY SURVEYOR

REGISTERED PROFESSIONAL LAND SURVEYOR
Christine V. Blevins
 OREGON
 JULY 19, 1994
 CHRISTINE V. BLEVINS
 2669
 EXPIRES 12/31/03

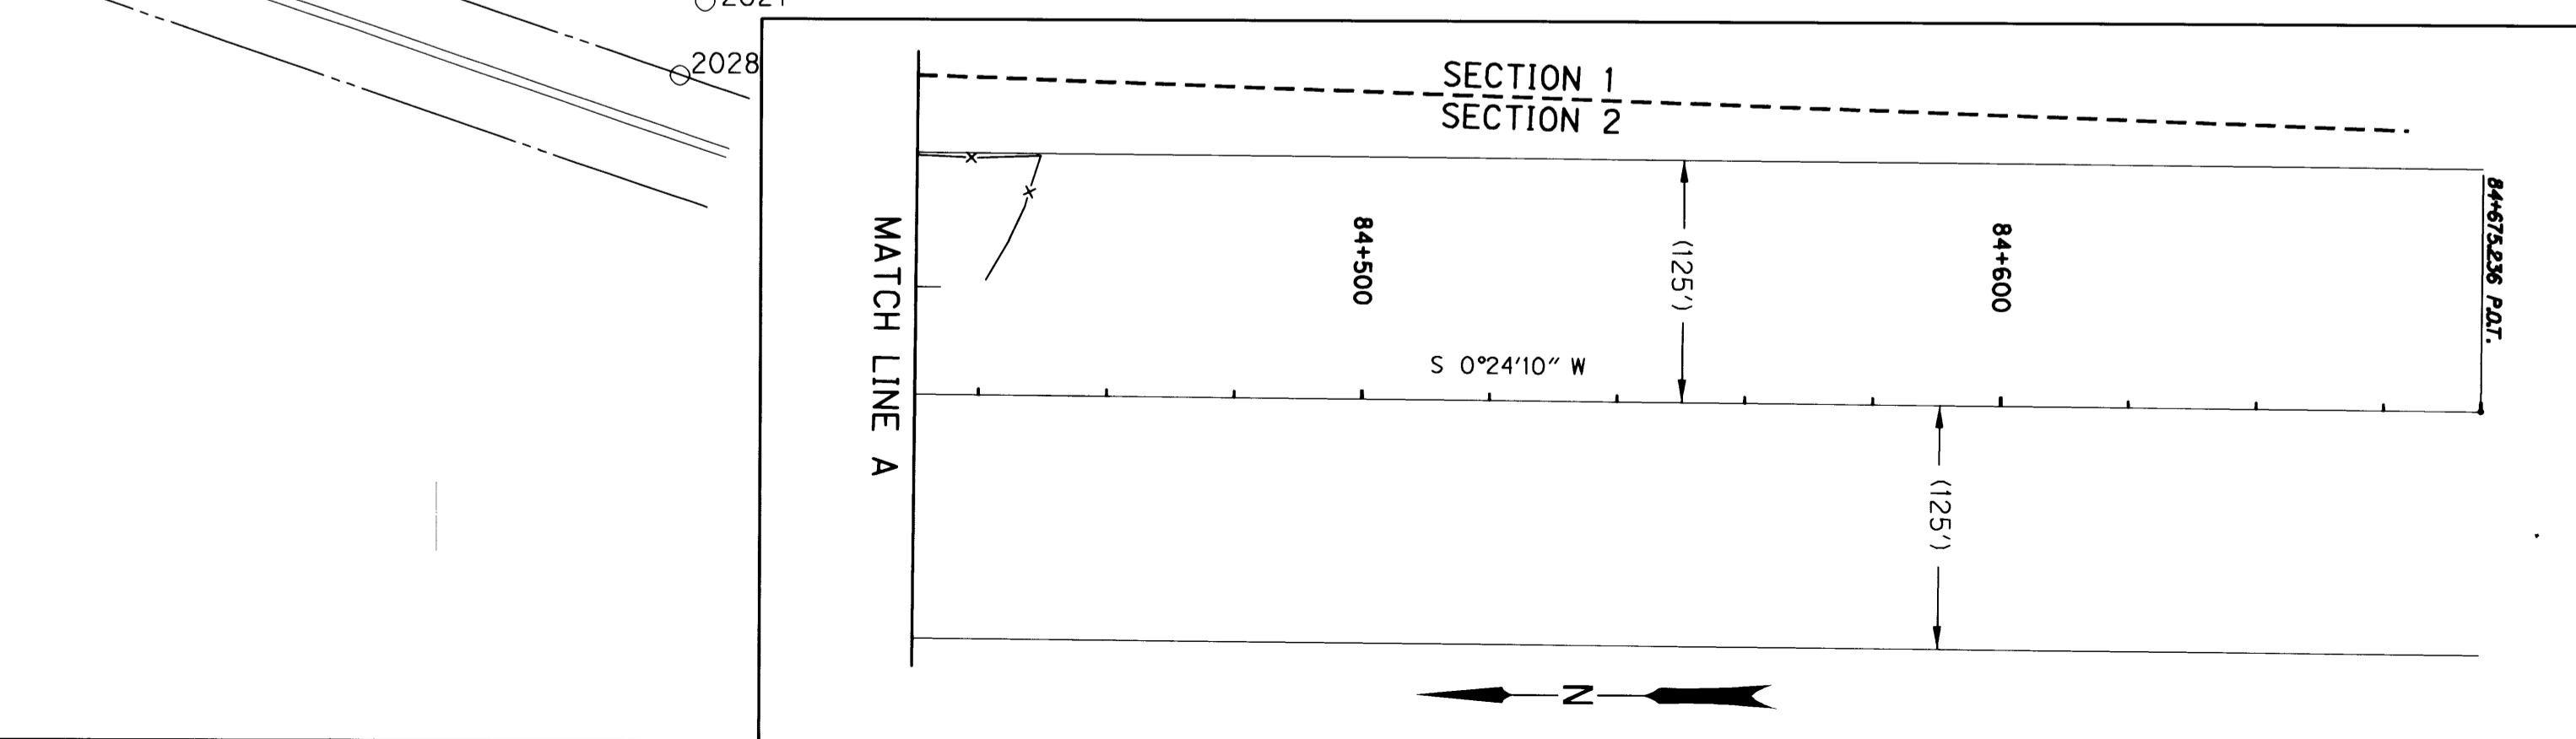

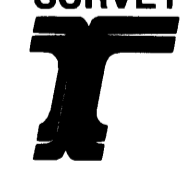METRIC SURVEY 

SCALE 1:1000

20 10 0 20 40 60 80 100 METERS

TO CONVERT METERS TO FEET DIVIDE BY 0.30480061

OREGON DEPARTMENT OF TRANSPORTATION
 HORIZONTAL CONTROL, RECOVERY AND RETRACEMENT MAP
 SHADY BRIDGE
 PACIFIC HWY. (INTERSTATE 5)
 DOUGLAS COUNTY

APRIL 15, 2002 FOR ODOT REGION 3
 3500 NW STEWART PARKWAY, ROSEBURG, OR 97470

SCALE: 1 mm = 1 m SHEET 6 OF 8