

ENGLISH

SE 1/4 SECTION 21, T30S, R5W, W.M.

FILED
Date: 2/13/2004 By: JP
This survey consists of:
Map: ST Hwy I5-015 B
Narrative:
Corner Rpt:

DOUGLAS COUNTY
SURVEYOR

17
N 478280.005
E 4174439.658
EL 717.33
10-29-03
SET 5/8" IRON ROD WITH
"ODOT CONTROL 17" BRASS CAP

16
N 478909.266
E 4173799.970
EL 730.28
10-29-03
FD. 5/8" IRON ROD WITH
"ODOT HORIZ CONTROL 76"
ALUMINUM CAP M129-39J

1002
N 478797.68
E 4173953.53
438+16.50 (438+16.03)
0.03 Rt (0.00)
11-06-03
FD. 5/8" IRON ROD NO CAP
ODOT DRG 6B-34-18

440

445

INTERSTATE 5

S 38° 04' 43" E

'15'
500' Spiral
S = 10°00'00"

'15'
500' Spiral
S = 10°00'00"
ODOT DRAWING
6B-34-18

15"
438+16.81 PT
200.00 RT STA 438+16.81
(200.00 RT STA 438+16.03)
ODOT DRAWING 6B-34-18


ODOT DRAWING 6B-34-18
(220.00 RT STA 438+16.03)
220.00 RT STA 438+16.81

☆ 2

2
N 478198.857
E 4174239.971
EL 718.96
10-29-03
FD. 3" BRASS CAP IN
CONCRETE POST
"LYNNE" CS 65-19-0

1004
N 478661.78
E 4173780.57
"15" 438+16.81 (438+16.03)
220.00 RT (220.00)
11-06-03
FD. 5/8" IRON ROD NO CAP
ODOT DRG 6B-34-18

1003
N 478674.05
E 4173796.25
"15" 438+16.81 (438+16.03)
200.09 RT (200.00)
11-06-03
FD. 5/8" IRON ROD NO CAP
ODOT DRG 6B-34-18

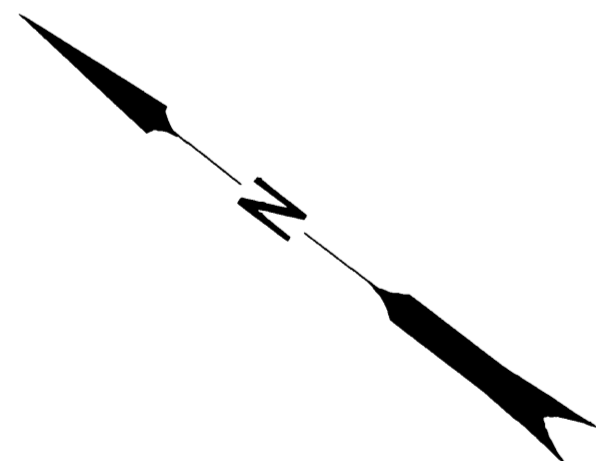

SCALE 1" = 50'



LEGEND

- ☆ FOUND GPS POINT AS PER CS 65-19
- ▲ SET NETWORK POINT AS NOTED
- △ FOUND NETWORK POINT AS PER M129-39
- FOUND MONUMENT AS NOTED
- RESOLVED RIGHT OF WAY LINE
- - - EDGE OF PAVEMENT
- TOP OF CURB

REGISTERED
PROFESSIONAL
LAND SURVEYOR
Jody S. Frasier
OREGON
JULY 25, 1991
JODY S. FRASIER
2498
EXPIRES 12-31-2005

OREGON DEPARTMENT OF TRANSPORTATION
HORIZONTAL CONTROL, RECOVERY AND RETRACTMENT MAP
INTERSTATE 5 AT EXIT 99
DOUGLAS COUNTY, OREGON

FEBRUARY 2004 FOR ODOT REGION 3
3500 NW STEWART PARKWAY, ROSEBURG, OR 97470
SCALE 1" = 50' SHEET 2 OF 10

ST. HWY. I5-015B