

ENGLISH


SE 1/4 SECTION 21, T30S, R5W, W.M.

FILED
Date: 2/13/2004 By: JP
This survey consists of:
Map: ST. Hwy 15-015 C
Narrative:
Corner Rpt:
DOUGLAS COUNTY SURVEYOR

1021
N 477726.19
E 4175009.30
"99" 71+47.40
30.00 RT
[11-06-03]
FD. 1" IR NO CAP
M 133-63 SHOWS
FOUND 1" IRON PIPE

"99" 71+83.37 POE
N 477727.3826
E 4174966.6461

1021
TILLER - TRAIL HWY
N 43° 43' 35" W

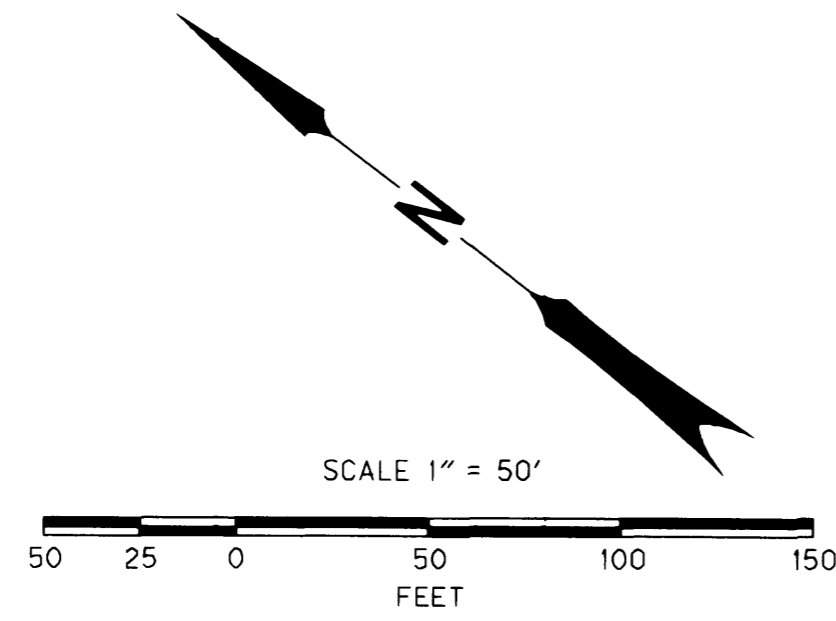

17
N 478280.005
E 4174439.658
EL 717.33
10-29-03
SET 5/8" IRON ROD WITH
"ODOT CONTROL 17" BRASS CAP

18
N 478079.394
E 4174464.957
EL 716.71
10-29-03
FD. 5/8" IRON ROD WITH
"ODOT HORIZ CONTROL 77"
ALUMINUM CAP M129-39J

17
▲
445

450

455

INTERSTATE 5 S 38° 04' 43" E

△18

☆2

220.00 RT STA 452+50.88
(220.00 RT STA 452+50)
ODOT DRAWING 68-34-181

240.00 RT STA 454+00.88
(240.00 RT STA 454+00)
ODOT DRAWING 68-34-18

2
N 478198.857
E 4174239.971
EL 718.96
10-29-03
FD. 3" BRASS CAP IN
CONCRETE POST
"LYNNE" CS 65-19-0

1117
N 477532.51
E 4174664.48
452+50.87
220.68 RT
12-02-03
FD. 5/8" IRON ROD WITH
"WYTCHERLY LS 2724"
YELLOW CAP
PARTITION 1997-0058

LEGEND

- ☆ FOUND GPS POINT AS PER CS 65-19
- ▲ SET NETWORK POINT AS NOTED
- △ FOUND NETWORK POINT AS PER M129-39
- FOUND MONUMENT AS NOTED
- RESOLVED RIGHT OF WAY LINE
- - - EDGE OF PAVEMENT
- TOP OF CURB

REGISTERED PROFESSIONAL LAND SURVEYOR
Jody E. Frasier
JODY E. FRASIER
2+02
EXPIRES 12-31-2005

OREGON DEPARTMENT OF TRANSPORTATION
HORIZONTAL CONTROL, RECOVERY AND RETRACTMENT MAP
INTERSTATE 5 AT EXIT 99
DOUGLAS COUNTY, OREGON

FEBRUARY 2004 FOR ODOT REGION 3
3500 NW STEWART PARKWAY, ROSEBURG, OR 97470
SCALE 1" = 50' SHEET 3 OF 10