


ENGLISH

SE 1/4 SECTION 21, NW 1/4 SECTION 27, NE 1/4 SECTION 28, T30S, R5W, W.M.

FILED
 Date: 2/13/2004 By: JP
 This survey consists of:
 Map: ST HWY 15-015 F
 Narrative:
 Corner Rpt:
 DOUGLAS COUNTY SURVEYOR

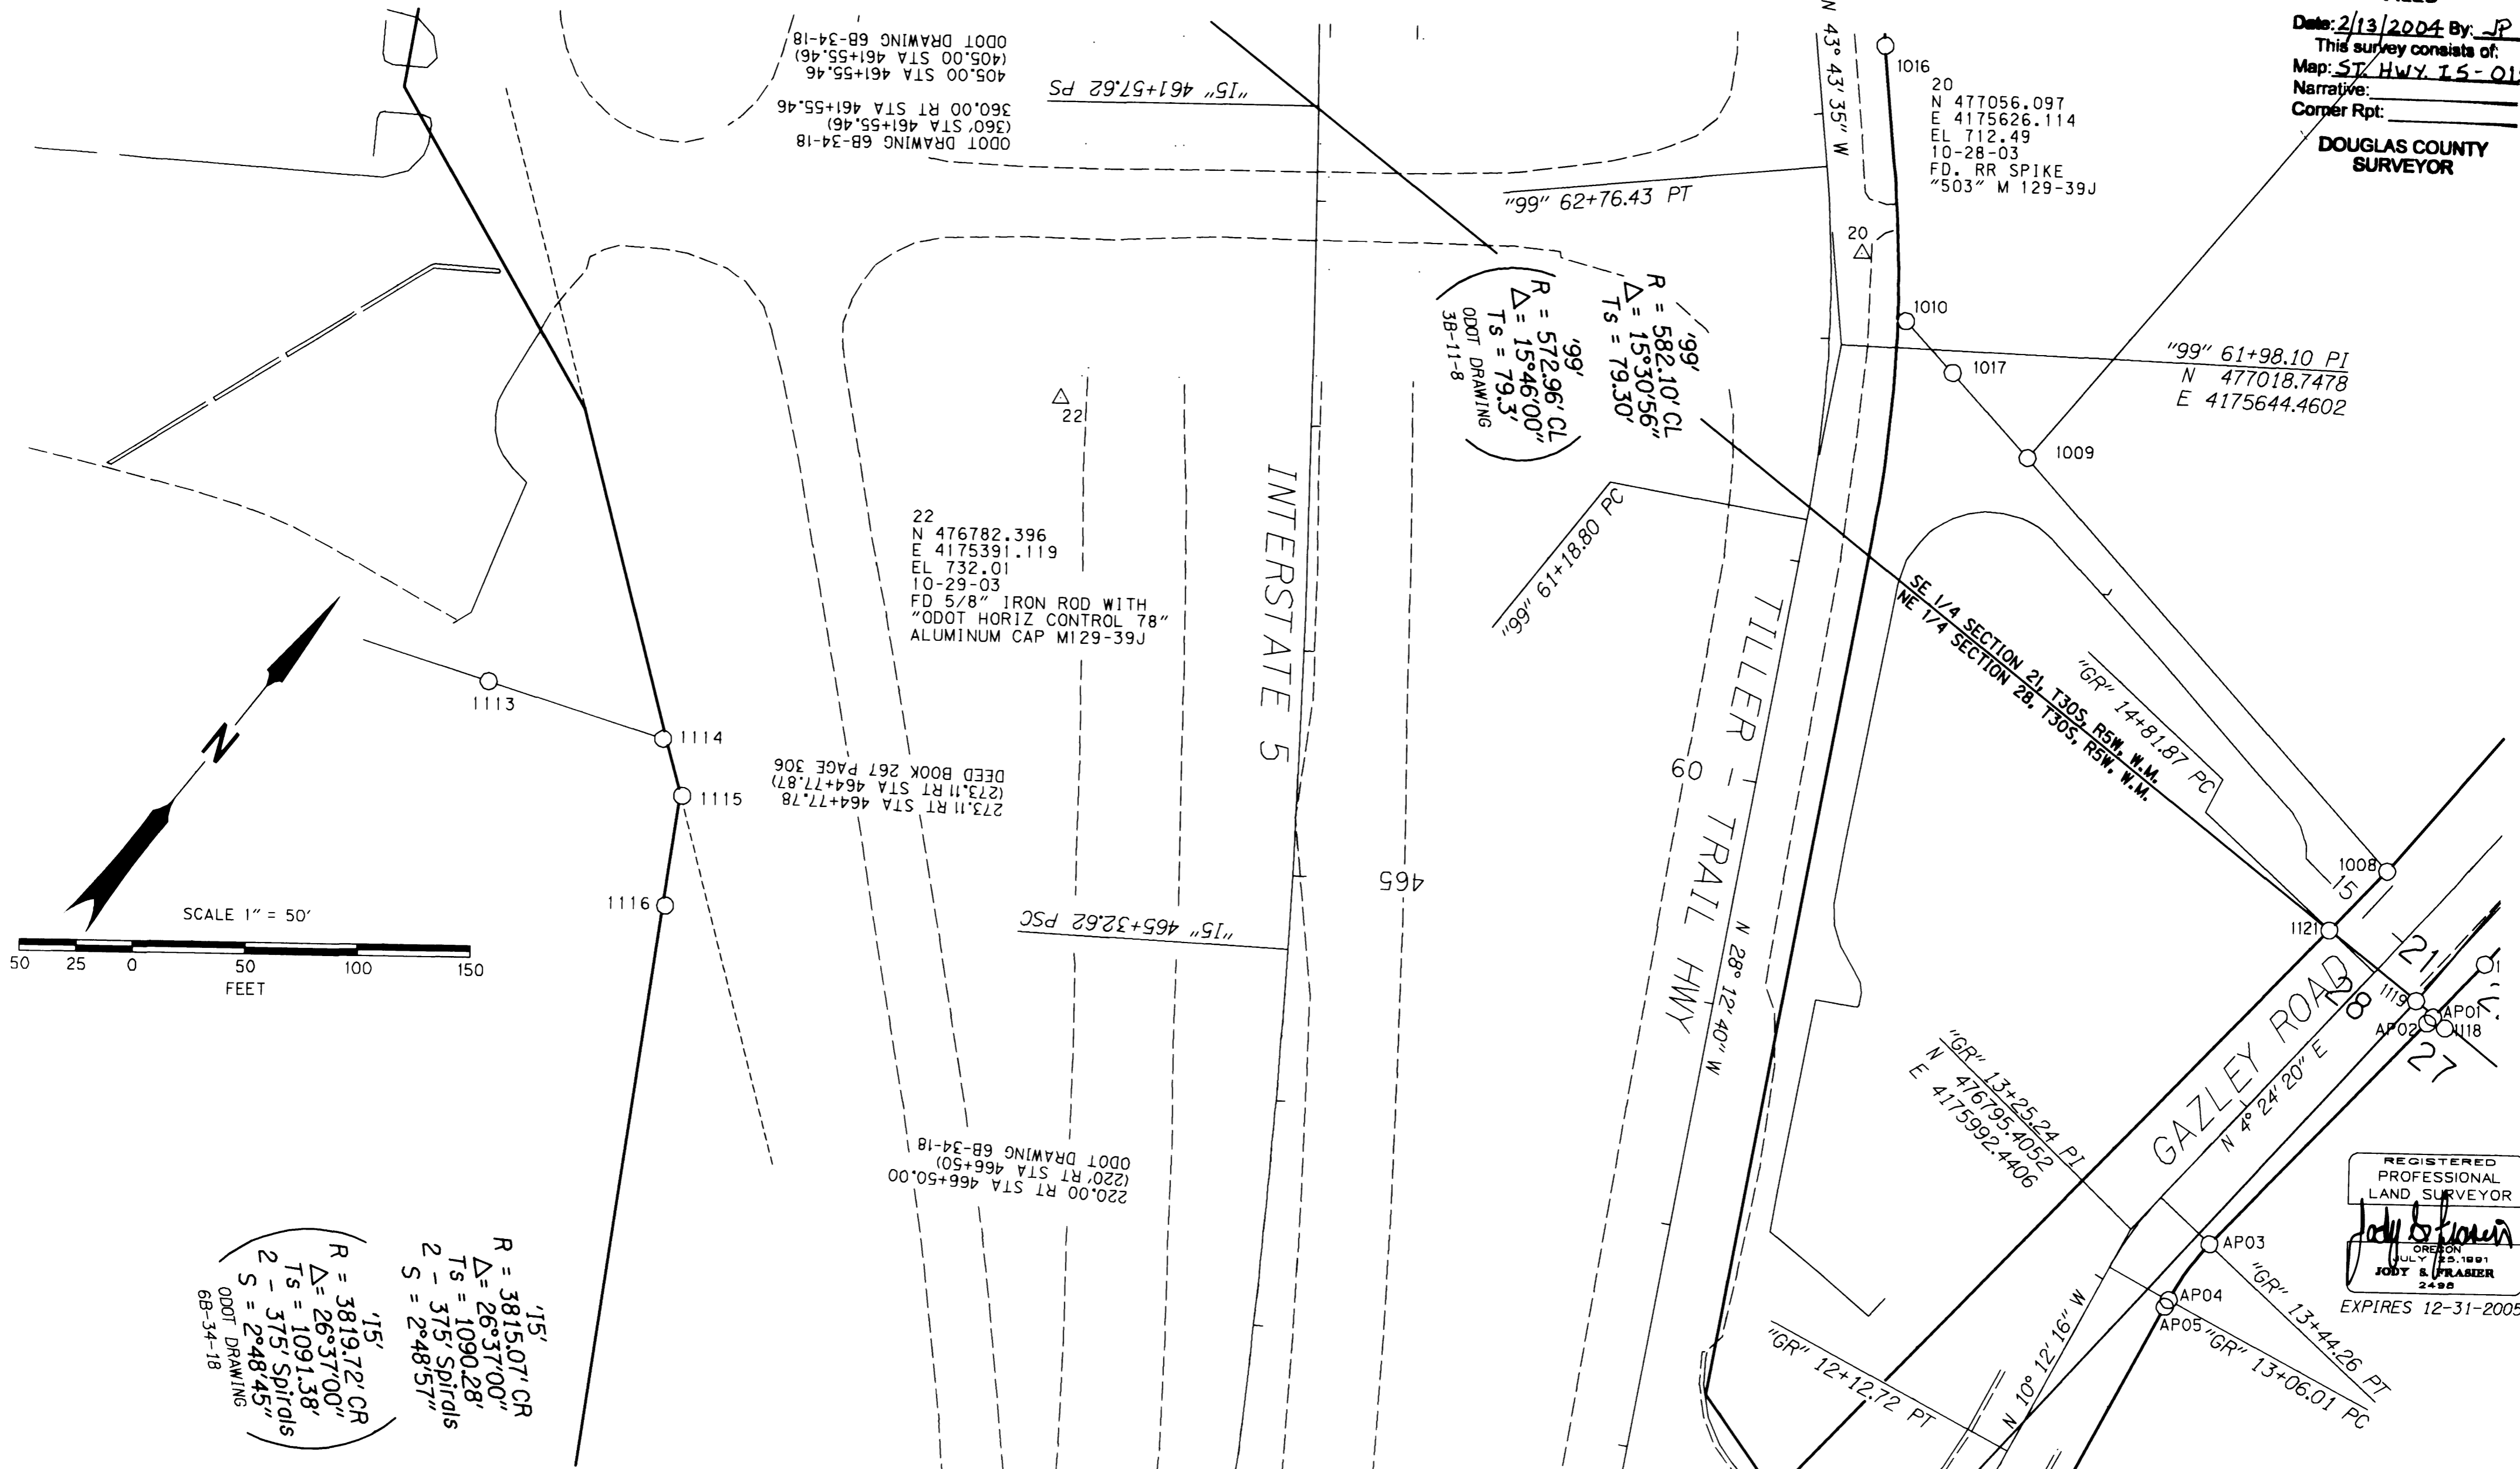

$R = 3819.72'$ CR
 $\Delta = 26^{\circ}37'00''$
 $Ts = 1091.38'$
 $S = 375'$ Spirals
 $S = 2^{\circ}48'45''$
 ODOT DRAWING 68-34-18

$R = 3815.07'$ CR
 $\Delta = 26^{\circ}37'00''$
 $Ts = 1090.28'$
 $S = 375'$ Spirals
 $S = 2^{\circ}48'57''$
 ODOT DRAWING 68-34-18

RECOVERED MONUMENT LIST

PT. NO.	LDP NORTHING	LDP EASTING	STATION	OFFSET	DATE	DESCRIPTION & REFERENCE DOCUMENTS
1008	476990.03	4175980.69	"GR" 15+18.29	26.54 LT	11-06-03	FD. 1 1/4" IRON PIPE CS 51-133-3
1009	477031.64	4175740.56	N/A	N/A	11-06-03	FD. 1 3/8" IRON PIPE M 68-57 CALLS FOR A 3/4" IRON ROD
1010	477044.83	4175660.26	"99" 62+08.80	33.59 RT	11-06-03	FD. 1 1/4" IRON PIPE CS 51-133-3
1016	477133.87	4175575.86	"99" 63+27.74	30.00 RT	11-06-03	FD. 1 1/4" IRON PIPE CS 51-133-3
1017	477040.13	4175690.83	N/A	N/A	11-06-03	FD. 1 1/4" IRON PIPE CS 51-133-3
1113	476525.26	4175273.27	N/A	N/A	12-02-03	FD. 5/8" IRON ROD WITH "BENTZ SURVEY INC" YELLOW CAP RM3-64
1114	476553.93	4175349.62	"15" 464+52.31	282.05 RT	12-02-03	FD. 5/8" IRON ROD WITH "WYCHTERLY LS 2724" YELLOW CAP PARTION 1997-0058
1115	476539.66	4175372.14	"15" 464+78.70 (464+77.87)	272.29 RT (273.11)	12-02-03	FD. 5/8" IRON ROD NO CAP ORIGIN UNKNOWN BOOK 267, PAGE 306, DOUGLAS COUNTY DEED RECORDS
1116	476496.96	4175397.13	"15" 465+31.48 (465+31.46)	276.88 RT	12-02-03	FD. 5/8" IRON ROD NO CAP ORIGIN UNKNOWN ODOT DRG 68-34-18

LEGEND

- ▲ SET NETWORK POINT AS NOTED
- △ FOUND NETWORK POINT AS PER M129-39
- FOUND MONUMENT AS NOTED
- RESOLVED RIGHT OF WAY LINE
- - - EDGE OF PAVEMENT
- TOP OF CURB

REGISTERED PROFESSIONAL LAND SURVEYOR
Jody S. Prasher
 OREGON JULY 25, 1991
 JODY S. PRASHER 2498
 EXPIRES 12-31-2005

OREGON DEPARTMENT OF TRANSPORTATION
 HORIZONTAL CONTROL, RECOVERY AND RETRACTMENT MAP
 INTERSTATE 5 AT EXIT 99
 DOUGLAS COUNTY, OREGON

FEBRUARY 2004 FOR ODOT REGION 3
 3500 NW STEWART PARKWAY, ROSEBURG, OR 97470
 SCALE 1" = 50'

SHEET 6 OF 10