


COUNTY SURVEYORS FILE DATA
DO NOT REMOVE FROM OFFICE

FILED
On: 10/19/2010 By: JC
This survey consists of
Map: ST HWY
Narrative: IS-024
Corner Rpt: A-GG
DOUGLAS COUNTY
SURVEYOR

NE 1/4 SEC. 2, T. 33 S, R. 6 W., W.M.
SE 1/4 SEC. 2, T. 33 S, R. 6 W., W.M.

LEGEND


- PROTRACTED LOT LINE
- EDGE OF PAVEMENT
- RIGHT-OF-WAY
- PROPERTY LINE
- (1234) COMPUTED R/W POINT
- ★ SET GPS POINT
- ▲ SET NETWORK POINT
- FOUND MONUMENT
- () RECORD DATA (88-30-1)

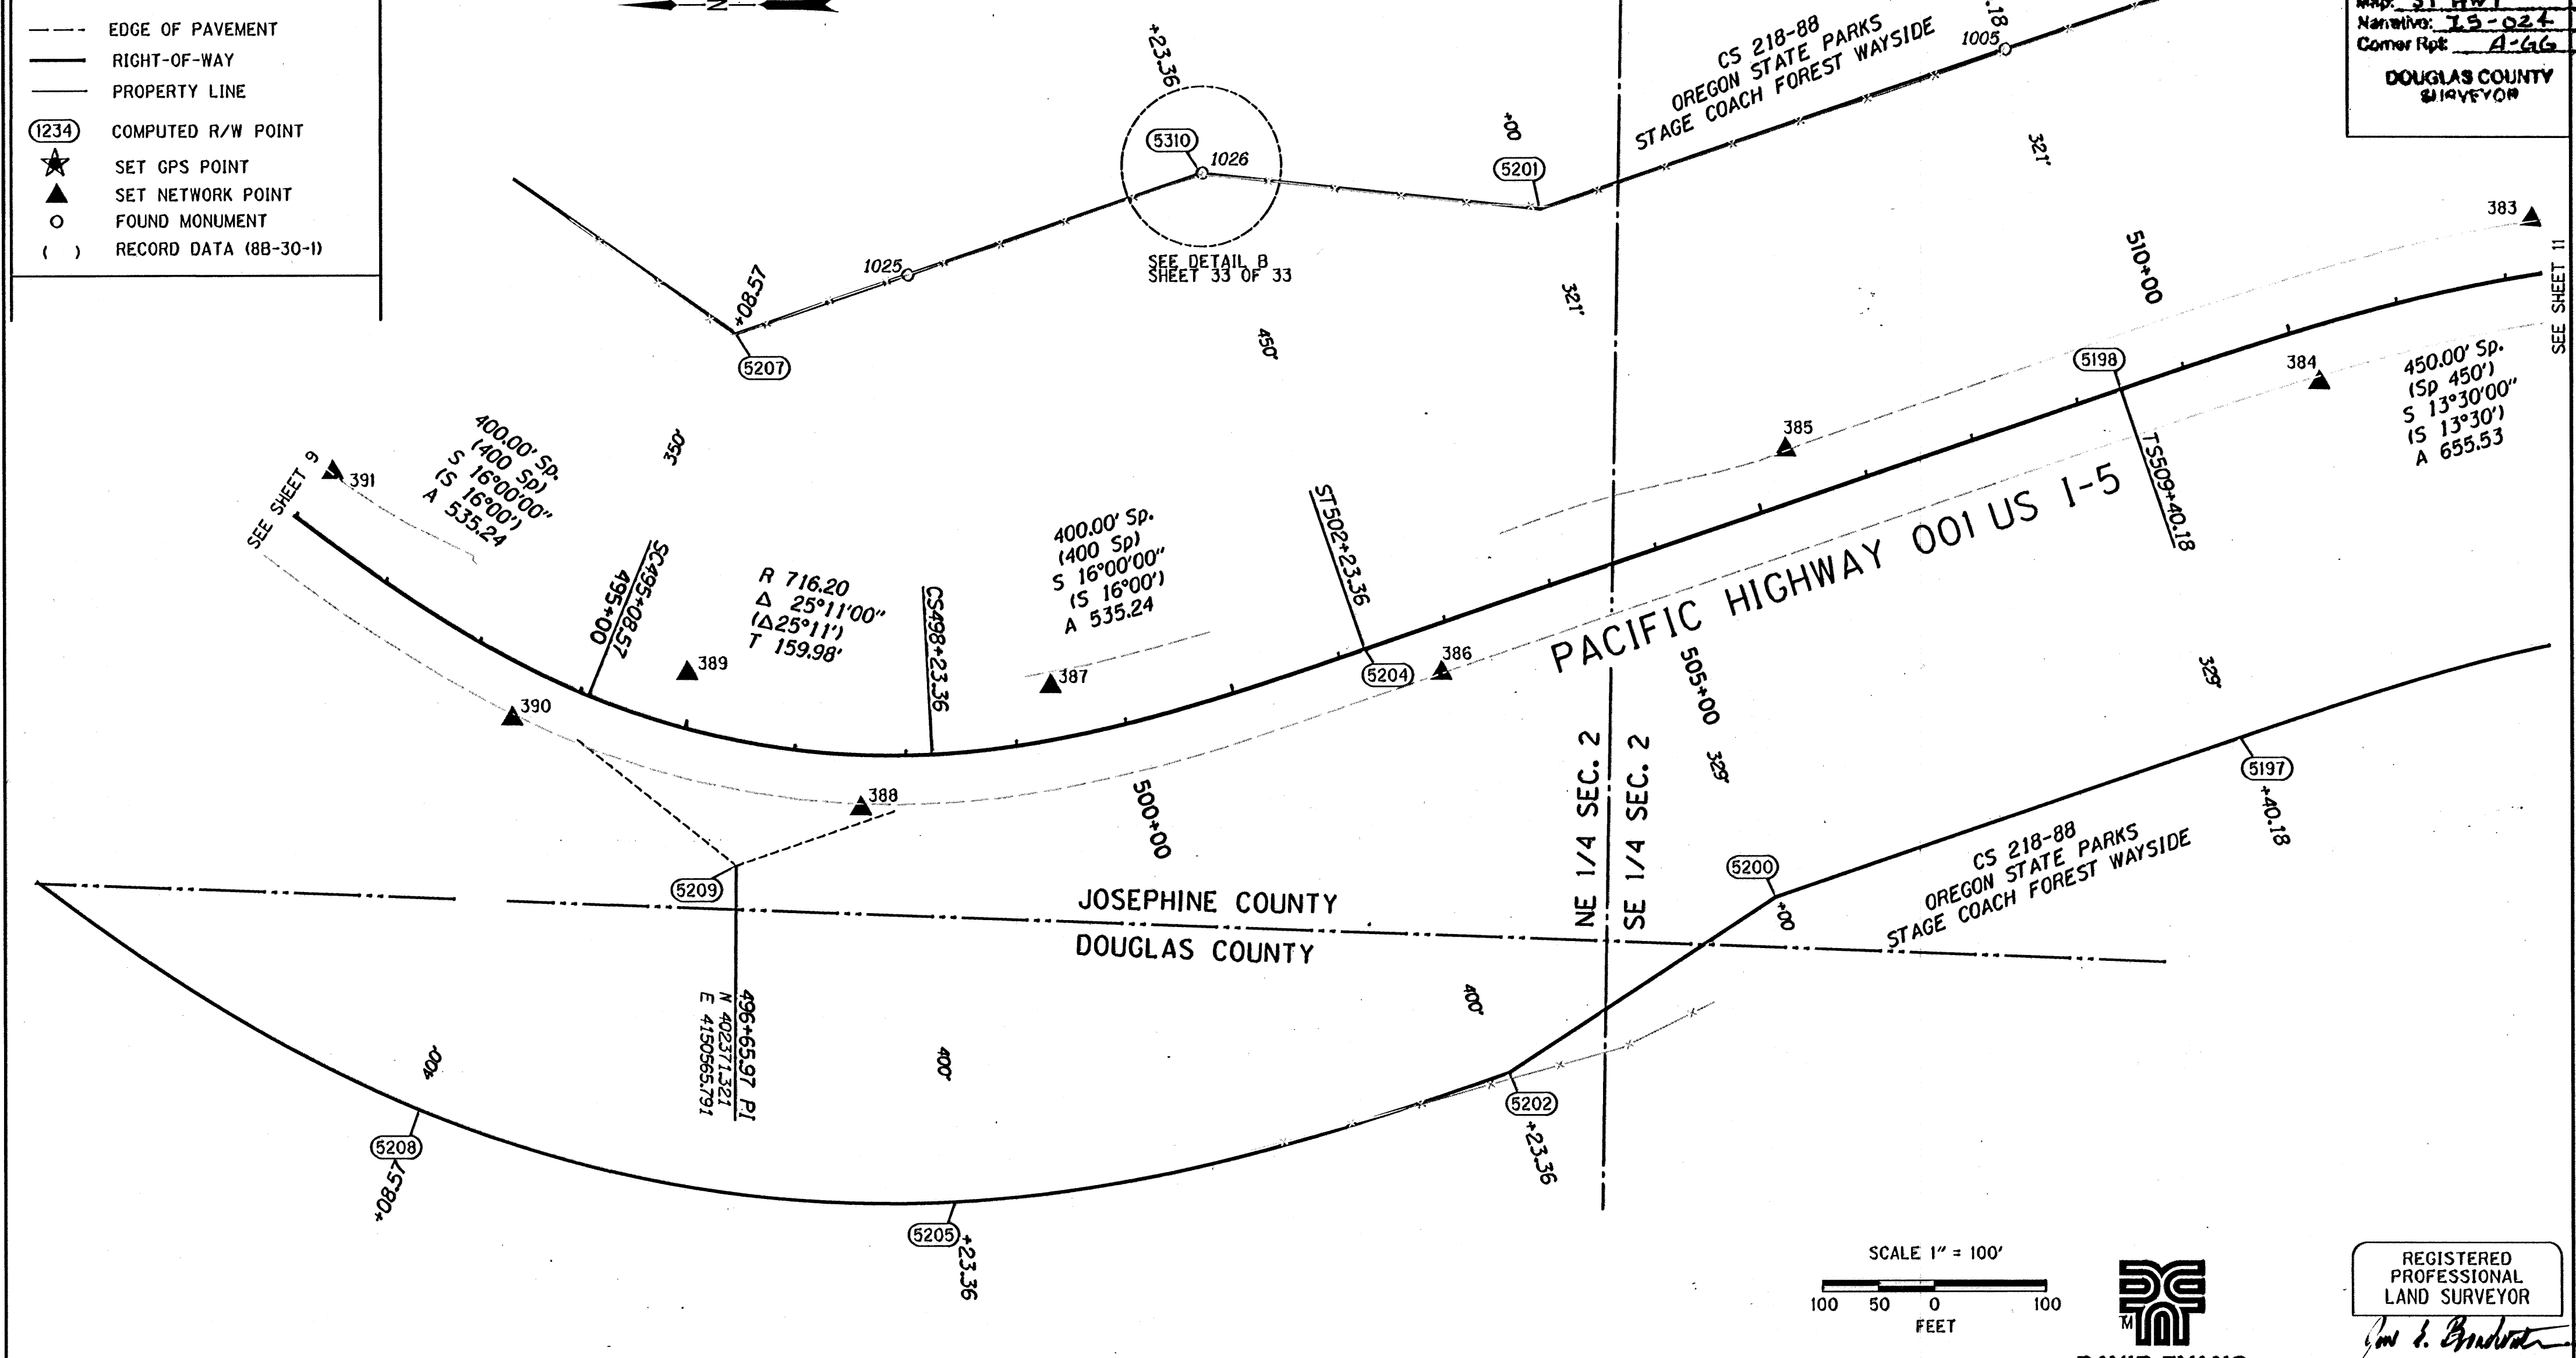

RECOVERED MONUMENTS AND COMPUTED POINTS LIST

W=WITH, IP=IRON PIPE, IR=IRON ROD, YPC=YELLOW PLASTIC CAP, DRG=ODOT DRAWING B=BOOK P=PAGE
CSN1= COUNTY SURVEY NOT IDENTIFIED

PT. NO.	LDP NORTHING	LDP EASTING	STATION	OFFSET	DATE	DESCRIPTION & REFERENCE DOCUMENTS
1005	401232.50	4151292.85	509+40.98	320.72 LT	11/10/2009	FOUND 5/8" IR NO CAP, UP 0.4', ODOT 88-30-1
1025	402216.33	4151093.86	498+25.10	429.63 LT	12/29/2009	FOUND 5/8" IR W/NO CAP, ODOT 88-30-1
1026	401952.30	4151183.96	502+24.54	449.91 LT	12/30/2009	FOUND 5/8" IR W/NO CAP, SMOOTH SIDES, UP 0.4', ODOT 88-30-1
5197	401023.61	4150677.62	509+40.18	329.00 RT		CALCULATED MONUMENT
5198	401129.77	4150989.02	509+40.18	0.00		CALCULATED MONUMENT
5200	401440.25	4150535.59	505+00.00	329.00 RT		CALCULATED MONUMENT
5201	401649.98	4151150.83	505+00.00	321.00 LT		CALCULATED MONUMENT
5202	401679.19	4150379.13	502+23.36	400.00 RT		CALCULATED MONUMENT
5204	401808.25	4150757.74	502+23.36	0.00		CALCULATED MONUMENT
5205	402176.15	4150265.21	498+23.36	400.00 RT		CALCULATED MONUMENT
5207	402370.45	4151041.39	495+08.57	350.00 LT		CALCULATED MONUMENT
5208	402655.77	4150347.78	495+08.57	400.00 RT		CALCULATED MONUMENT
5209	402371.32	4150565.79	496+65.97	110.04 RT		CALCULATED MONUMENT
5310	401953.45	4151183.67	502+23.36	450.00 LT		CALCULATED MONUMENT

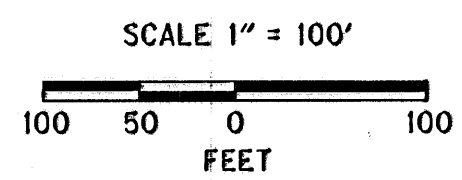

DAVID EVANS AND ASSOCIATES INC.
530 CENTER STREET NE, SUITE 605
SALEM OREGON 97301
PHONE: 503.361.8635

REGISTERED PROFESSIONAL LAND SURVEYOR

Jon K. Broadwater

OREGON
JULY 11, 2006
JON KENNETH BROADWATER
61360LS
EXPIRES: 12/31/2011



FILE NAME: 16763RET.DGN

OREGON DEPARTMENT OF TRANSPORTATION
HORIZONTAL CONTROL, RECOVERY, AND RETRACEMENT SURVEY
I-5: JUMPOFF JOE-GLENDALE PAVING AND CLIMBING LANES
GLENDALE TO SUNNY VALLEY
JOSEPHINE AND DOUGLAS COUNTIES

ODOT REGION 3 WHITE CITY
100 ANTELOPE ROAD
WHITE CITY, OREGON 97503

SEPTEMBER 28, 2010
SCALE: 1" = 100'
SHEET 10 OF 33

THIS IS TO CERTIFY THAT THIS MAP WAS PREPARED USING HP DESIGNJET 1055CM, BLACK C4820g INK ON HP MATTE FILM #51642B.

ST. HWY. I5 -024 J