


NW 1/4 SEC. 13, T. 33 S, R. 6 W., W.M.
 NE 1/4 SEC. 14, T. 33 S, R. 6 W., W.M.

**COUNTY SURVEYORS FILE DATA
 DO NOT REMOVE FROM OFFICE**

FILED
 Date: 10-19-2010 By: J
 This survey consists of
 Map: ST HWY
 Narrative: IS-024
 Corner Rpt: A-GG
**DOUGLAS COUNTY
 SURVEYOR**

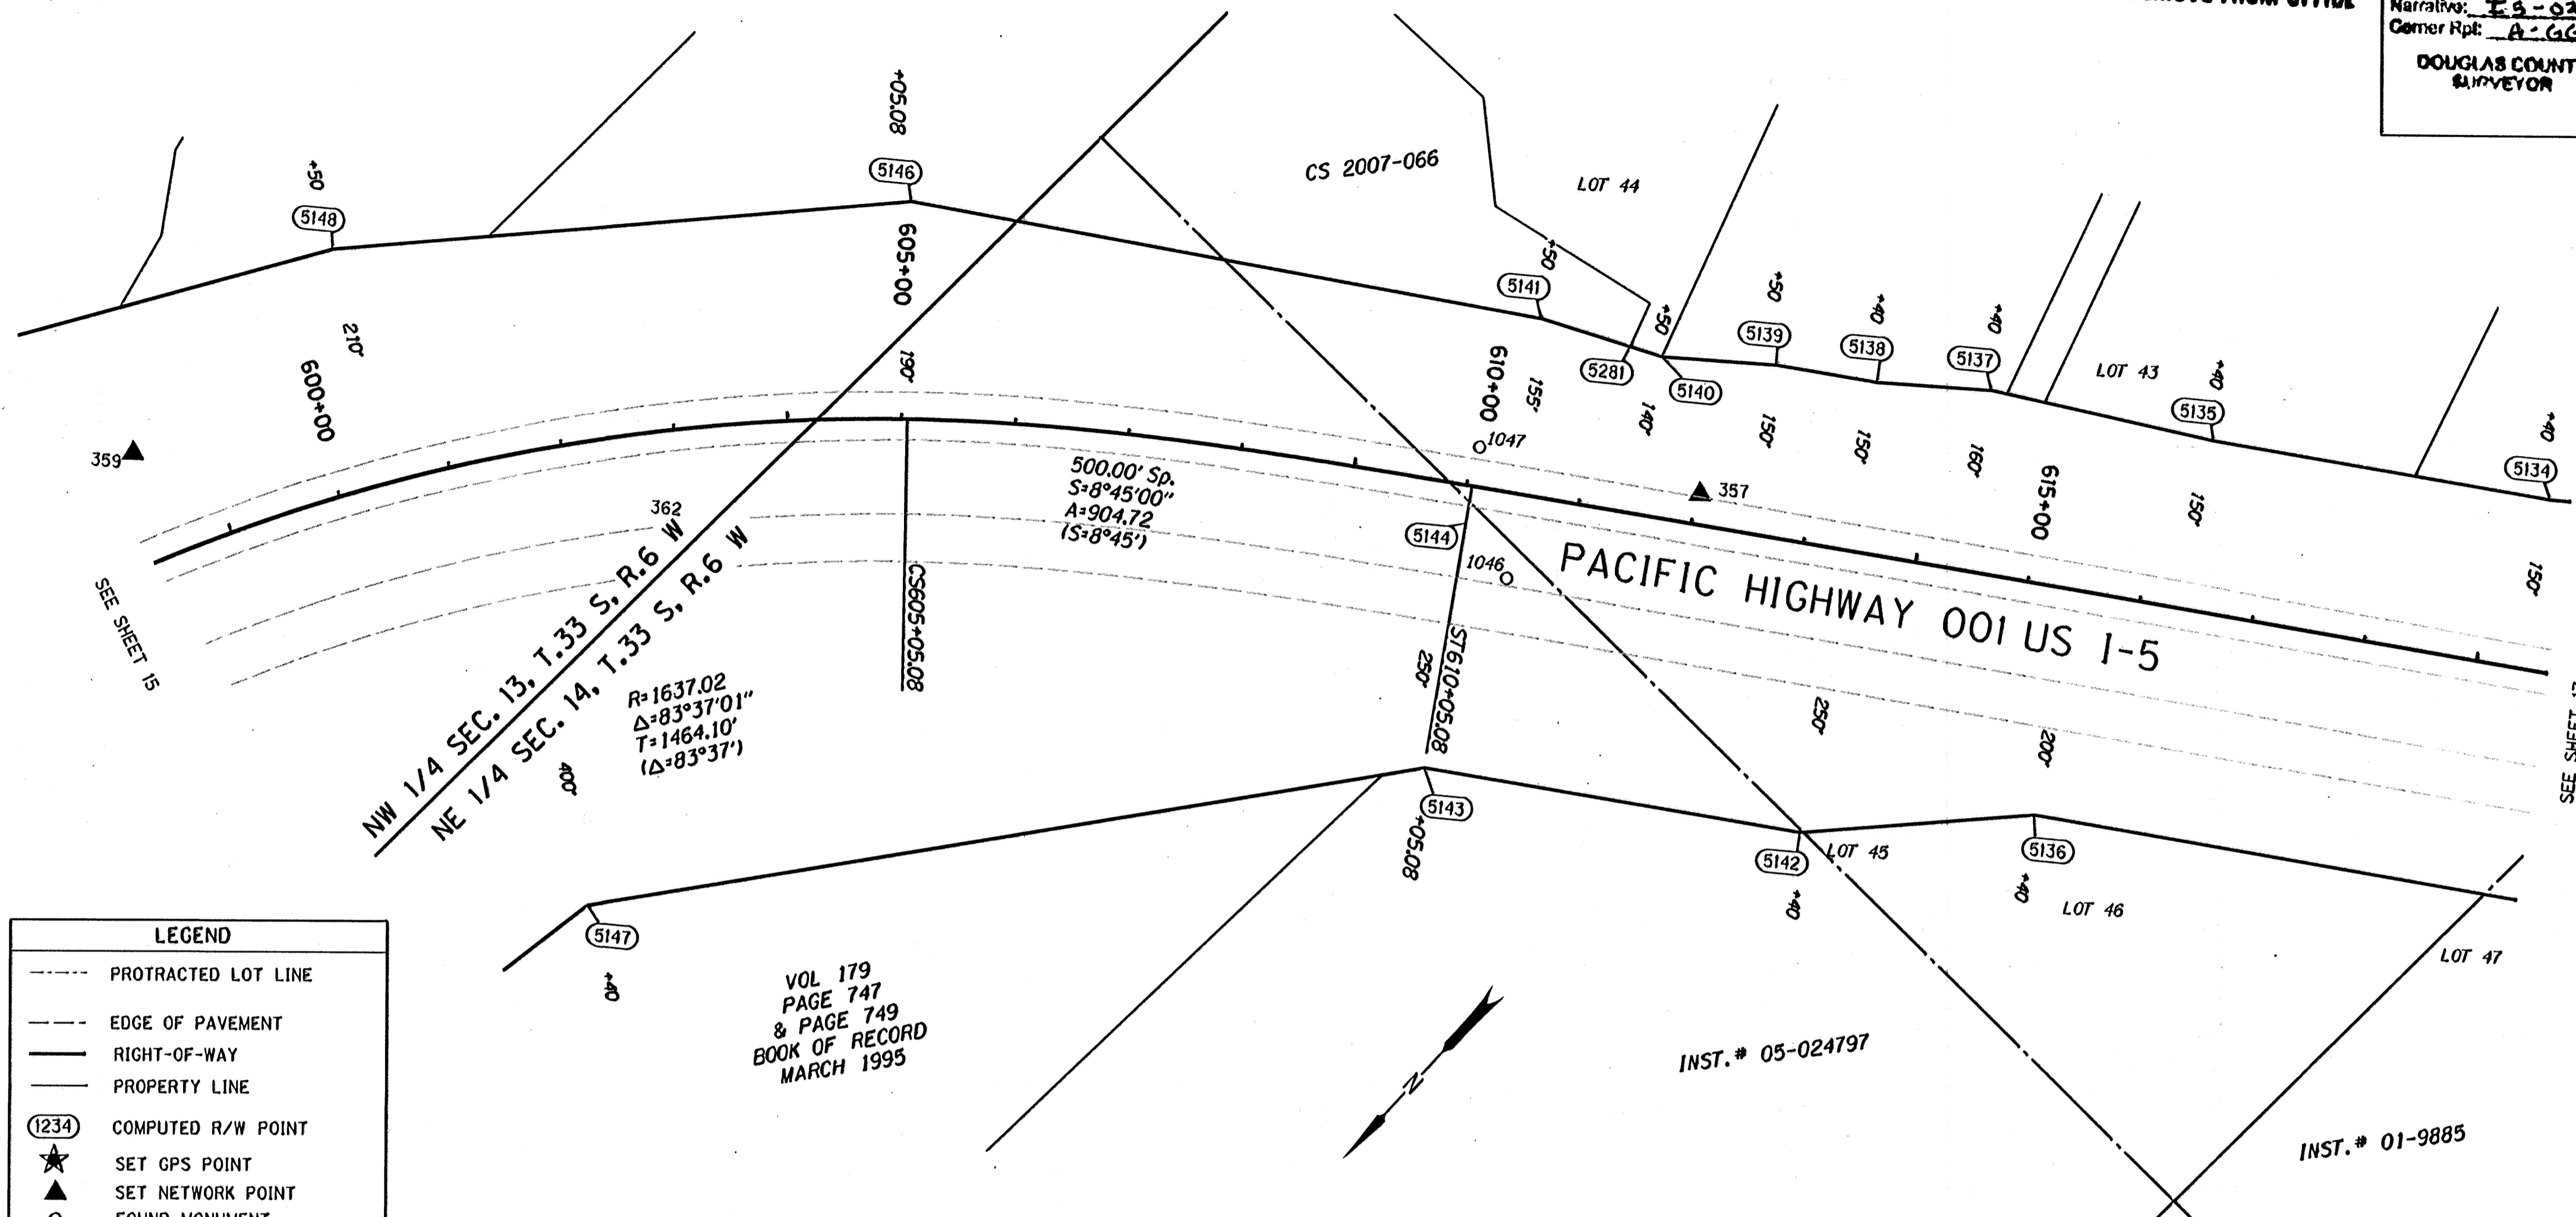


LEGEND

- PROTRACTED LOT LINE
- EDGE OF PAVEMENT
- RIGHT-OF-WAY
- PROPERTY LINE
- (1234) COMPUTED R/W POINT
- ★ SET GPS POINT
- ▲ SET NETWORK POINT
- FOUND MONUMENT
- () RECORD DATA (8B-30-1)

W=WITH, IP=IRON PIPE, IR=IRON ROD, YPC=YELLOW PLASTIC CAP, DRG=ODOT DRAWING B=BOOK P=PAGE
 BD=BRASS DISK, CONC=CONCRETE, CSNI= COUNTY SURVEY NOT IDENTIFIED

RECOVERED MONUMENTS AND COMPUTED POINTS LIST

PT. NO.	LDP NORTHING	LDP EASTING	STATION	OFFSET	DATE	DESCRIPTION & REFERENCE DOCUMENTS
1046	392349.45	4150949.56	610+48.56	74.67 RT	01/21/2010	FOUND 2 1/2" BD IN CONC, DOWN 0.1', "SB 609+54.53 PT BK = SB 608+89.81 POT AHD", ODOT 8B-30-1
1047	392281.42	4151045.65	610+05.71	35.00 LT	01/21/2010	FOUND 2 1/2" BD IN CONC, DOWN 0.1', "RP PT LN 610+06.01 35'LT", ODOT 8B-30-1
5134	390372.57	4148106.88	619+40.00	150.00 LT		CALCULATED MONUMENT
5135	391836.57	4150579.12	616+40.00	150.00 LT		CALCULATED MONUMENT
5136	392183.89	4150470.17	615+40.00	200.00 RT		CALCULATED MONUMENT
5137	391938.20	4150751.66	614+40.00	160.00 LT		CALCULATED MONUMENT
5138	392001.54	4150829.69	613+40.00	150.00 LT		CALCULATED MONUMENT
5139	392051.03	4150904.86	612+50.00	150.00 LT		CALCULATED MONUMENT
5140	392114.37	4150982.88	611+50.00	140.00 LT		CALCULATED MONUMENT
5141	392162.33	4151083.00	610+40.00	155.00 LT		CALCULATED MONUMENT
5142	392335.63	4150609.73	613+40.00	250.00 RT		CALCULATED MONUMENT
5143	392519.80	4150889.46	610+05.08	250.00 RT		CALCULATED MONUMENT
5144	392338.72	4151008.68	610+05.08	33.19 RT		CALCULATED MONUMENT
5146	392465.58	4151557.01	605+05.08	190.00 LT		CALCULATED MONUMENT
5147	393109.46	4151343.80	601+40.00	400.00 RT		CALCULATED MONUMENT
5148	392843.24	4151898.90	600+50.00	210.00 LT		CALCULATED MONUMENT
5281	392126.67	4151009.28	611+21.19	144.25 LT		CALCULATED MONUMENT

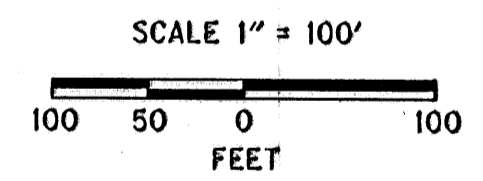

**DAVID EVANS
 AND ASSOCIATES INC.**
 530 CENTER STREET NE, SUITE 605
 SALEM OREGON 97301
 PHONE: 503.361.8635

REGISTERED
 PROFESSIONAL
 LAND SURVEYOR
David Evans
 OREGON
 JULY 11, 2006
 JON KENNETH BROADWATER
 61360LS
 EXPIRES: 12/31/2011



OREGON DEPARTMENT OF TRANSPORTATION
 HORIZONTAL CONTROL, RECOVERY, AND RETRACEMENT SURVEY
 I-5: JUMPOFF JOE-GLENDALE PAVING AND CLIMBING LANES
 GLENDALE TO SUNNY VALLEY
 JOSEPHINE AND DOUGLAS COUNTIES

ODOT REGION 3 WHITE CITY
 100 ANTELOPE ROAD
 WHITE CITY, OREGON 97503

SEPTEMBER 28, 2010
 SCALE: 1" = 100'
 SHEET 16 OF 33

THIS IS TO CERTIFY THAT THIS MAP WAS PREPARED USING HP DESIGNJET 1055CM, BLACK C4820a INK ON HP MATTE FILM #51642B.

Josephine CO.

ST. HWY. I 5 -024 P